


02-02-024-B

02-02-024-116-053
068
069
50

#12503

W. 20 TH. ST.

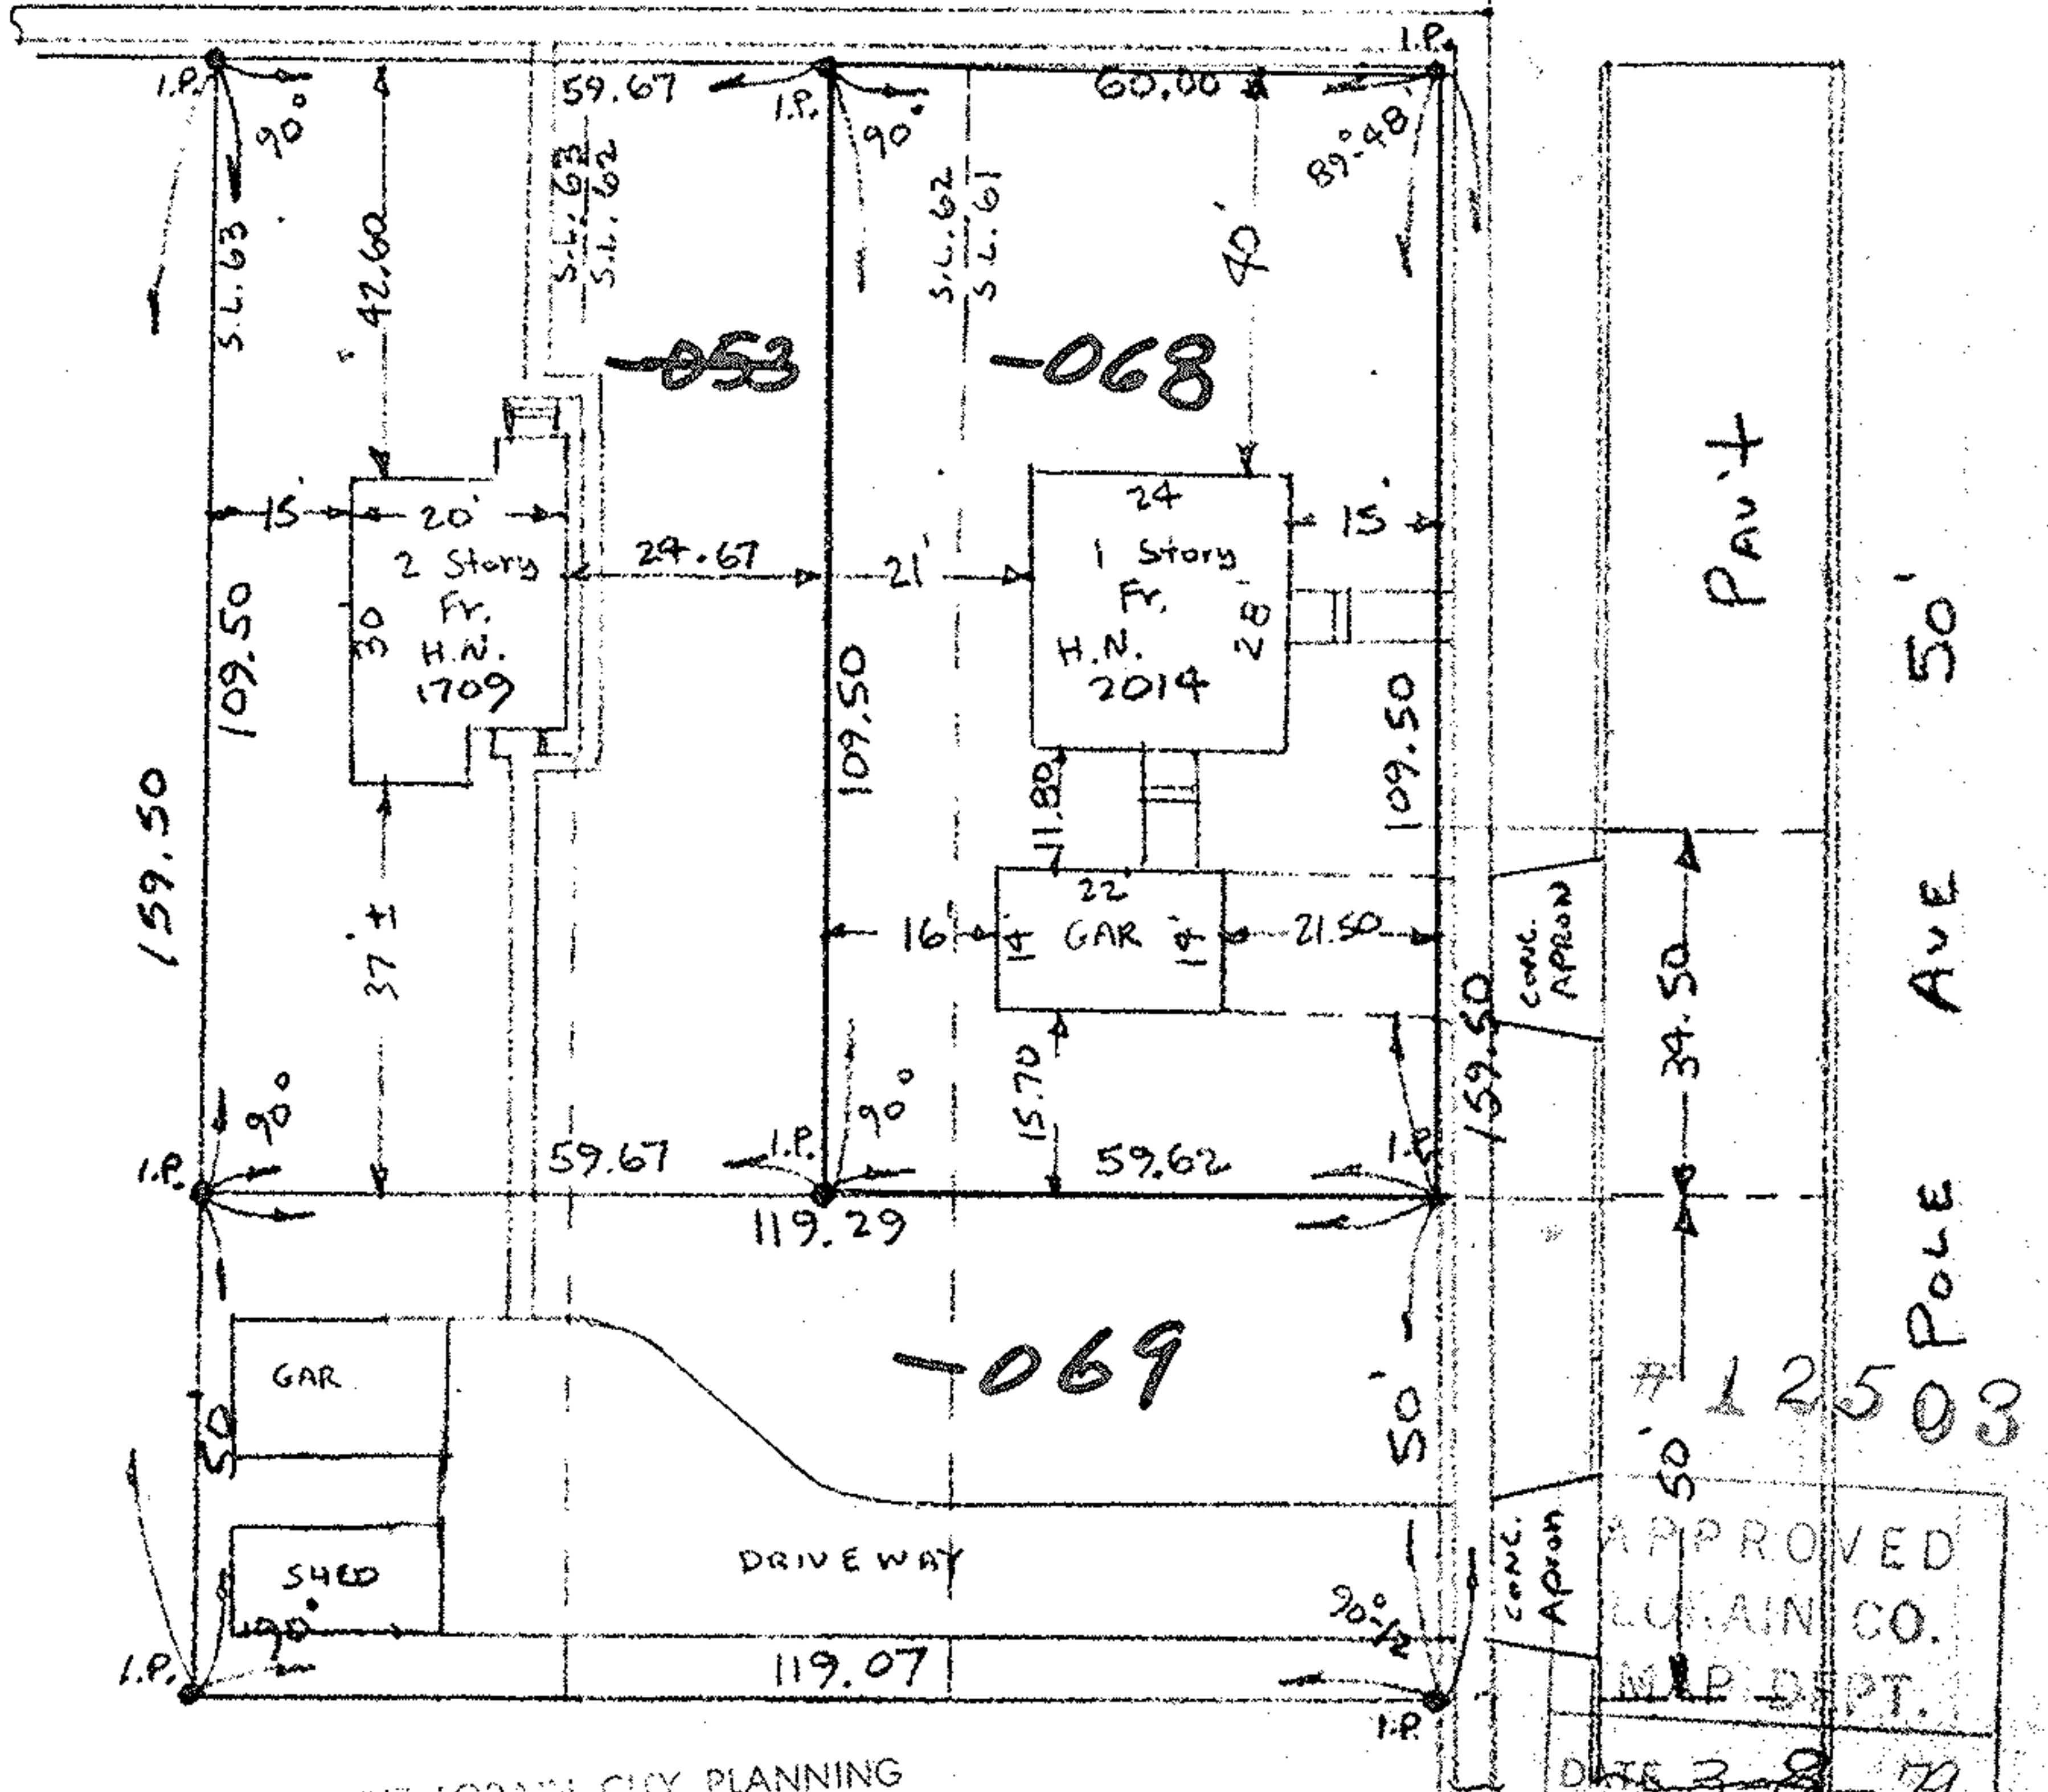

APPROVED BY THE LORAIN CITY PLANNING COMMISSION... NO PLAT REQUIRED

Jerry Rodgers
SECRETARY LORAIN CITY PLANNING COMMISSION

APPROVED
LORAIN CO.
MLP DEPT.
DATE 3-8-79
PAGE 2-02-024-B
BY <i>Carolyn J</i>
VOID AFTER 12503

map of survey of parts of sublots 61, 62, and 63, in Pole and Reeves City Acres Addition of a part of Original Block River Township Lot No. 24, Tract 2, now in the City of Lorain, Lorain County Ohio

scale 1" = 30'

march 5, 1979

Charles F. Jacobs - Registered Surveyor #47



9-470-70-70