


Shadove N. Mason
Certified by 5-9-67
Ground
Solid Line

Dup Remainder .83 Ac
Cal " .59 Ac
Difference 24 Ac

25.833 ÷ 43500 = .59 Ac
25,833.00 sq ft
13352 x 165 = 22030.60 sq ft
138 x 165
15.52 x 245 = 3802.40 sq ft
16 x 245
Remainder
T.N. Molas 02-02-023-101-024
Calculation
118 x 245 = 28910 sq ft
28910 ÷ 43500 = 66 Ac
122 x 245

02-02-023-101-023

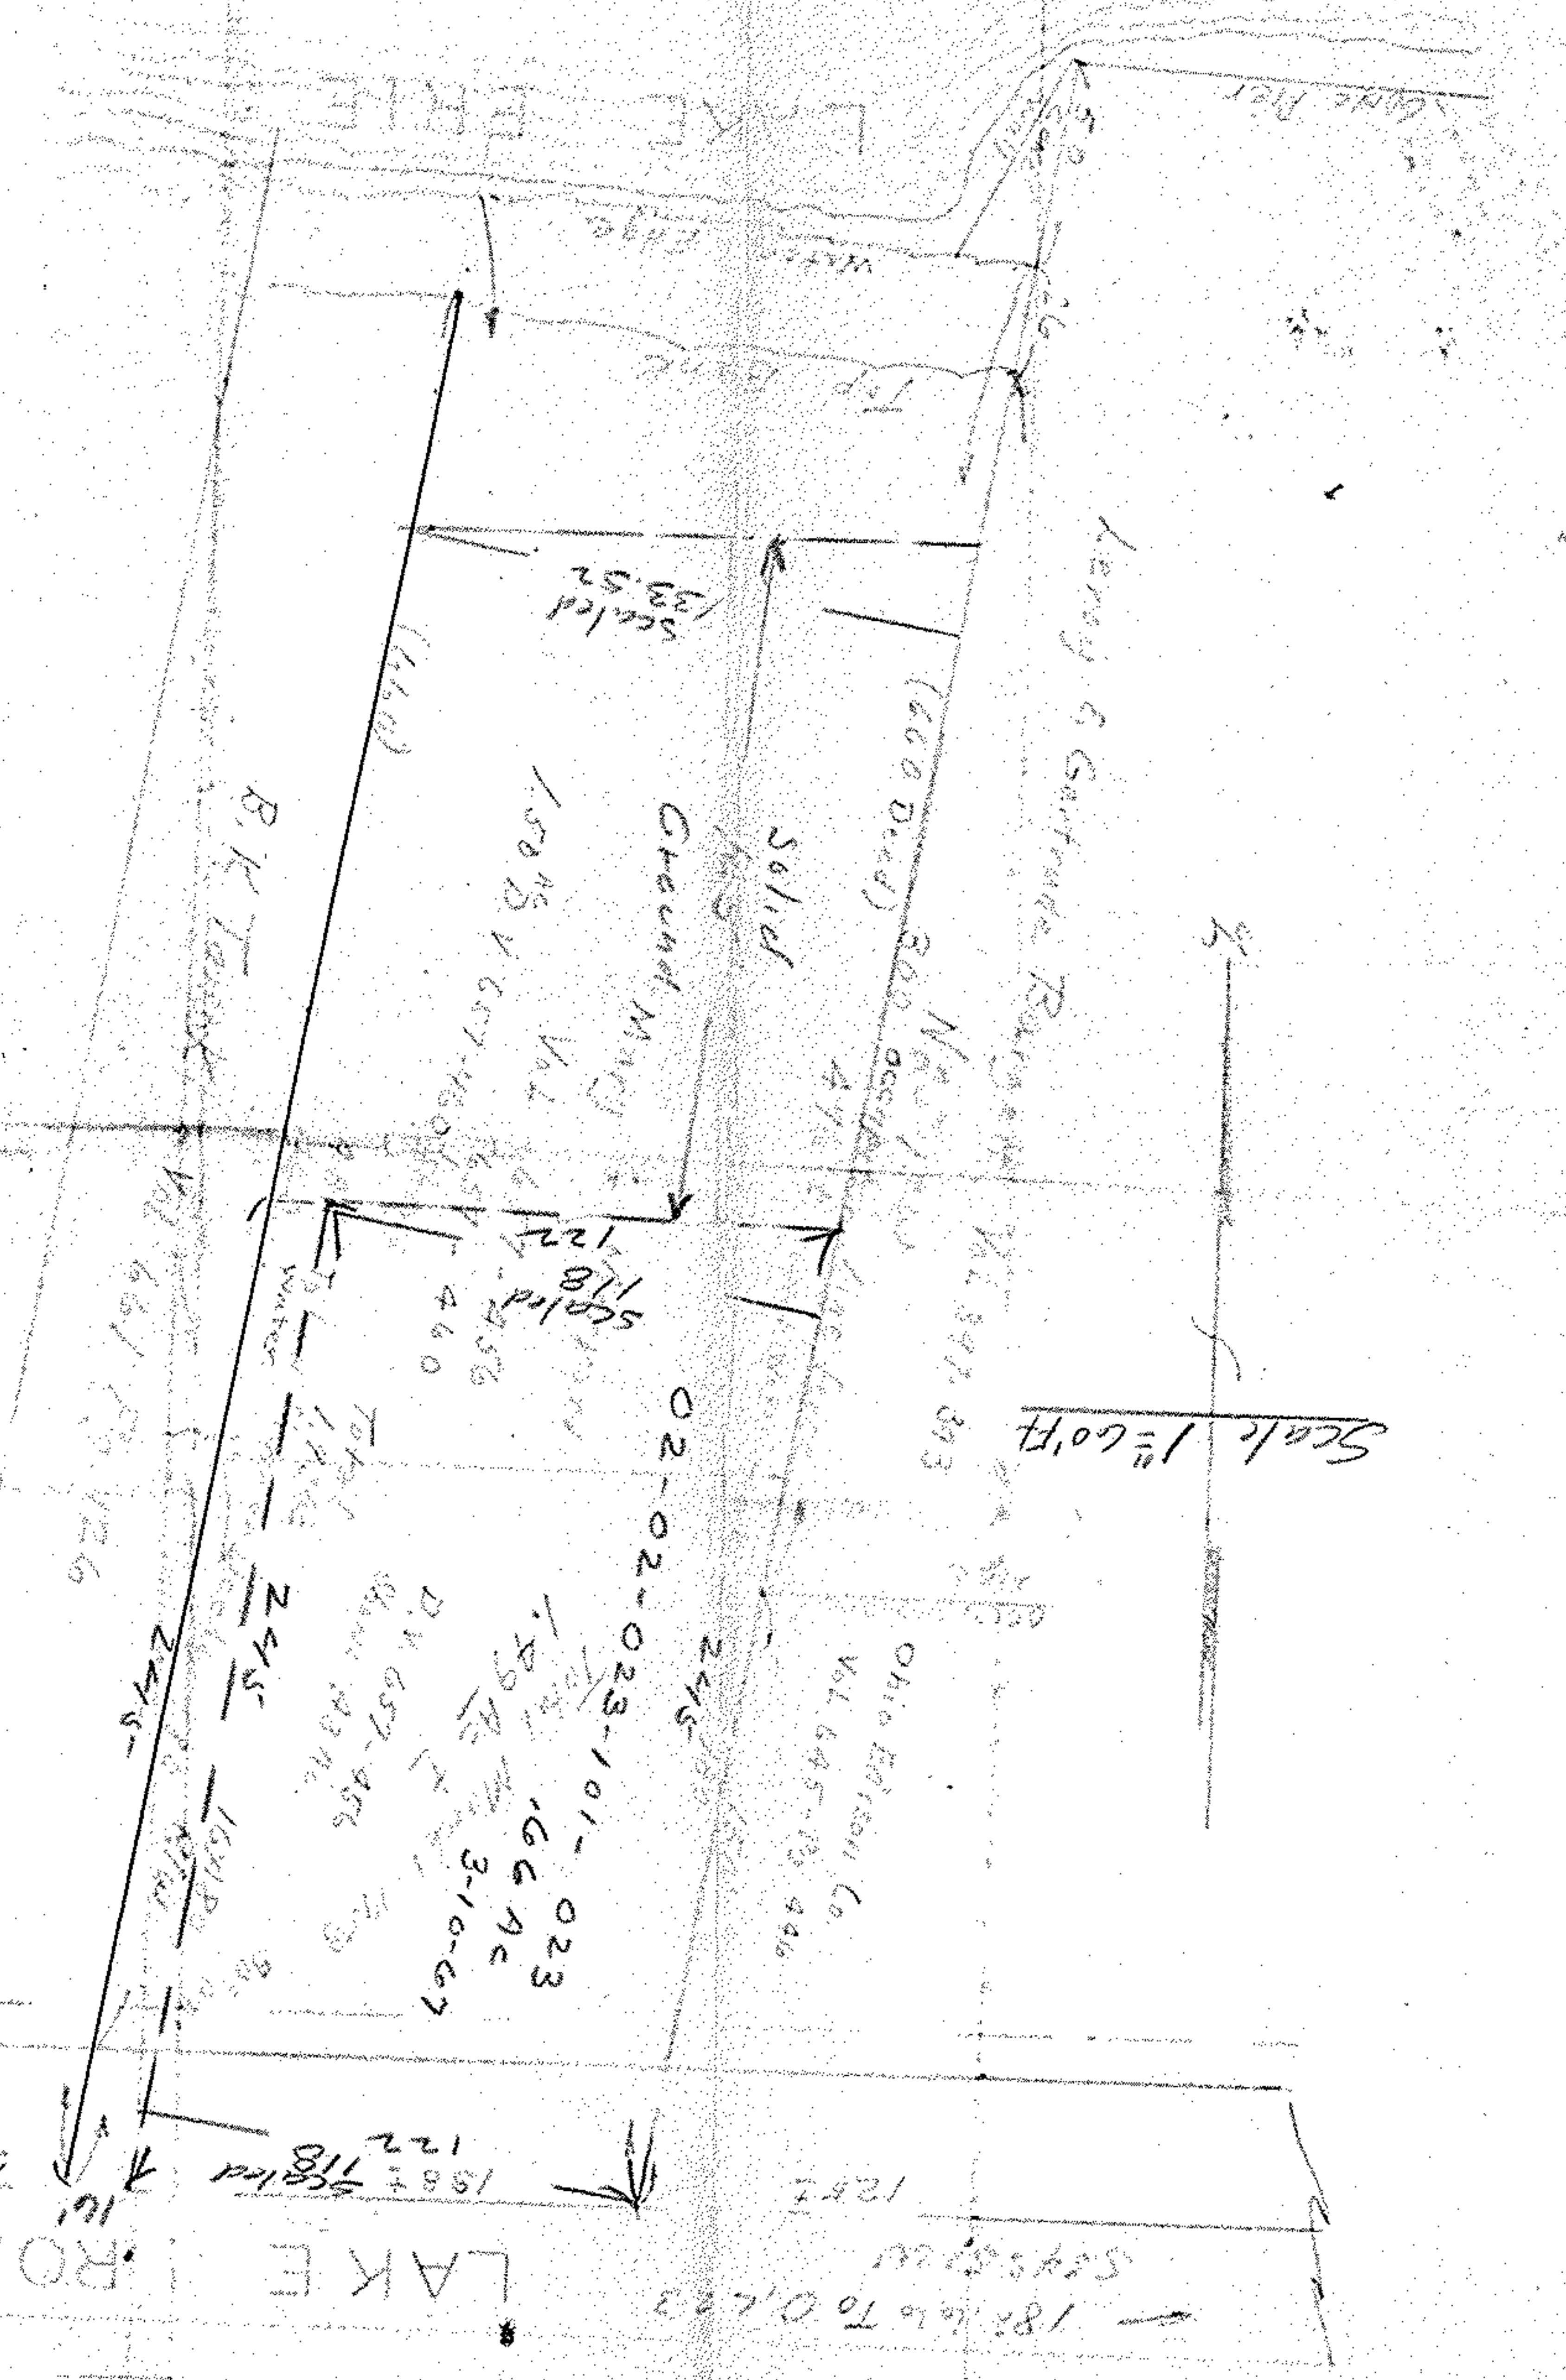

EROSION SURVEY
FOR MARY MORROW
PART OF 23 TRACT 2
BLACK RIVER TWP #
LERRAIN CO. OHIO
MARCH 1-1958
SURVEY IS APPROXIMATE TO
OCCUPATION LINES
BY A.F. KOEPP REG. SURVEYOR
02-02-023-101-007
02-02-023-A


2-02-023-A BLACK RIVER TR #2 OK 23

138
- 122
16

Shadove N. Mason
Line Certified by

Dup Remainder .83 Ac
Cal " .59 Ac
Difference 24 Ac

25.833 ÷ 43500 = .59 Ac
25,833.00 sq ft
13352 x 165 = 22030.60 sq ft
138 x 165
15.52 x 245 = 3802.40 sq ft
16 x 245
Remainder
T.N. Molas 02-02-023-101-024
Calculation
118 x 245 = 28910 sq ft
28910 ÷ 43500 = 66 Ac
122 x 245

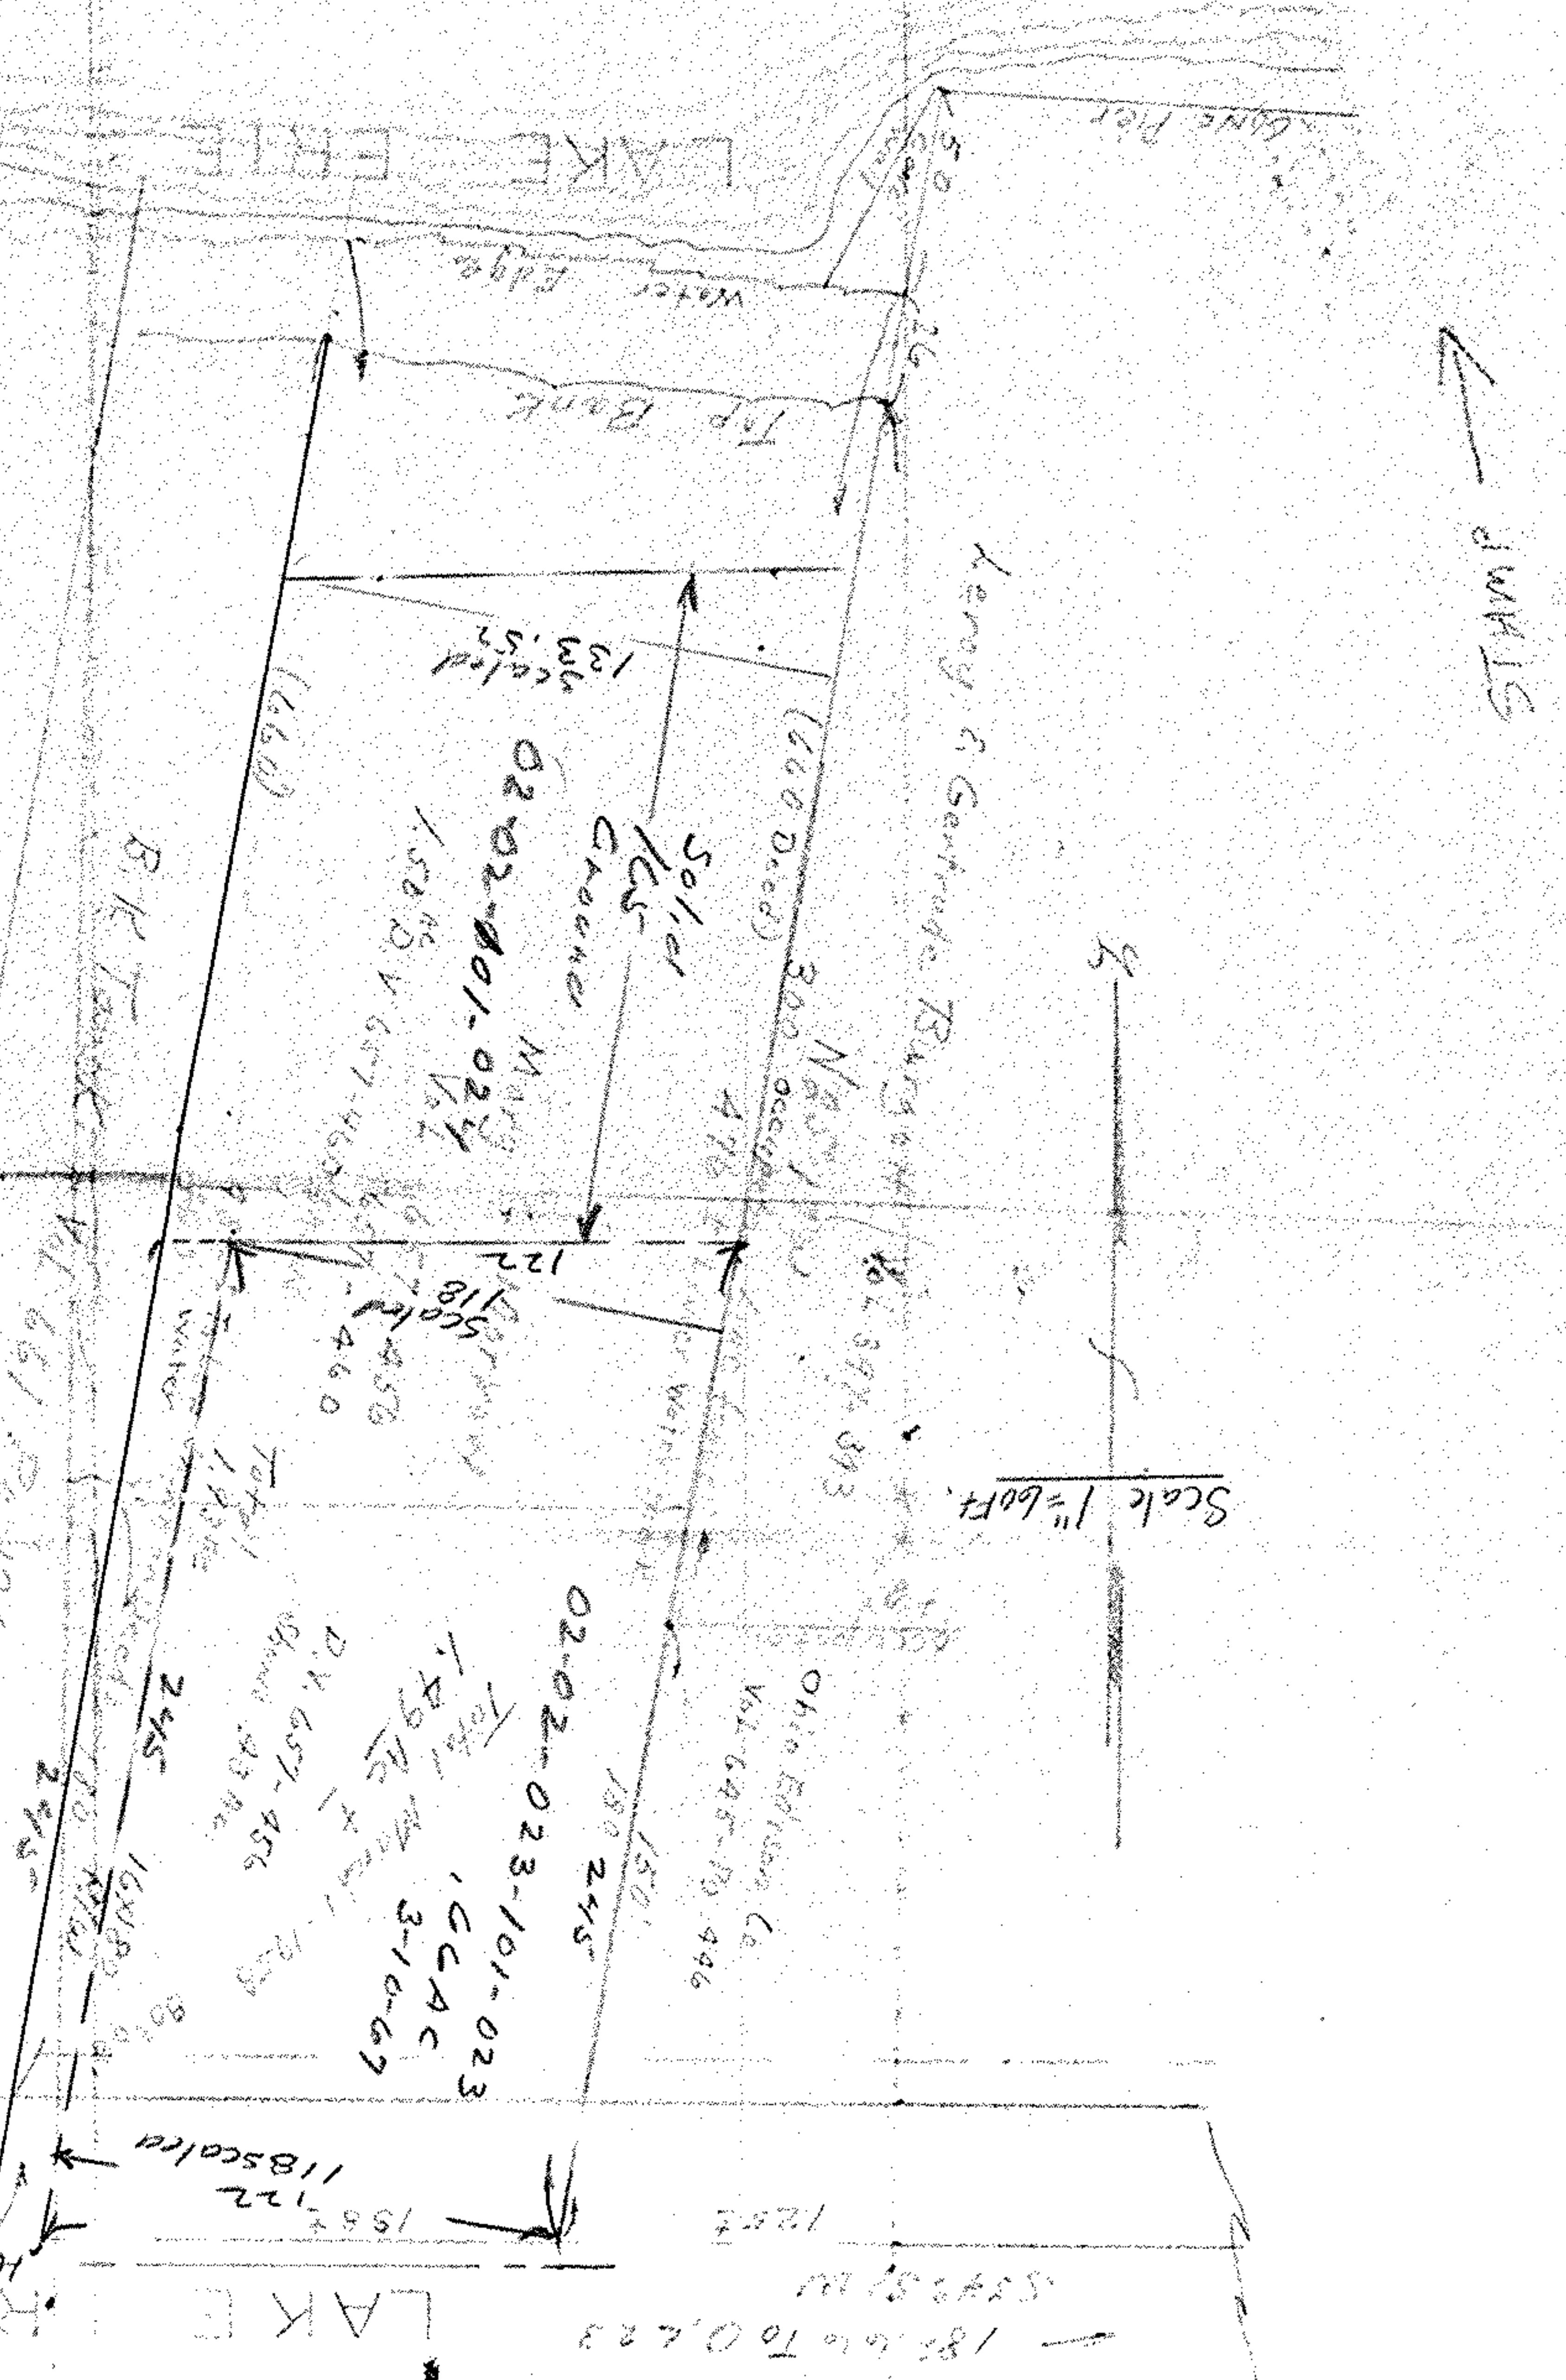

EROSION SURVEY
FOR MARY MORROW
PART OF 23 TRACT 2
BLACK RIVER TWP #
LERRAIN CO. OHIO
MARCH 1-1958
SURVEY IS APPROXIMATE TO
OCCUPATION LINES
BY A.F. KOEPP REG. SURVEYOR

2-02-023-A BLACK RIVER TR #2 OK 23

138
- 122
16

40/5224
Before Widening