


M

(216) 327-4776

MARTINI-HAPONEK & ASSOCIATES, INC.


Engineers & Surveyors
35590 Center Ridge
NORTH RIDGEVILLE, OHIO 44039

ASHLAND AVE

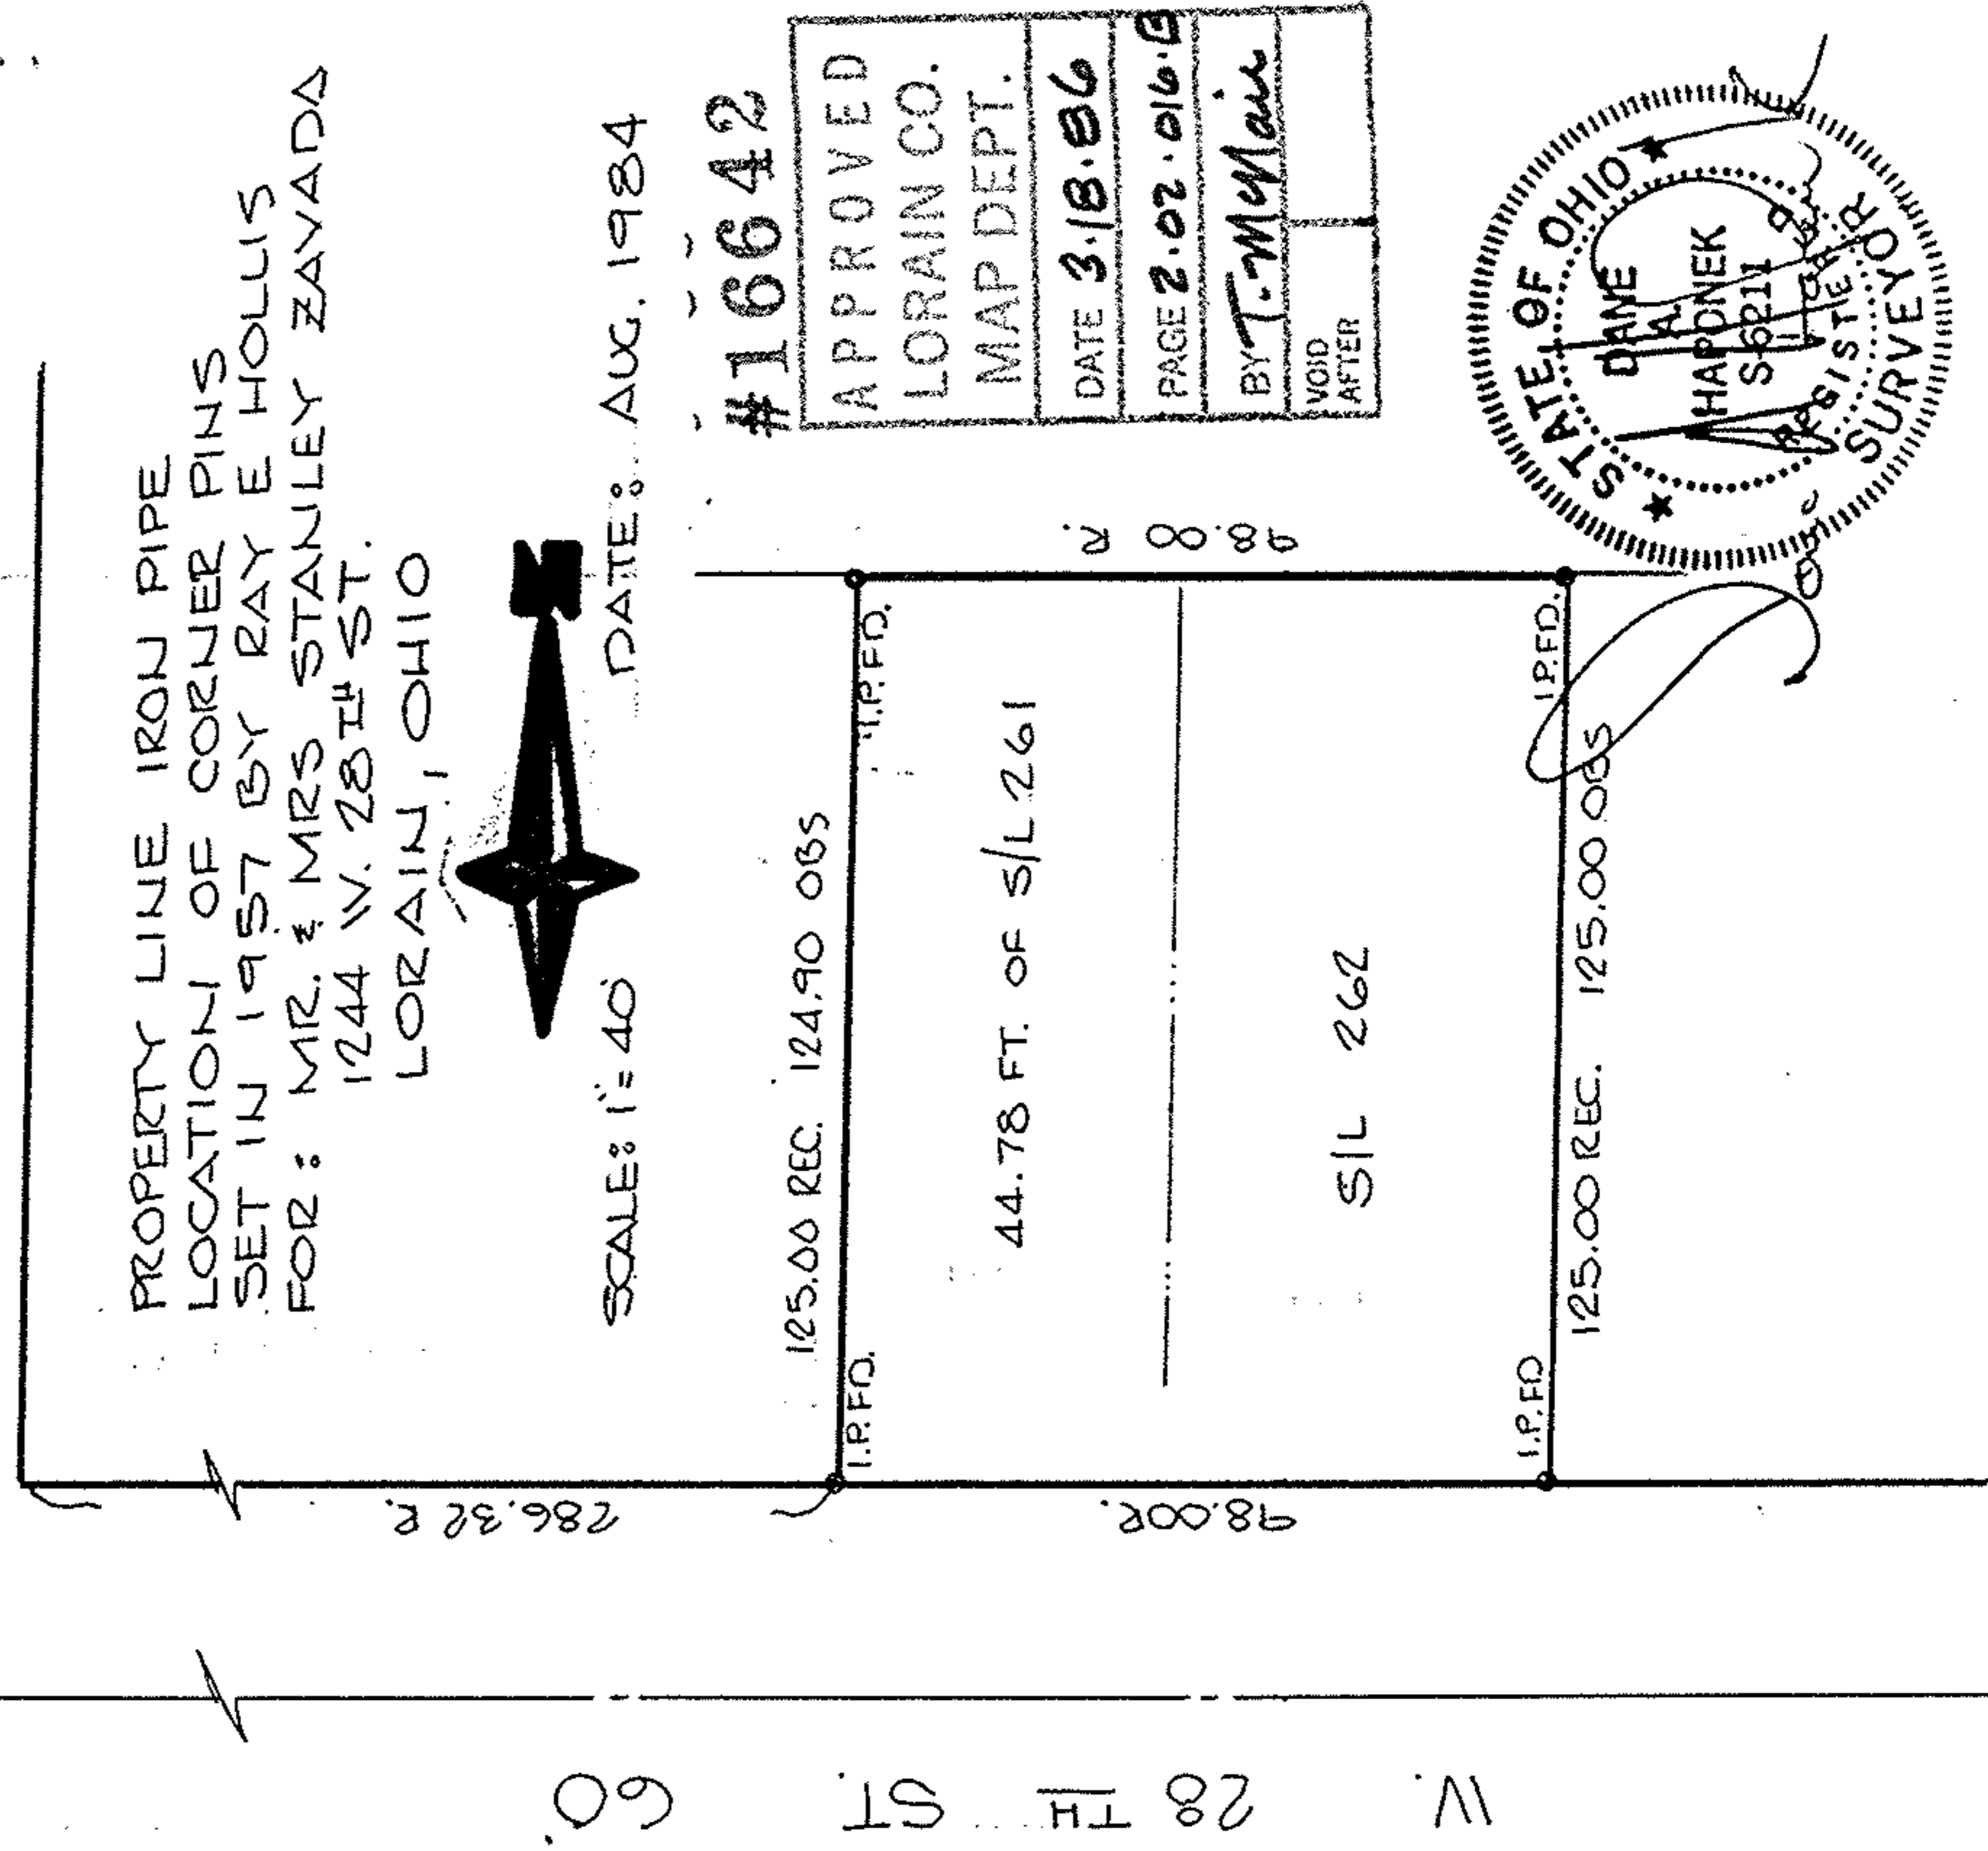

#16642

APPROVED
LORAIN CO.
MAP DEPT.
DATE 3.18.86
PAGE 2.02.016.8
BY T. McMain
VOID AFTER

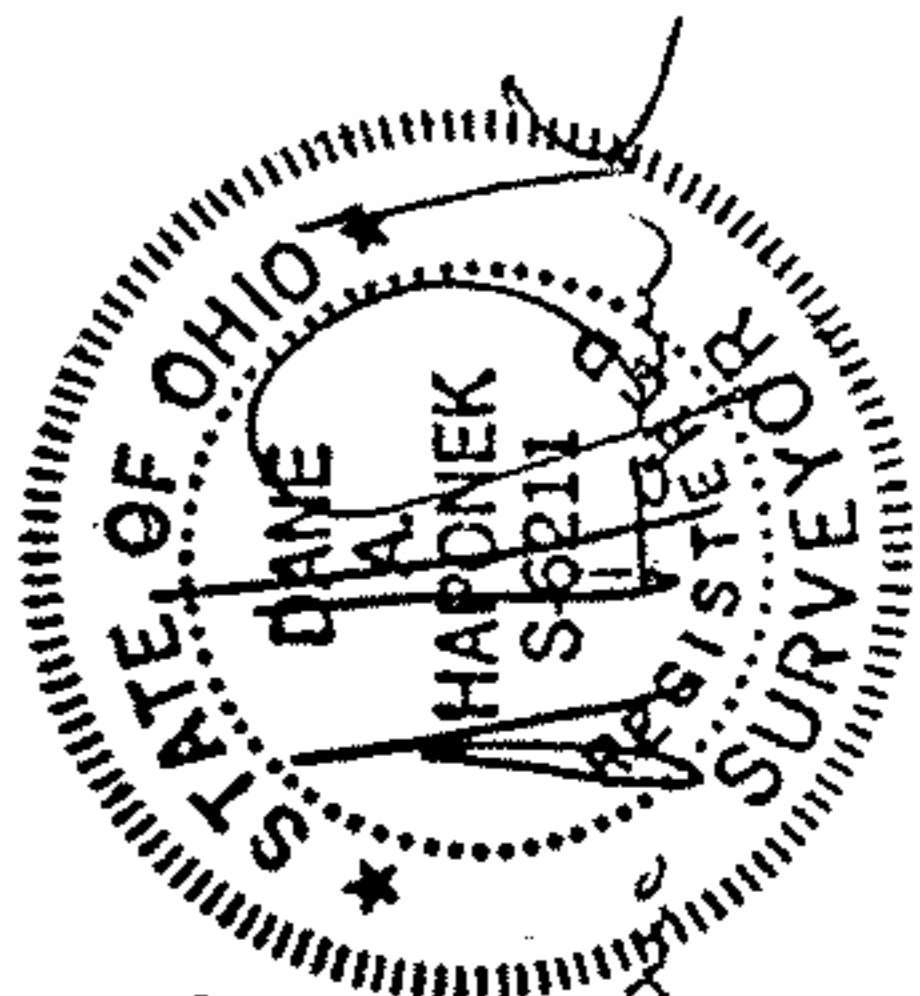

9-910-70-7