


#21777

OR-OR-010-103-020

027

APPROVED
LORAIN CO.
MAP DEPT.
DATE 5-30-96
PAGE 2-02-0161B
BY T. McMain
21777

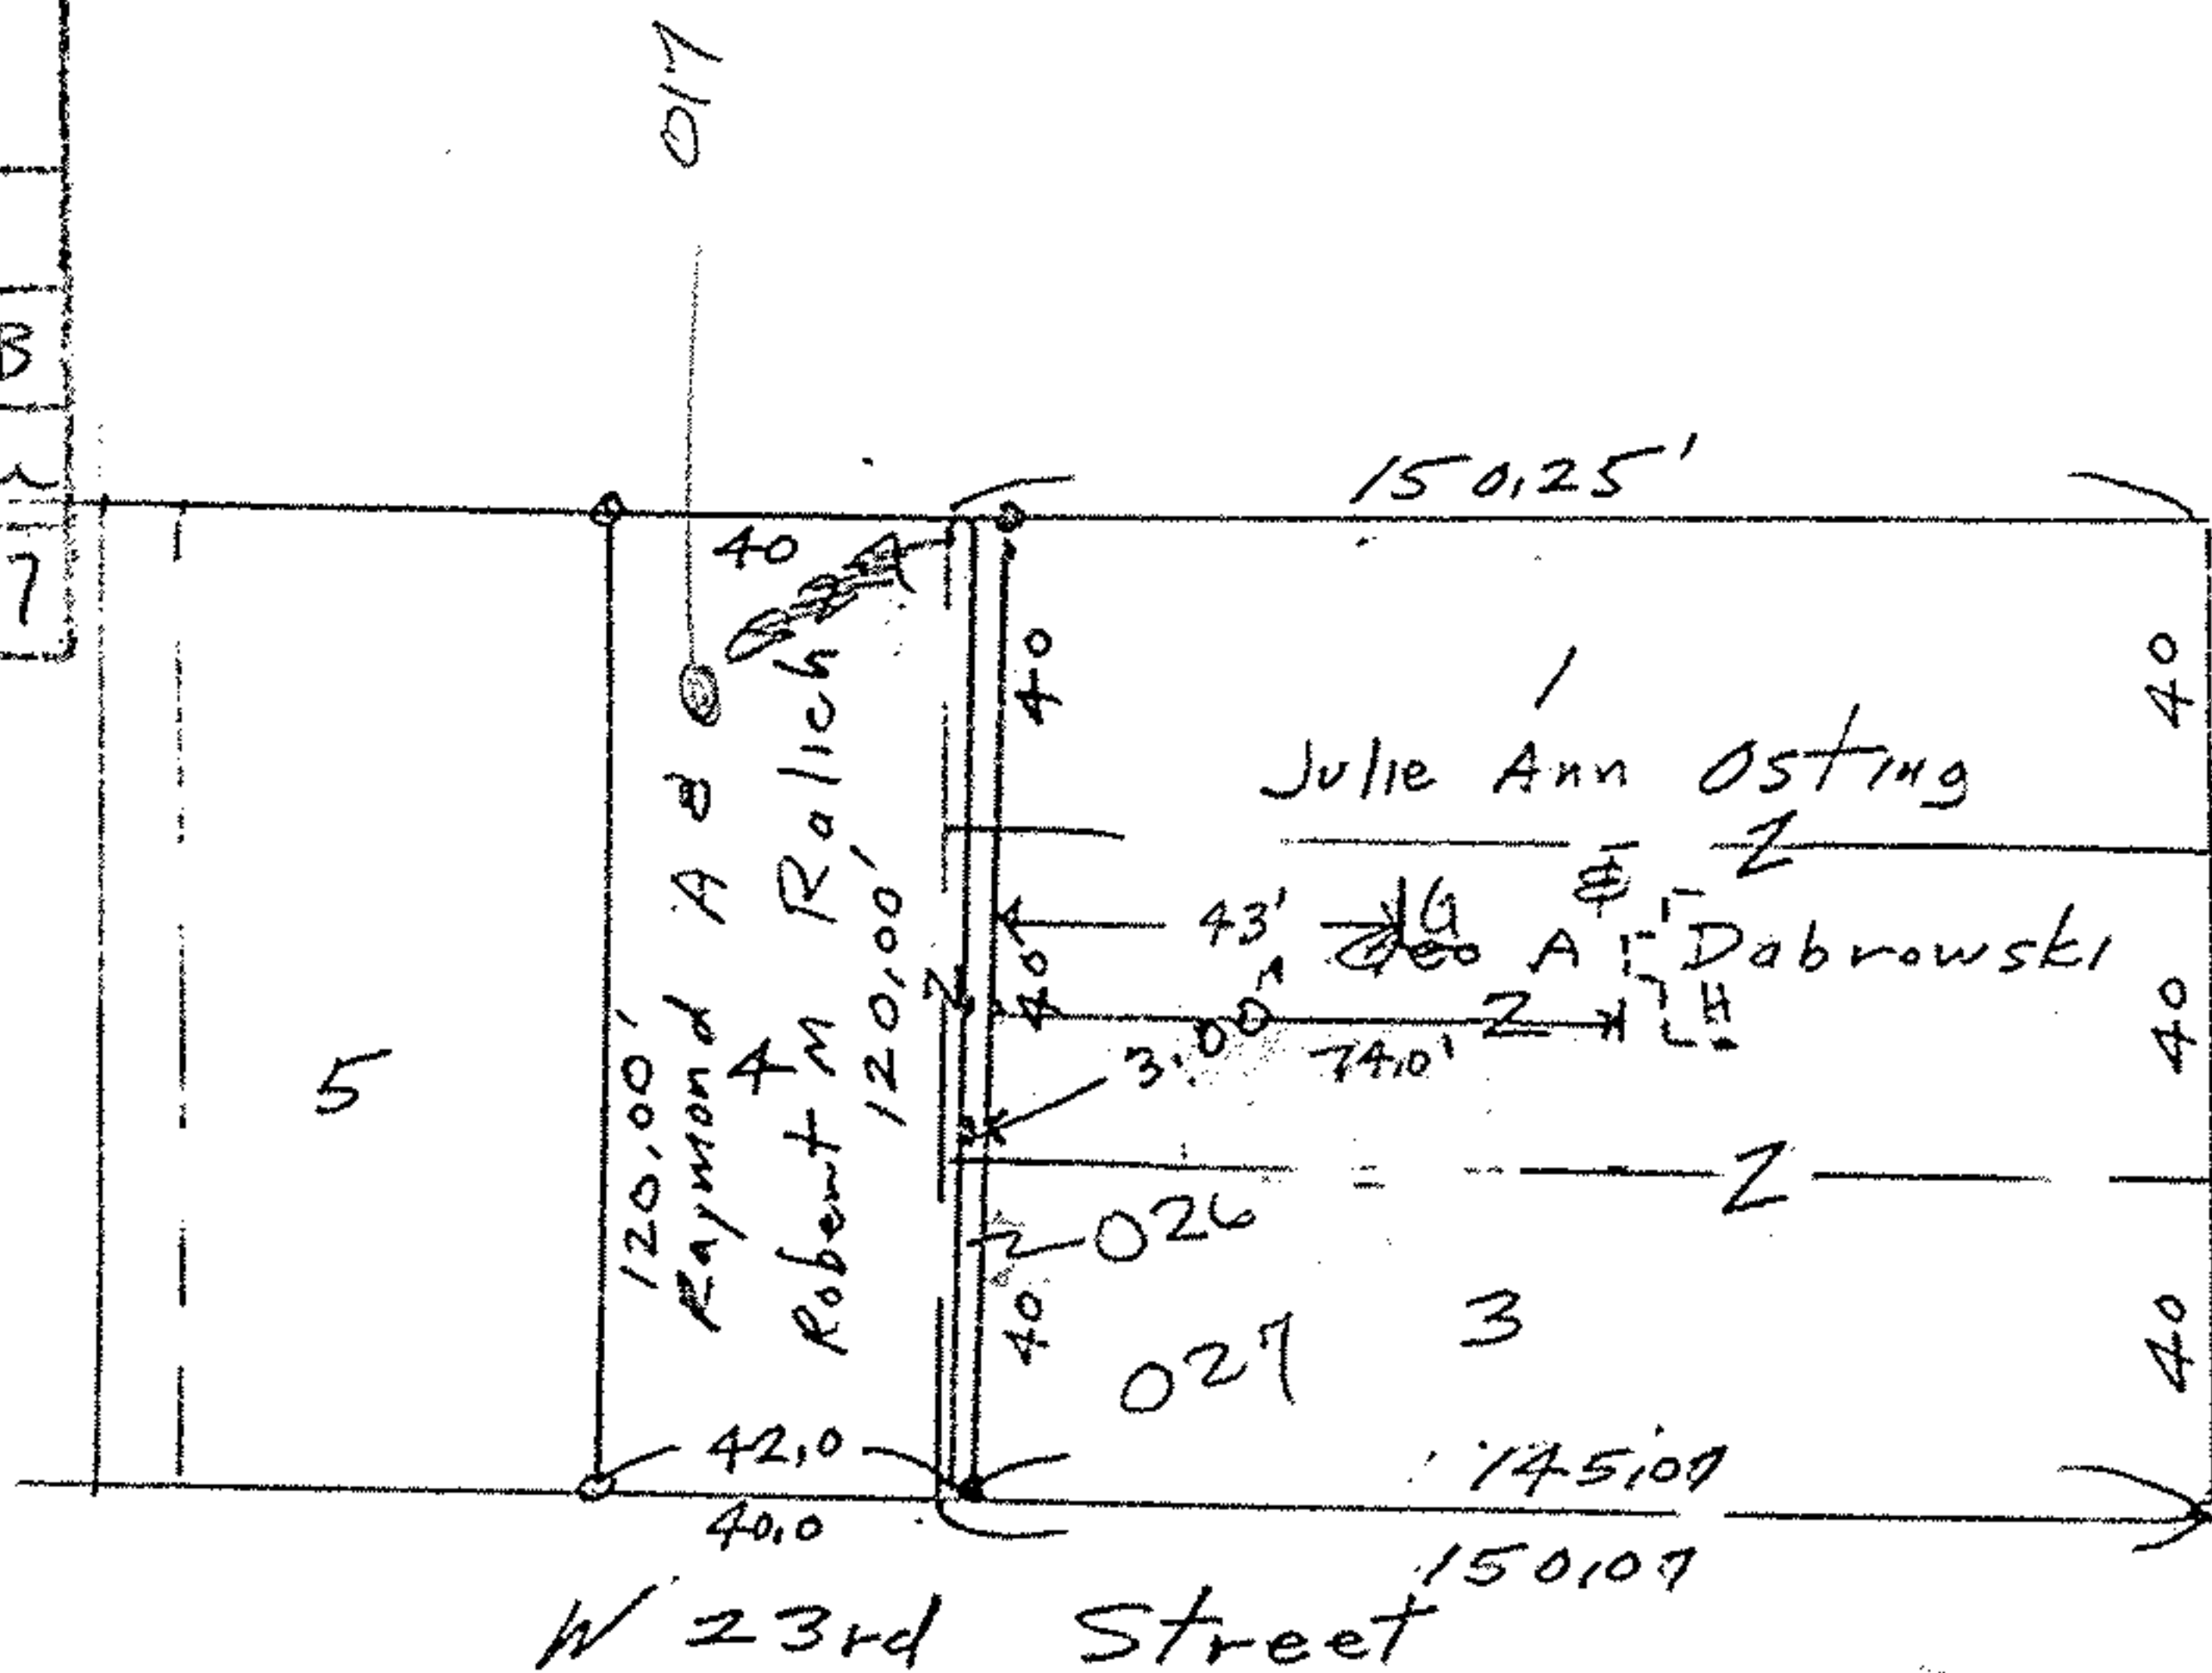

Oberlin Ave



APPROVED BY THE LORAIN CITY PLANNING
COMMISSION..... NO PLAT REQUIRED
William E. Wade 5-8-96
SECRETARY LORAIN CITY PLANNING COMMISSION

APPROVED

AS TO DESCRIPTION ONLY

Date 5/8/96

Per Kim Hosken
City of Lorain
Engineering Dept.

Garage and House Location

Apr 21, 1996

Survey for Agnes Ralich
3100 ft of sublots 1, 2 & 3
Oberlin Ave Realty Co's Add'n
Plat Volume 8 Pg 32
original Black River Twp
Lot 16 Tract 16
City of Lorain
Lorain County Ohio
Scale 1"=50' June 10, 1995

- 1 iron pipes fd
- 1 iron pins set

John Poznywak
Reg Surveyor
5292

