


02-02-010-000

#16497

2-02-010A

WILLIAM B. BARTON
 Reg. Land Surveyor No. 1135
 188 PARKWOOD AVENUE
 AVON LAKE, OHIO 44012
 TELEPHONE (216) 933-6662

Jaeger Road 50'

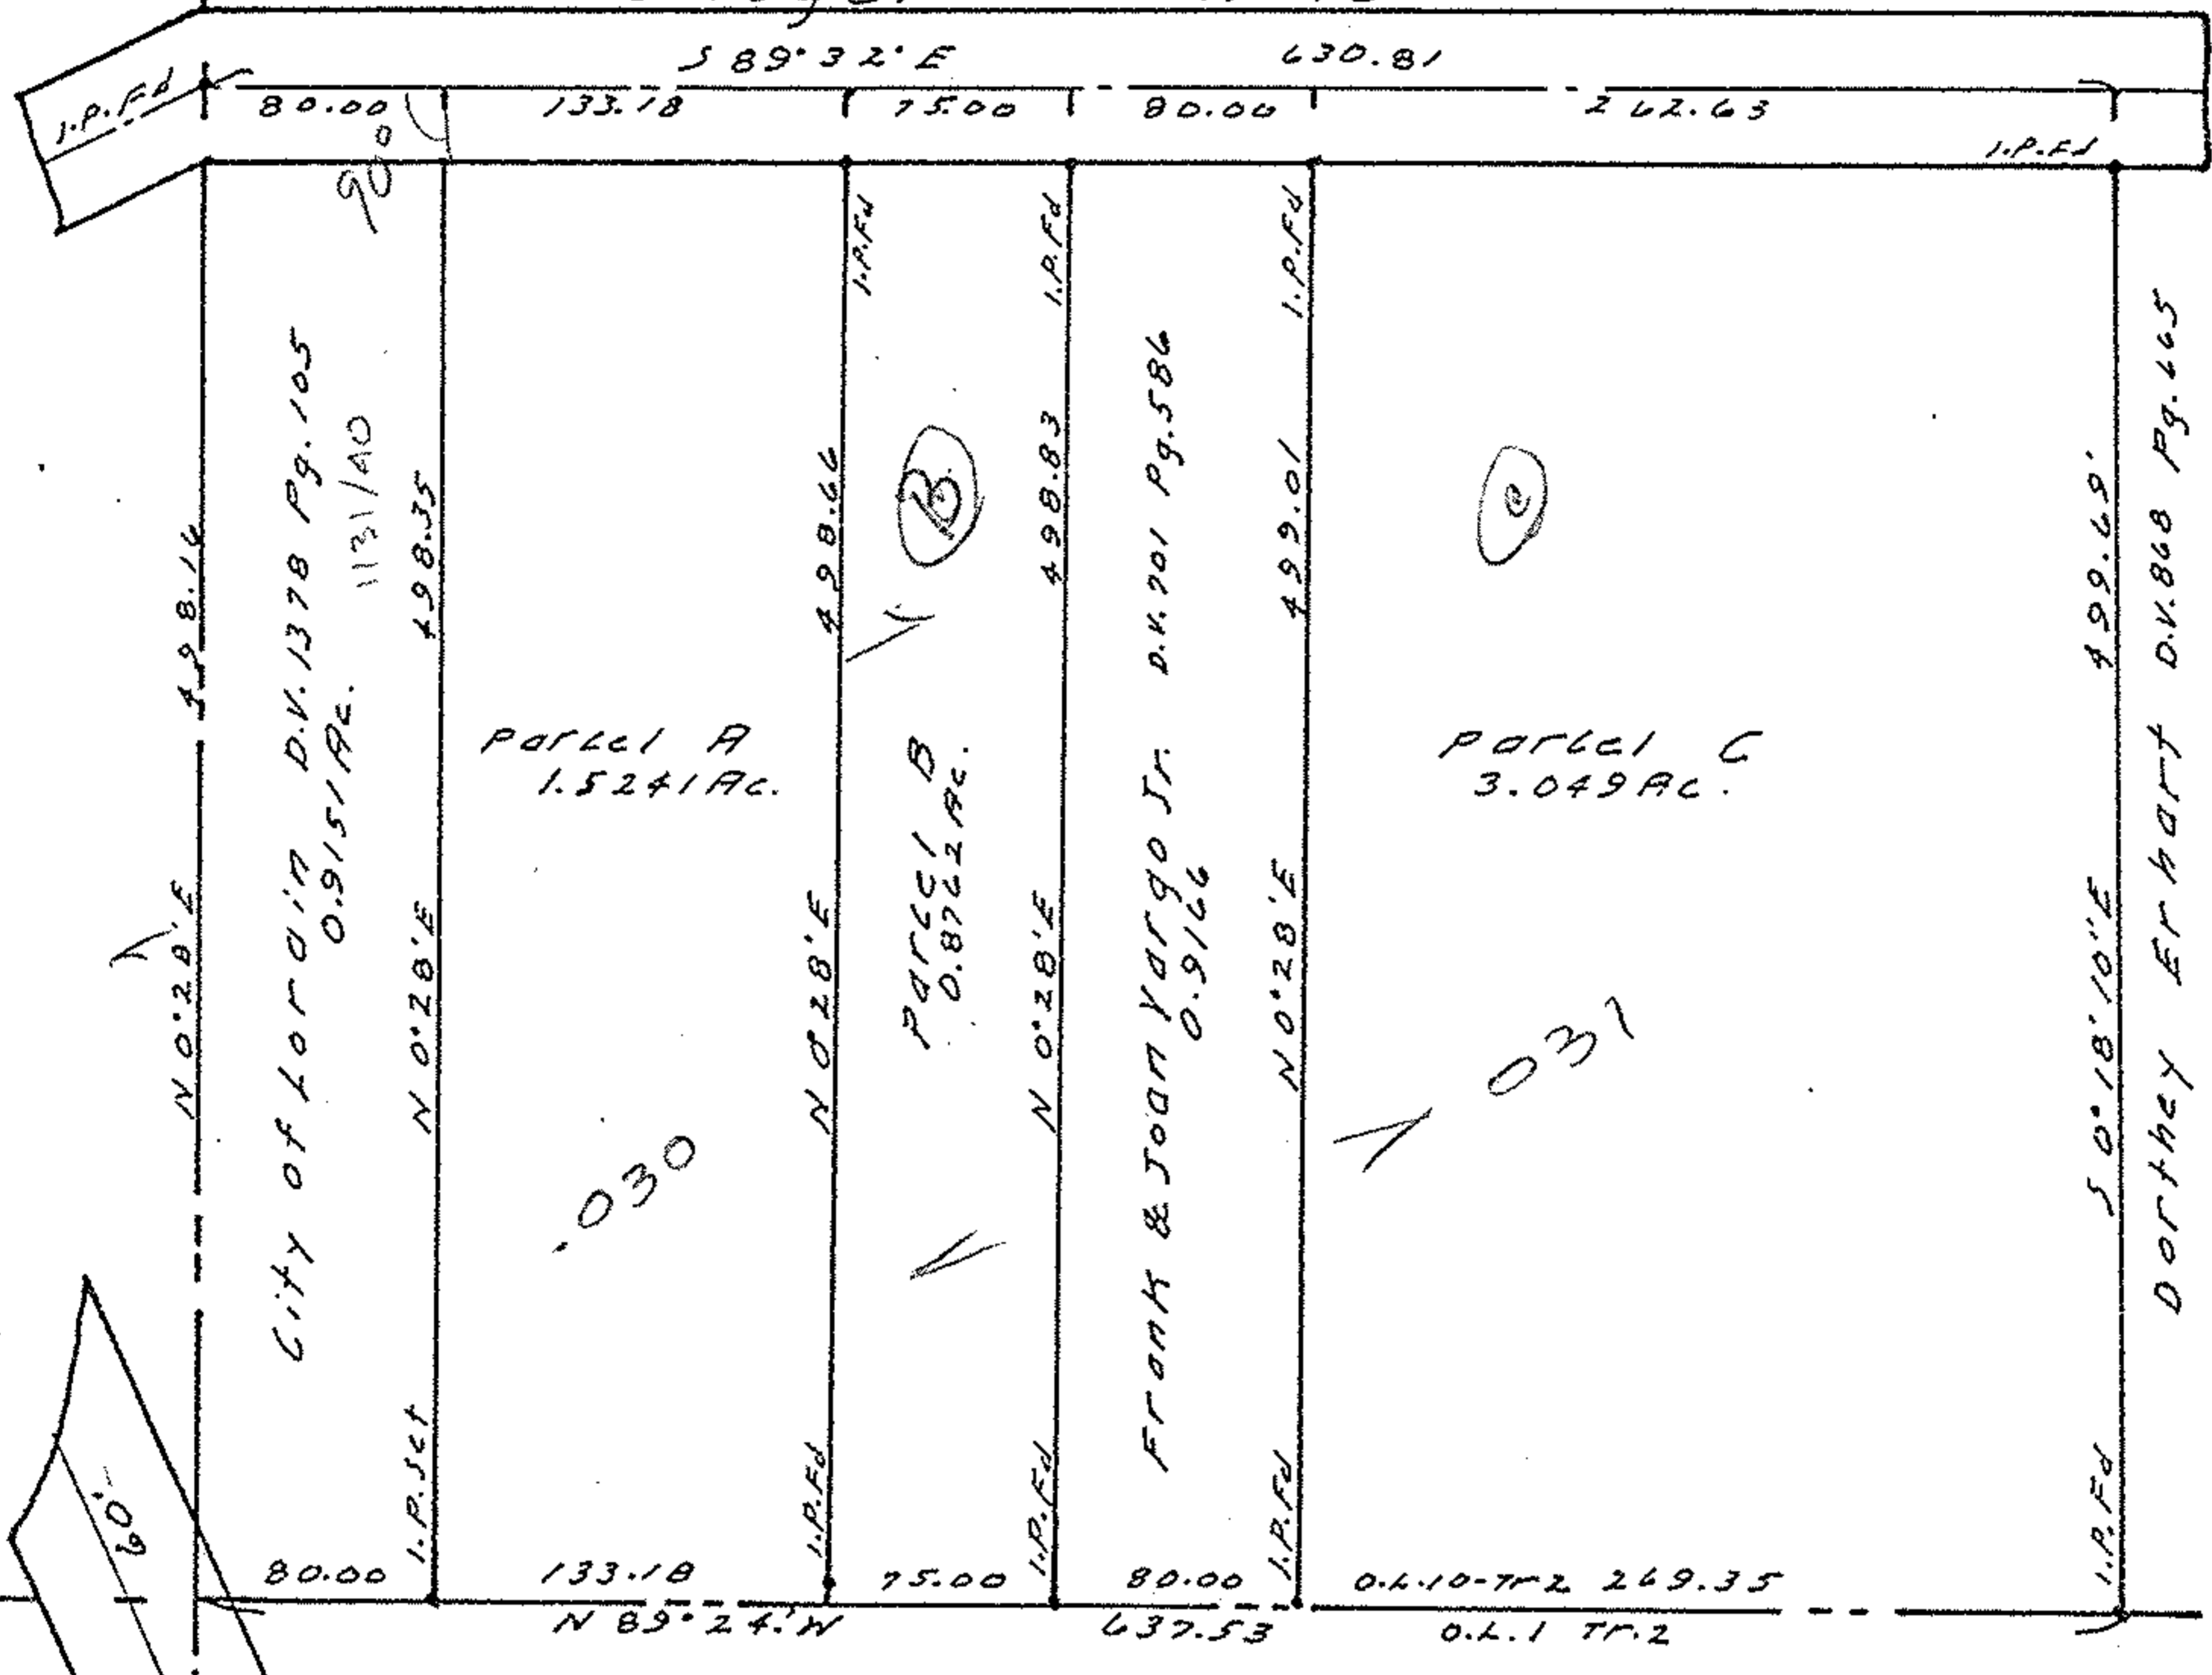

Parcel A
1.5241 AC.

Parcel B
0.8722 AC.

Parcel C
3.049 AC.

City of Lorain D.V. 1378 Pg. 105
0.9151 AC. 11/31/40

FRANK & JOAN YARGO JR. D.V. 701 Pg. 586
0.9166

Dorthea Erhart D.V. 868 Pg. 465

Joseph Bado D.V. 1149 Pg. 560

SURVEY
of

Part of Original Lot No. 10, Tract
No. 2 of Black River Township, now
the city of Lorain, Lorain County,
Ohio. Scale 1"=100' Nov. 7, 1985

#16497

APPROVED
STATE OF OHIO
WILLIAM B. BARTON
BARTON
4438
DATE 12-1-85
REGISTERED
SURVEYOR
FRANCIS

02-02-010-000-030, 031

2-057