

WILLIAM B. BARTON
 Reg. Land Surv. No. 4438
 188 PARKWOOD AVENUE
 AVON LAKE, OHIO 44012
 TELEPHONE (216) 933-6662

#18294
~~#18095~~ VOID

APPROVED
 LORAIN CO.
 MAP DEPT.
 DATE 10-11-88
 PAGE 1-00-017-A
 BY T. McMan
 VOID AFTER 18095


01-20-027-112-

01-02-027-112-020,024

SCALE: 1" = 40'

NORTH

WEST RIVER ESTATES No. 2
 P.V. 34 P. 6

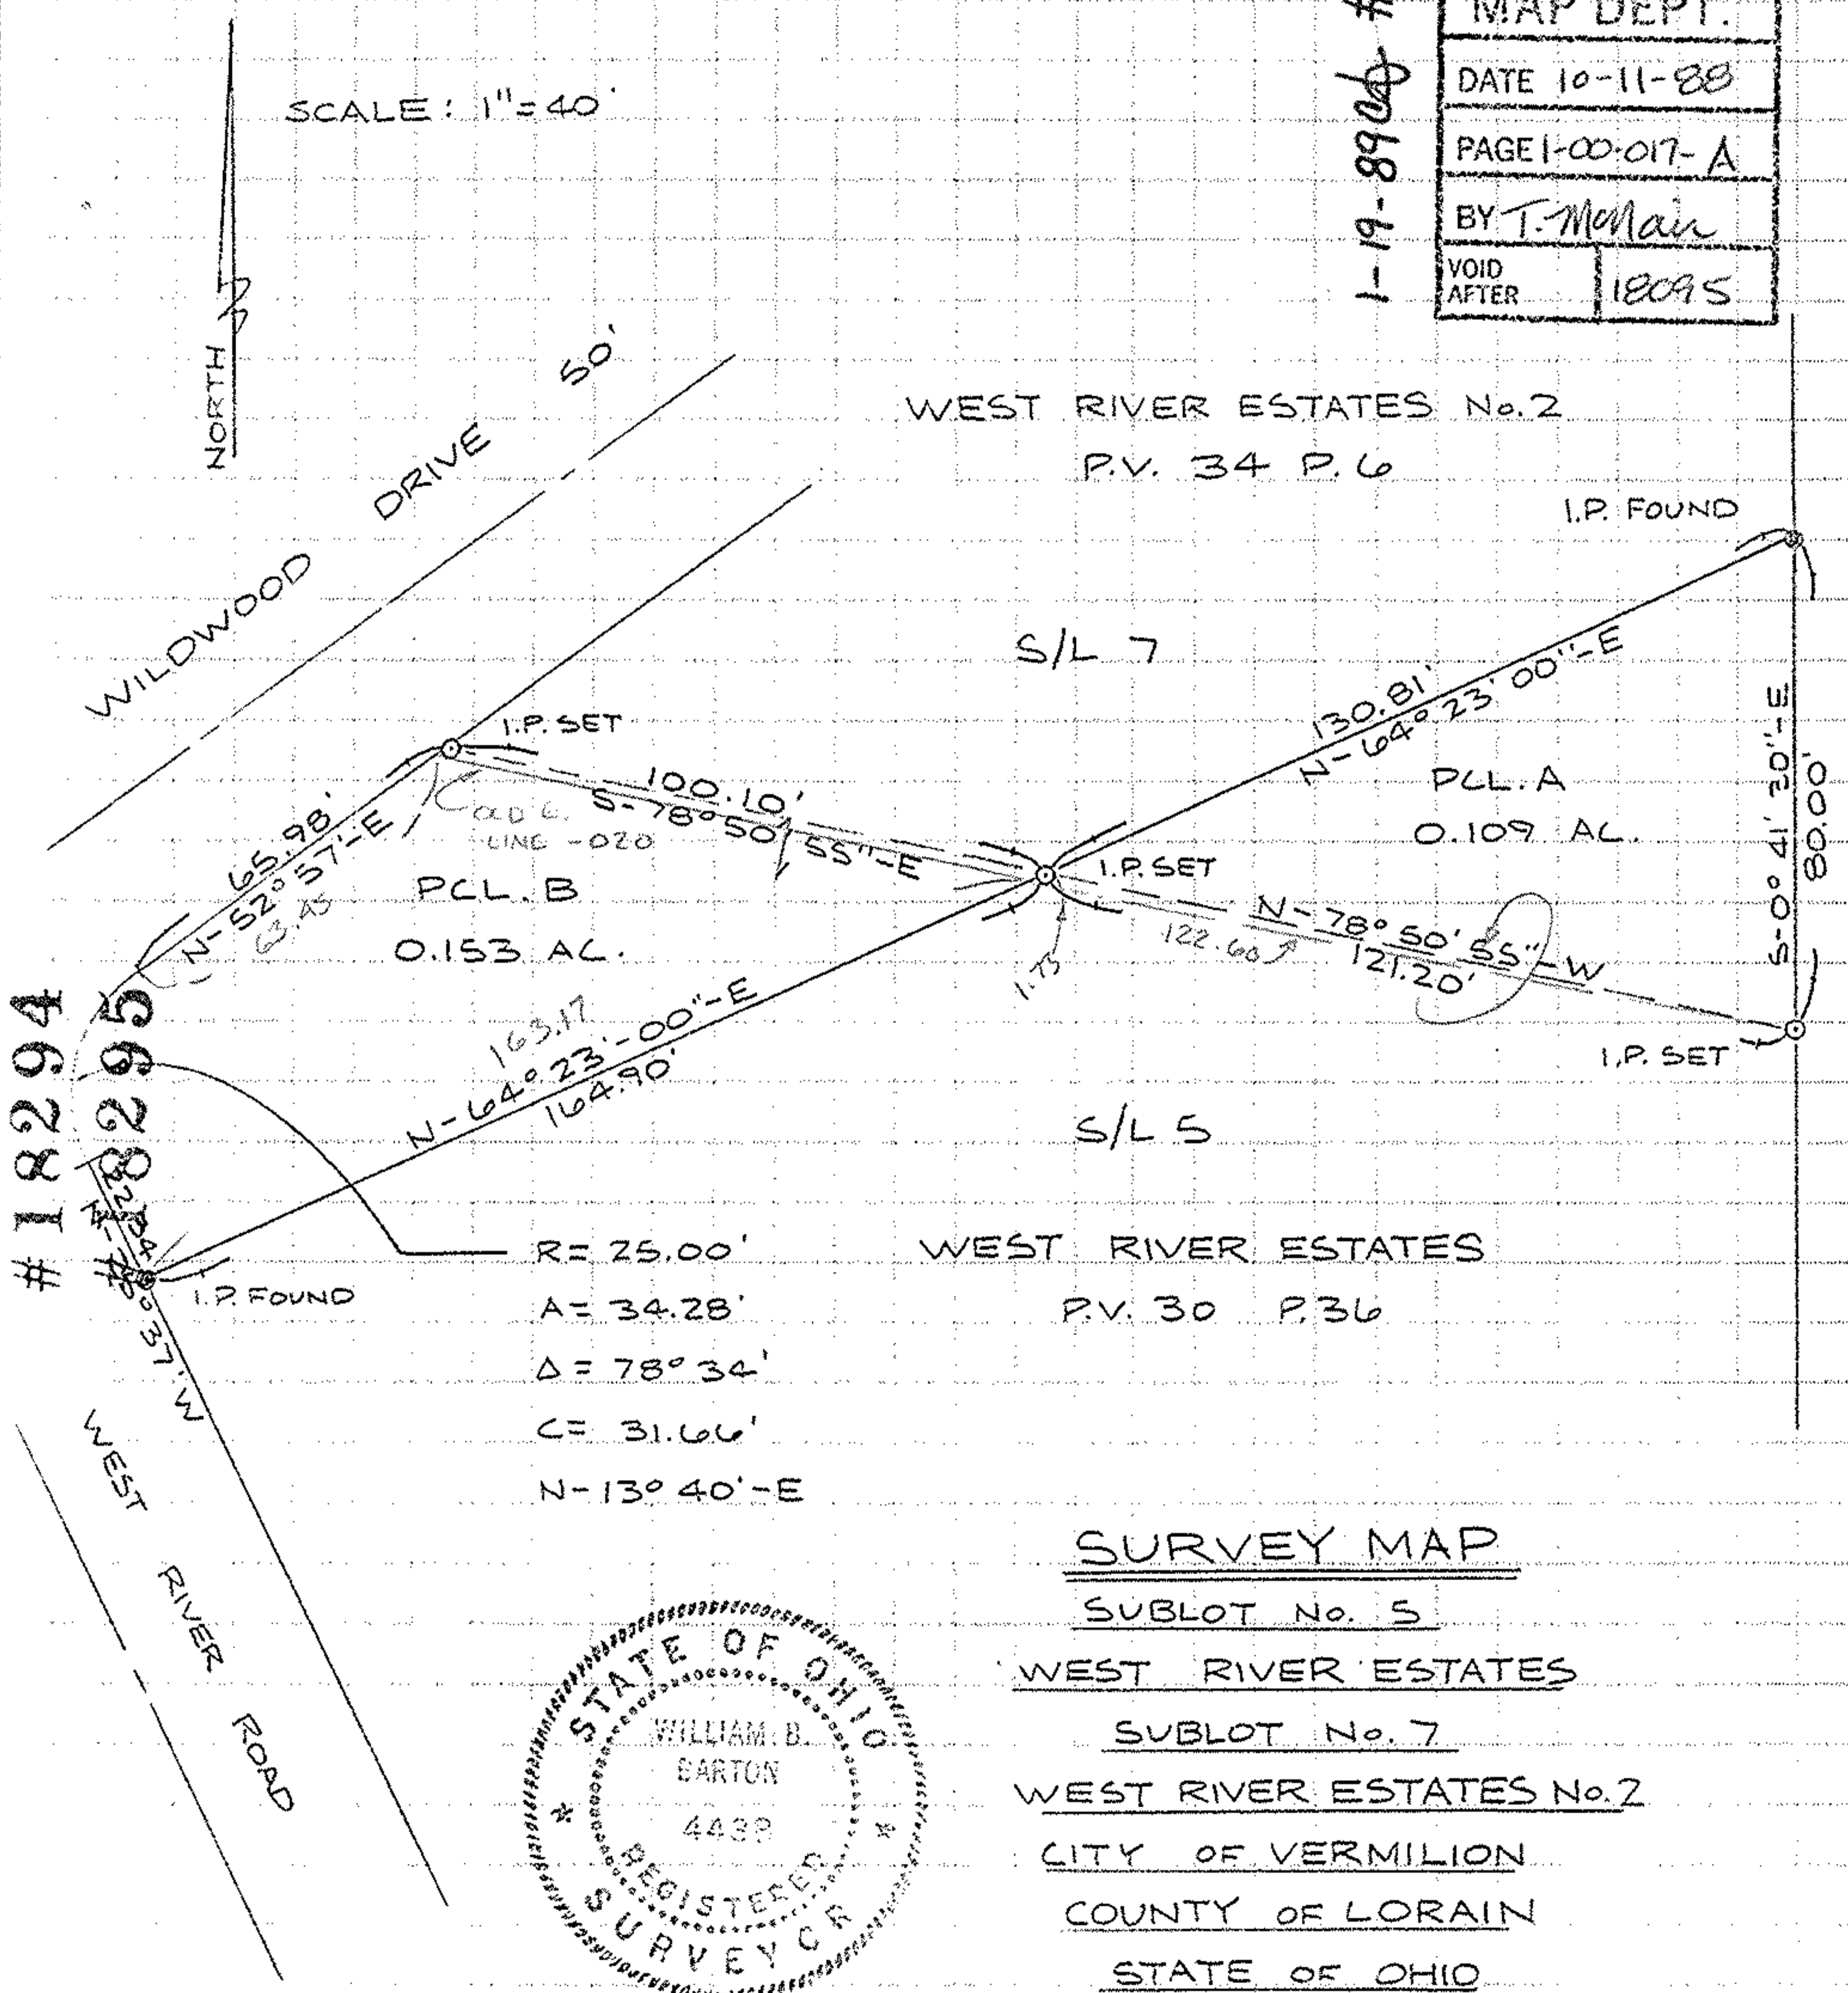


#18294
~~#18295~~

WEST RIVER ESTATES
 P.V. 30 P. 36

SURVEY MAP
SUBLOT No. 5

WEST RIVER ESTATES
SUBLOT No. 7
WEST RIVER ESTATES No. 2
CITY OF VERMILION
COUNTY OF LORAIN
STATE OF OHIO

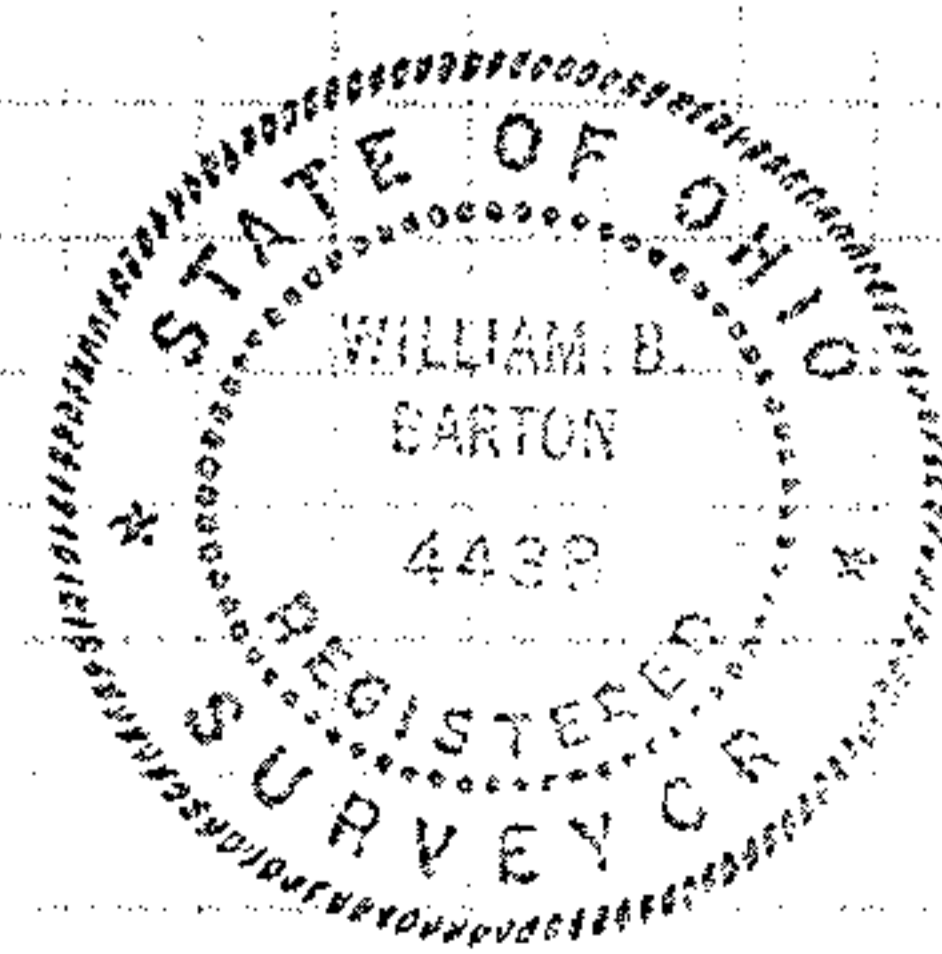

9-16-88