

PASADENA AVENUE 80 FT.


0623-176-105-004

Blainca & Rita Sprague
354

John & Ita Mahnke
353

Donald Halpin
352

Albert Haag
351

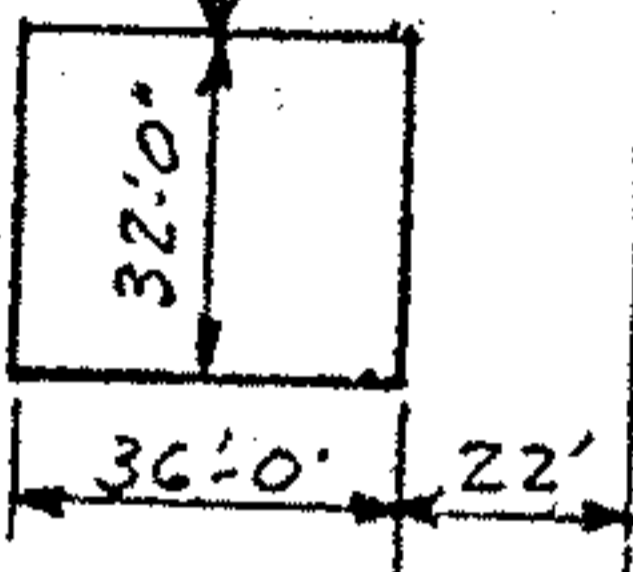

MAP OF SURVEY FOR

John & Ita Mahnke

SUB-LOT 353 SPRING VALLEY

SUB'N NO 4 Q.L. 918-176

ELYRIA TWP. EAST OF BLACK RIVER

LORAIN COUNTY OHIO

Scale 1"=50' July 22-1950

C.E. Penfound Reg. Surveyor

W.J. & Nancy D. Parsons

16

105.0'

107.63'

207.00'

295.0'

118.93'

92.45'

34.48'

80.09'

90°

80°

90°

80°

78°

80°