

00688-D

APPROVED
LORAIN CO.
MAP DEPT.

DATE 4-24-02


PAGE 6-118

BY R. MAINES

VOID
AFTER 02-00688-D

2nd Street '66'


215100 R-
DUE WEST

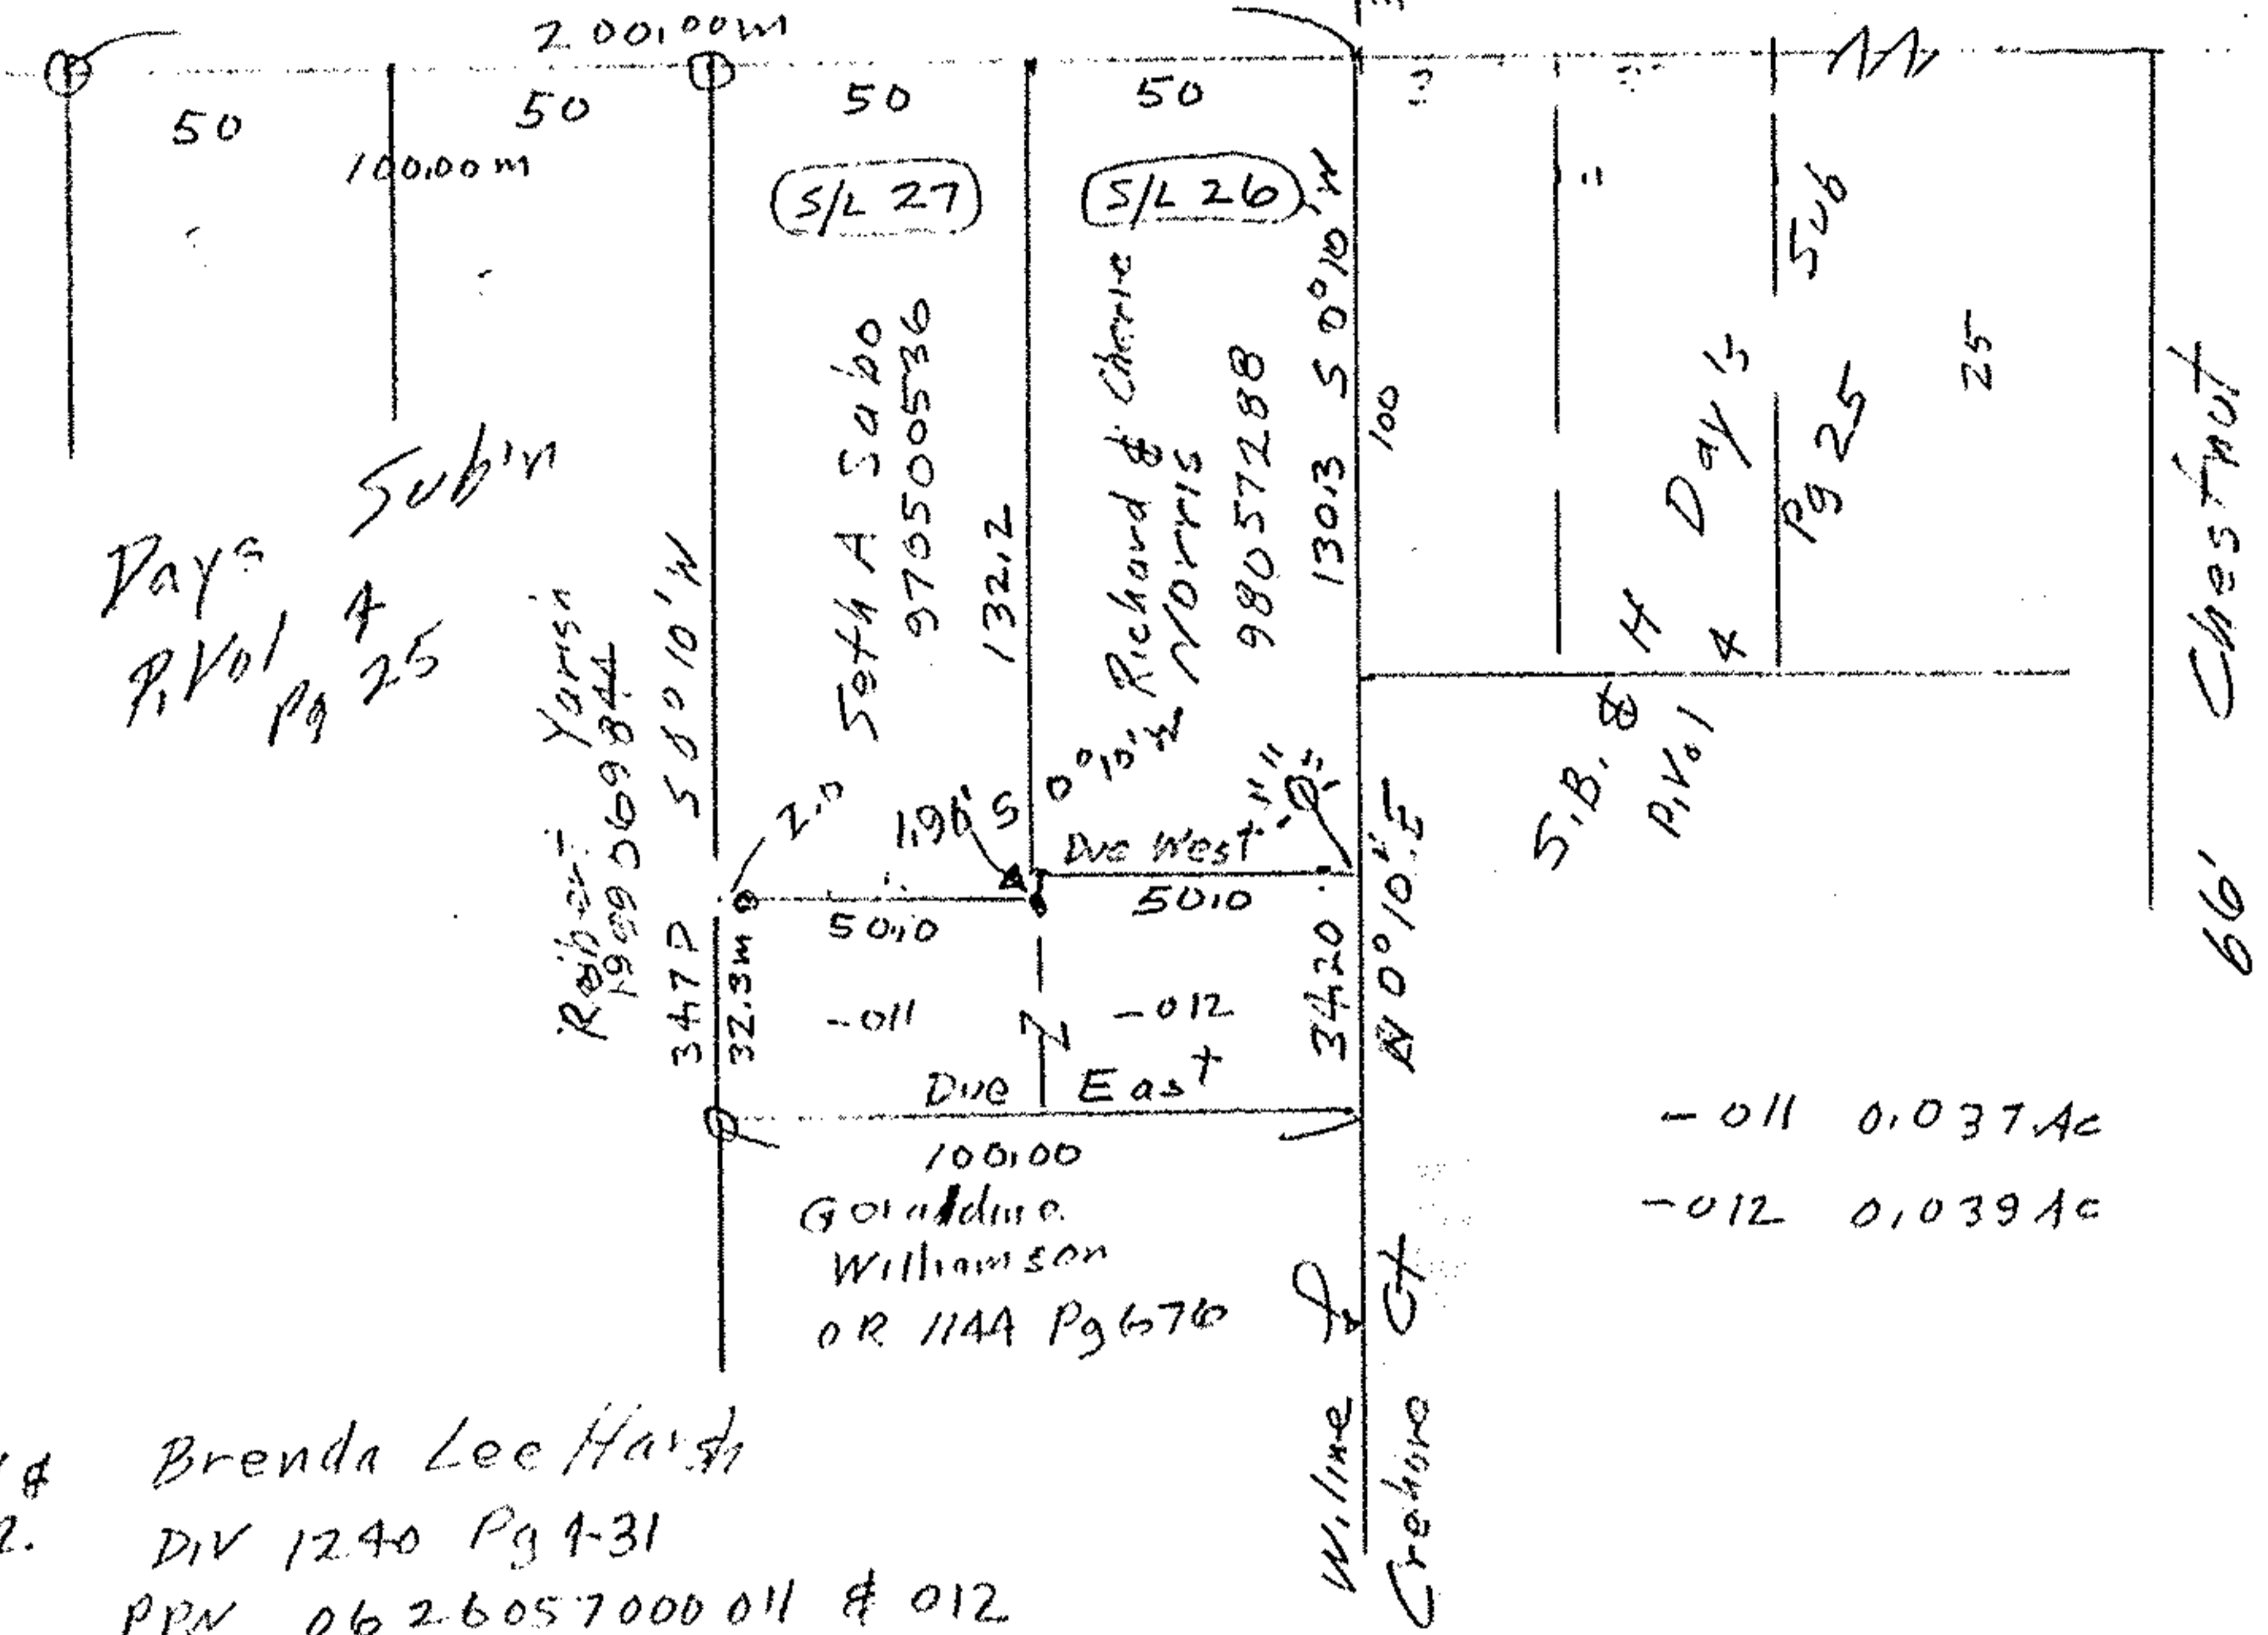

-011 & Brenda Lee Harsh
 -012. Div 1240 Pg 4-31
 PPN 0626057000 011 & 012

0 iron pipes fd
 0 iron pins set
 bearings to describe

John Pozywak
 Reg Surveyor
 5292

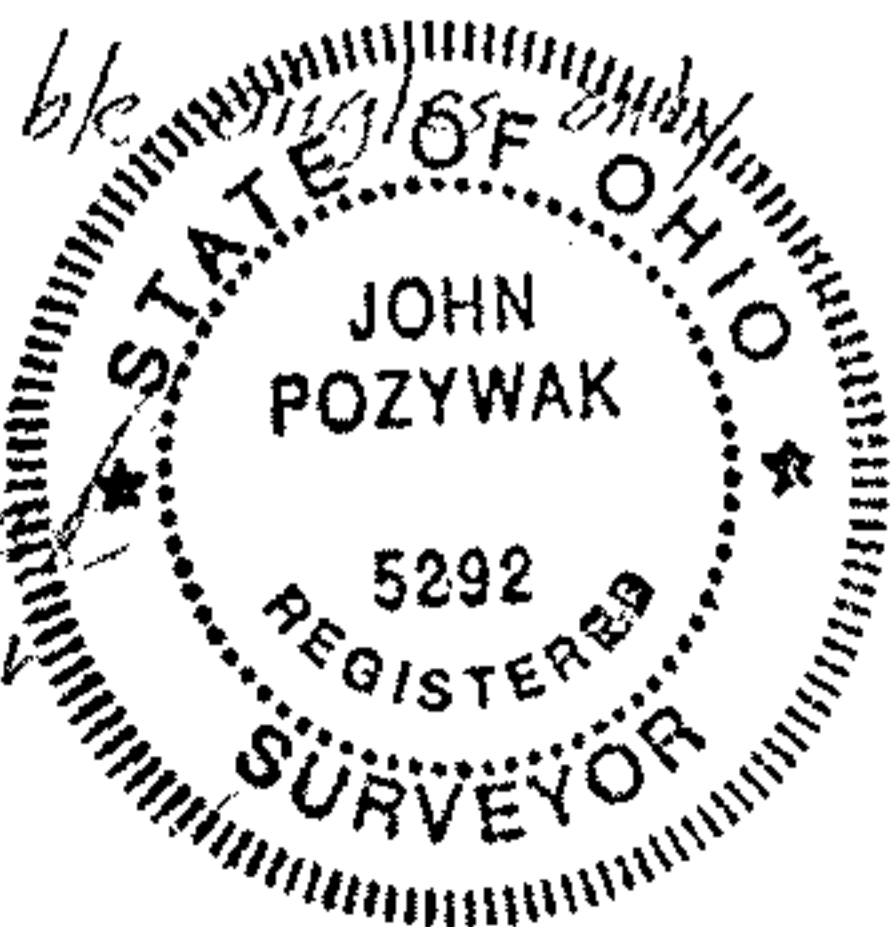

Survey of land owned by
 Brenda Lee Harsh
 Original Elyria Twp Lot 57
 Between the Black Rivers
 City of Elyria
 Lorain County Ohio
 Scale 1"=50' Det 2000
 Reused Mar 2002