


-004  
Karla Ann Wells  
O.R. 1129 P. 149

O.L. 81

O.L. 82

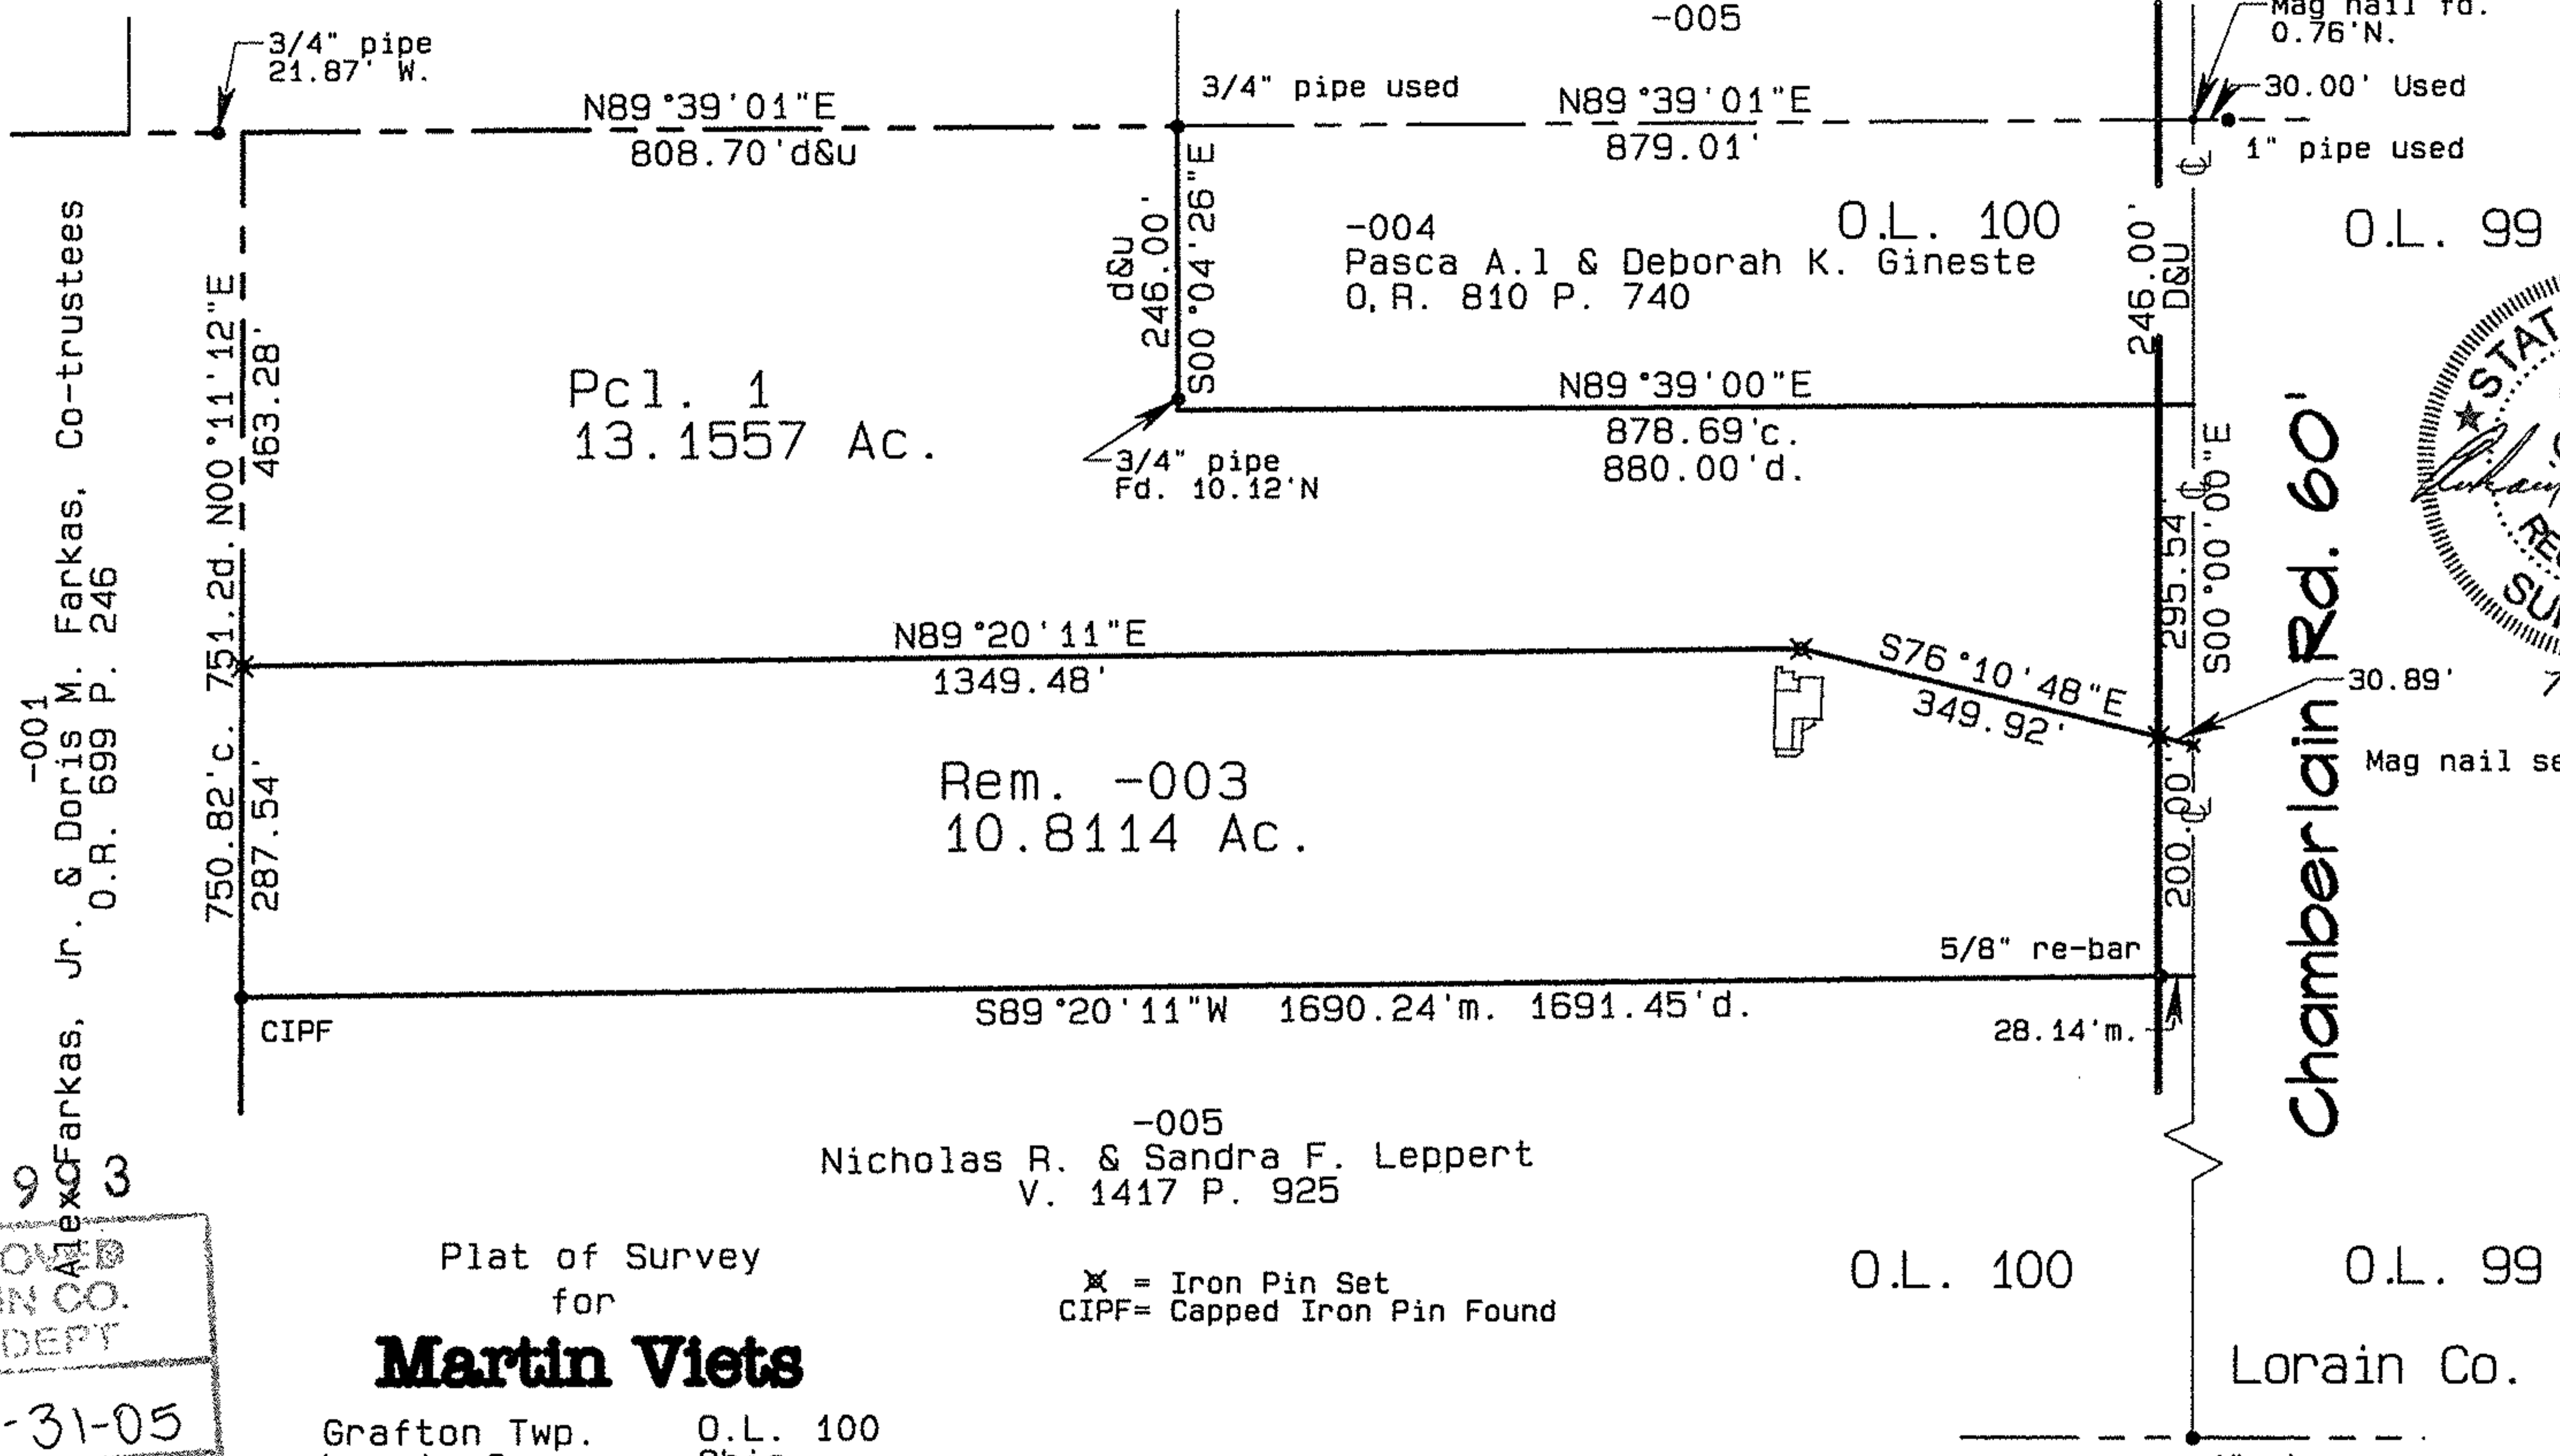

-001  
Farkas, Co-trustees  
M. Farkas, Jr. & Doris M. Farkas, Jr.  
O.R. 699 P. 246

Pc1. 1  
13.1557 Ac.

Rem. -003  
10.8114 Ac.

-004  
Pasca A.1 & Deborah K. Gineste  
O.R. 810 P. 740

-005  
Nicholas R. & Sandra F. Leppert  
V. 1417 P. 925



Chamberlain Rd. 60'

1" pipe  
Medina Co.

No 0193

APPROVED  
LORAIN CO.  
MAP DEPT  
DATE 8-31-05  
PAGE 16-E  
BY JHATfield  
# 05-01993

Plat of Survey  
for  
**Martin Viets**  
Grafton Twp. O.L. 100  
Lorain Co. Ohio  
Carlson Surveys  
June 2005

✕ = Iron Pin Set  
CIPF= Capped Iron Pin Found

