


LEGEND

- ⊙ - IRON PIN/PIPE FOUND
- - 5/8" X 30" CAPPED REBAR SET "KS ASSOC INC PROP MARKER"
- Ⓜ - MONUMENT BOX
- (S) - SURVEYED
- (R) - RECORD
- FD. - FOUND

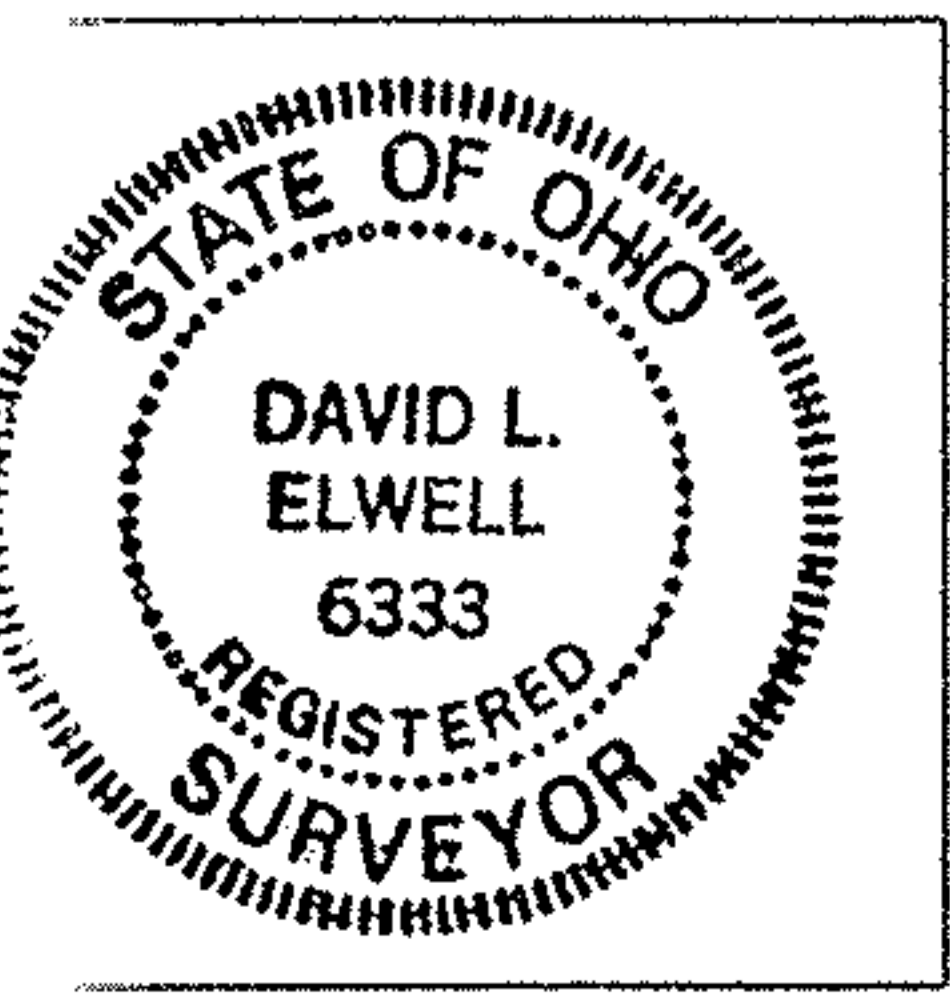

David L. Elwell
DAVID L. ELWELL, REGISTERED SURVEYOR NO. 6333

KS ASSOCIATES

KS Associates, Inc.
260 Burns Rd., Suite 100
Elyria, Ohio 44035
Phone (440) 365-4730
Fax (440) 365-4790
mailroom@ksassoc.com
www.ksassoc.com

BOUNDARY SURVEY
OF PART OF
AVON TOWNSHIP SECTION NO. 30
CITY OF AVON LAKE COUNTY OF LORAIN
STATE OF OHIO
DATE: JULY 6, 2004

JOB NO. 04178
DWG. NAME 0-SURV01