


16-00-001-00

9192

R/W Curve Data
 $D = 1^{\circ}32'32''$
 $R = 2831.93$
 $CB = 89^{\circ}57'16'' W$
 $CH = 76.22$

R/W Curve Data
 $R = 1196.28$
 $\delta = 10^{\circ}11'38''$
 $CH = 212.56$

16-00-001-00

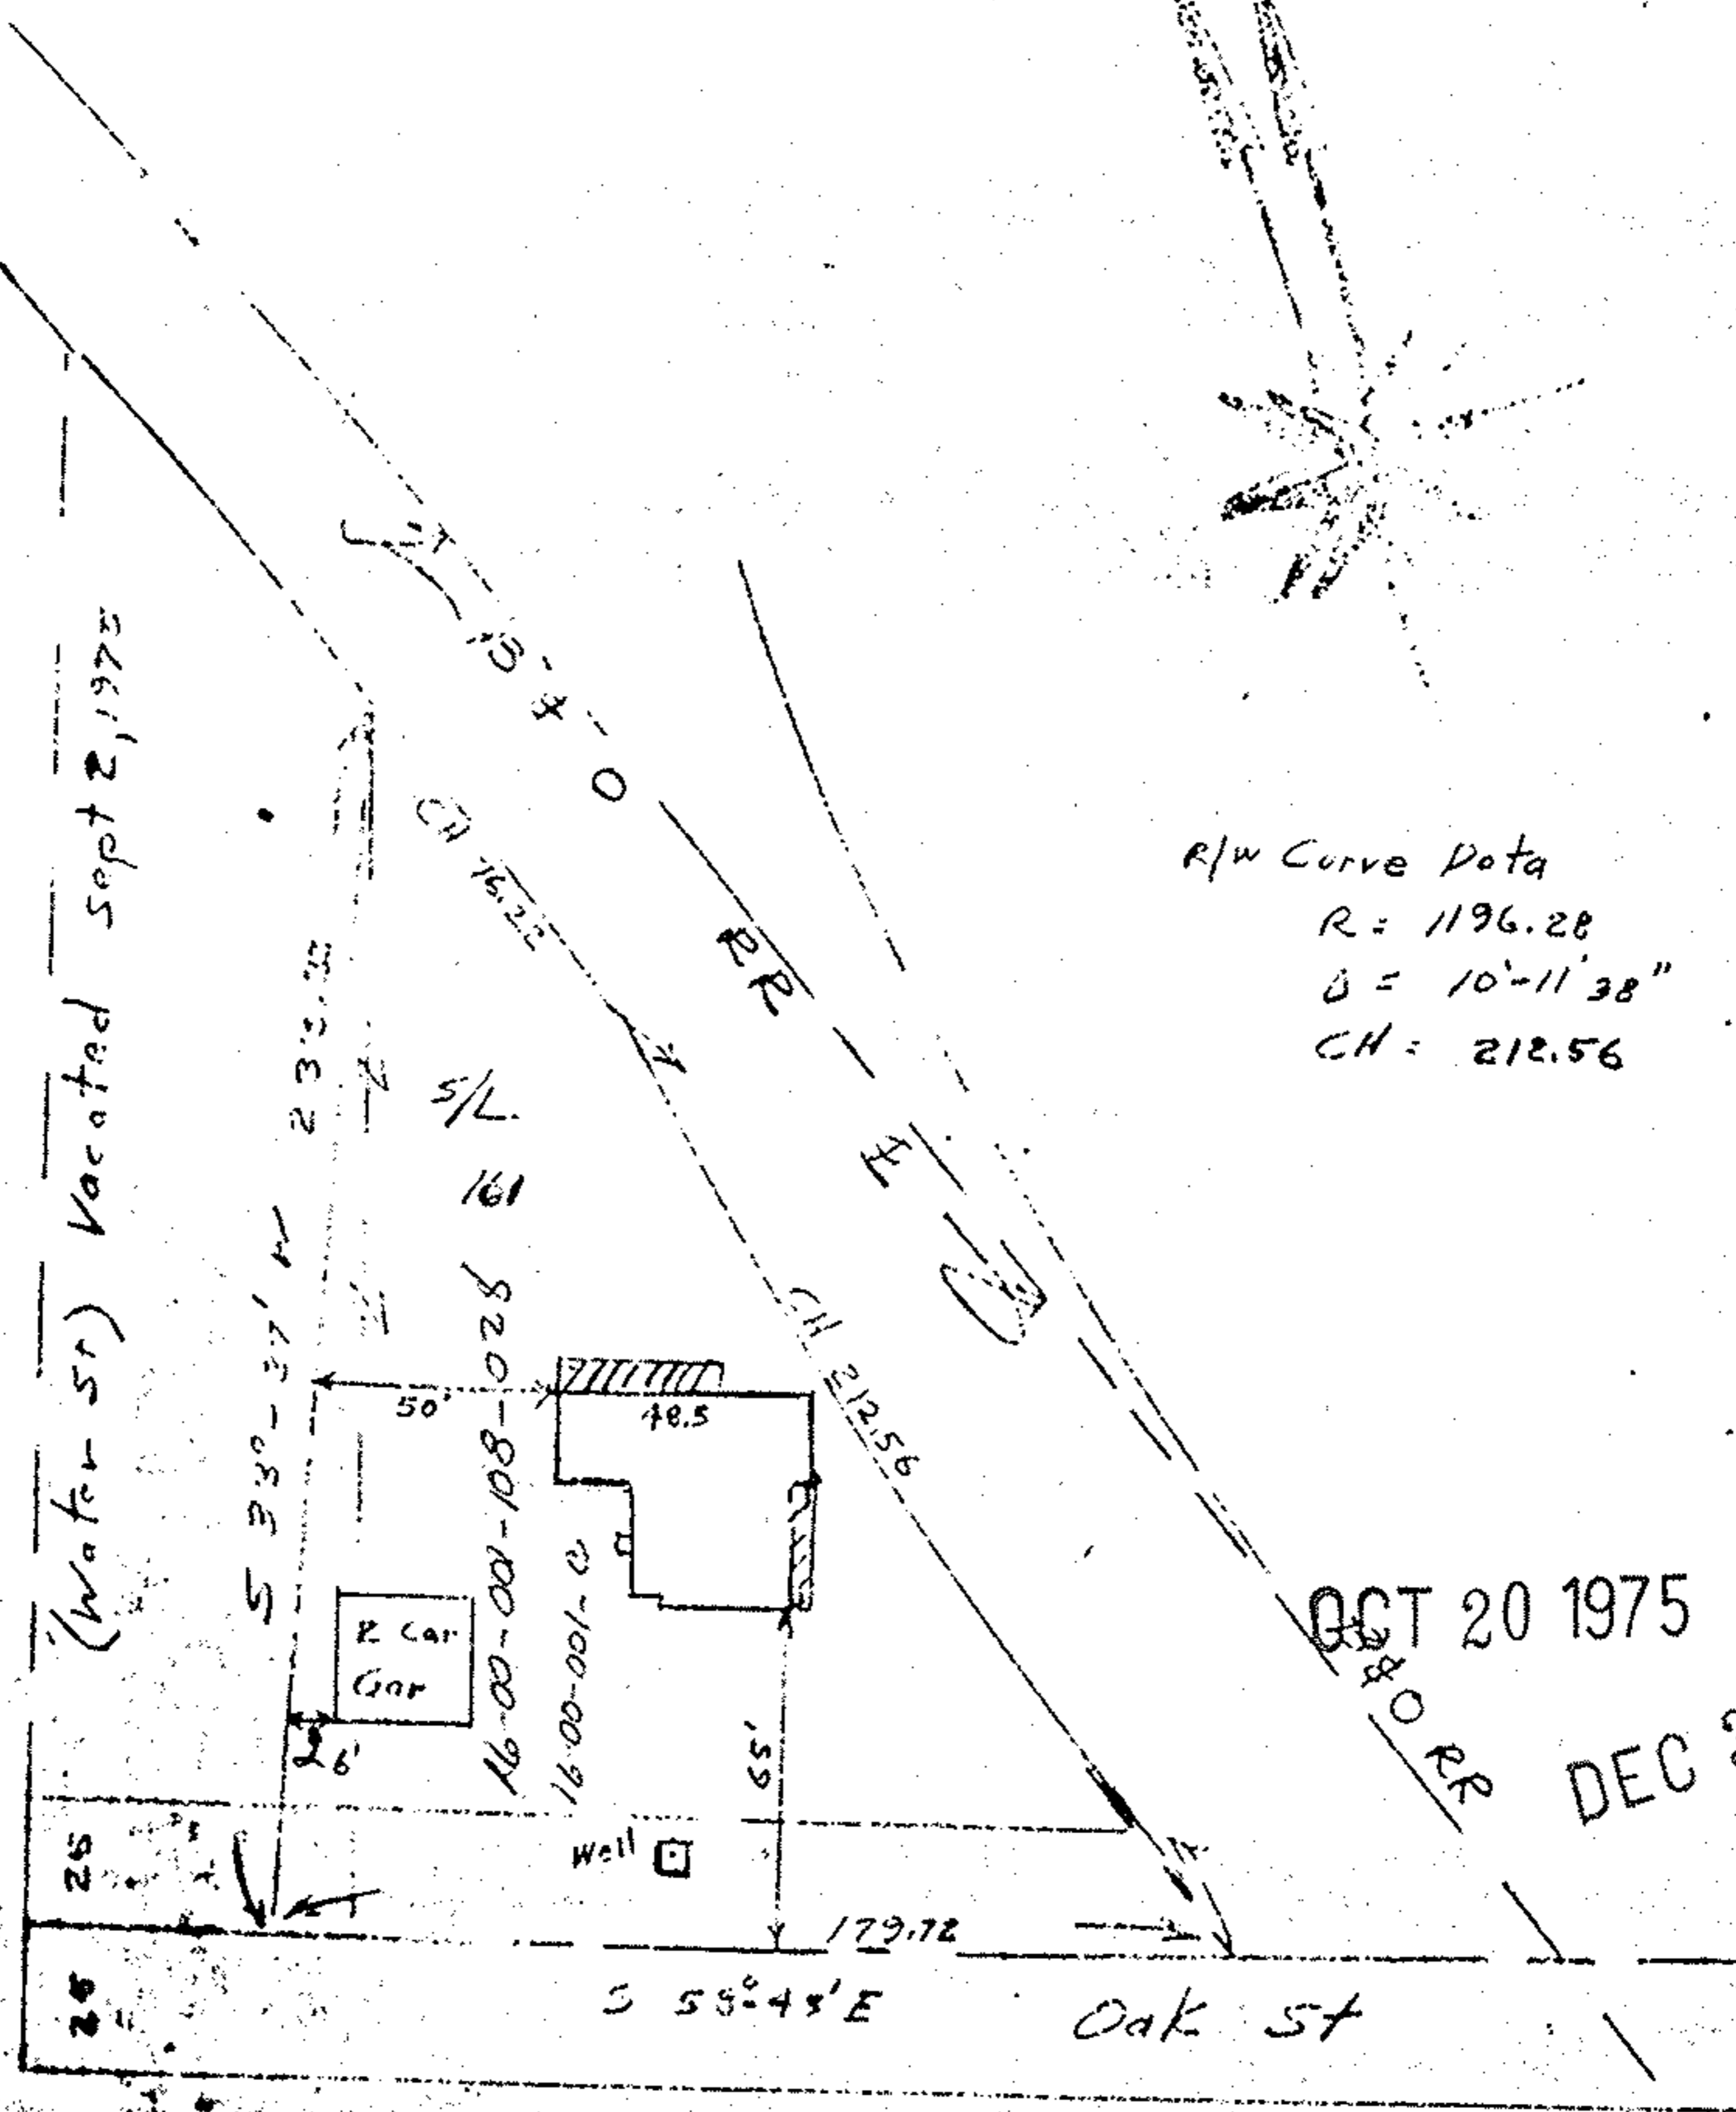

OCT 20 1975

DEC 31 1975

John Poznyak
 Reg Surveyor
 # 529

LOCATION SURVEY ON SUBLOT 161
 Part of Original Lot 1
 GRAFTON TOWNSHIP
 Village of Grafton
 LORAIN COUNTY OHIO
 Scale 1"=60' Sept 8, 1975