



CARDINAL SURVEYS
 PLAT OF SURVEY
 PREPARED FOR G. SPADAFORA

Survey of N.E. Section Lot #81

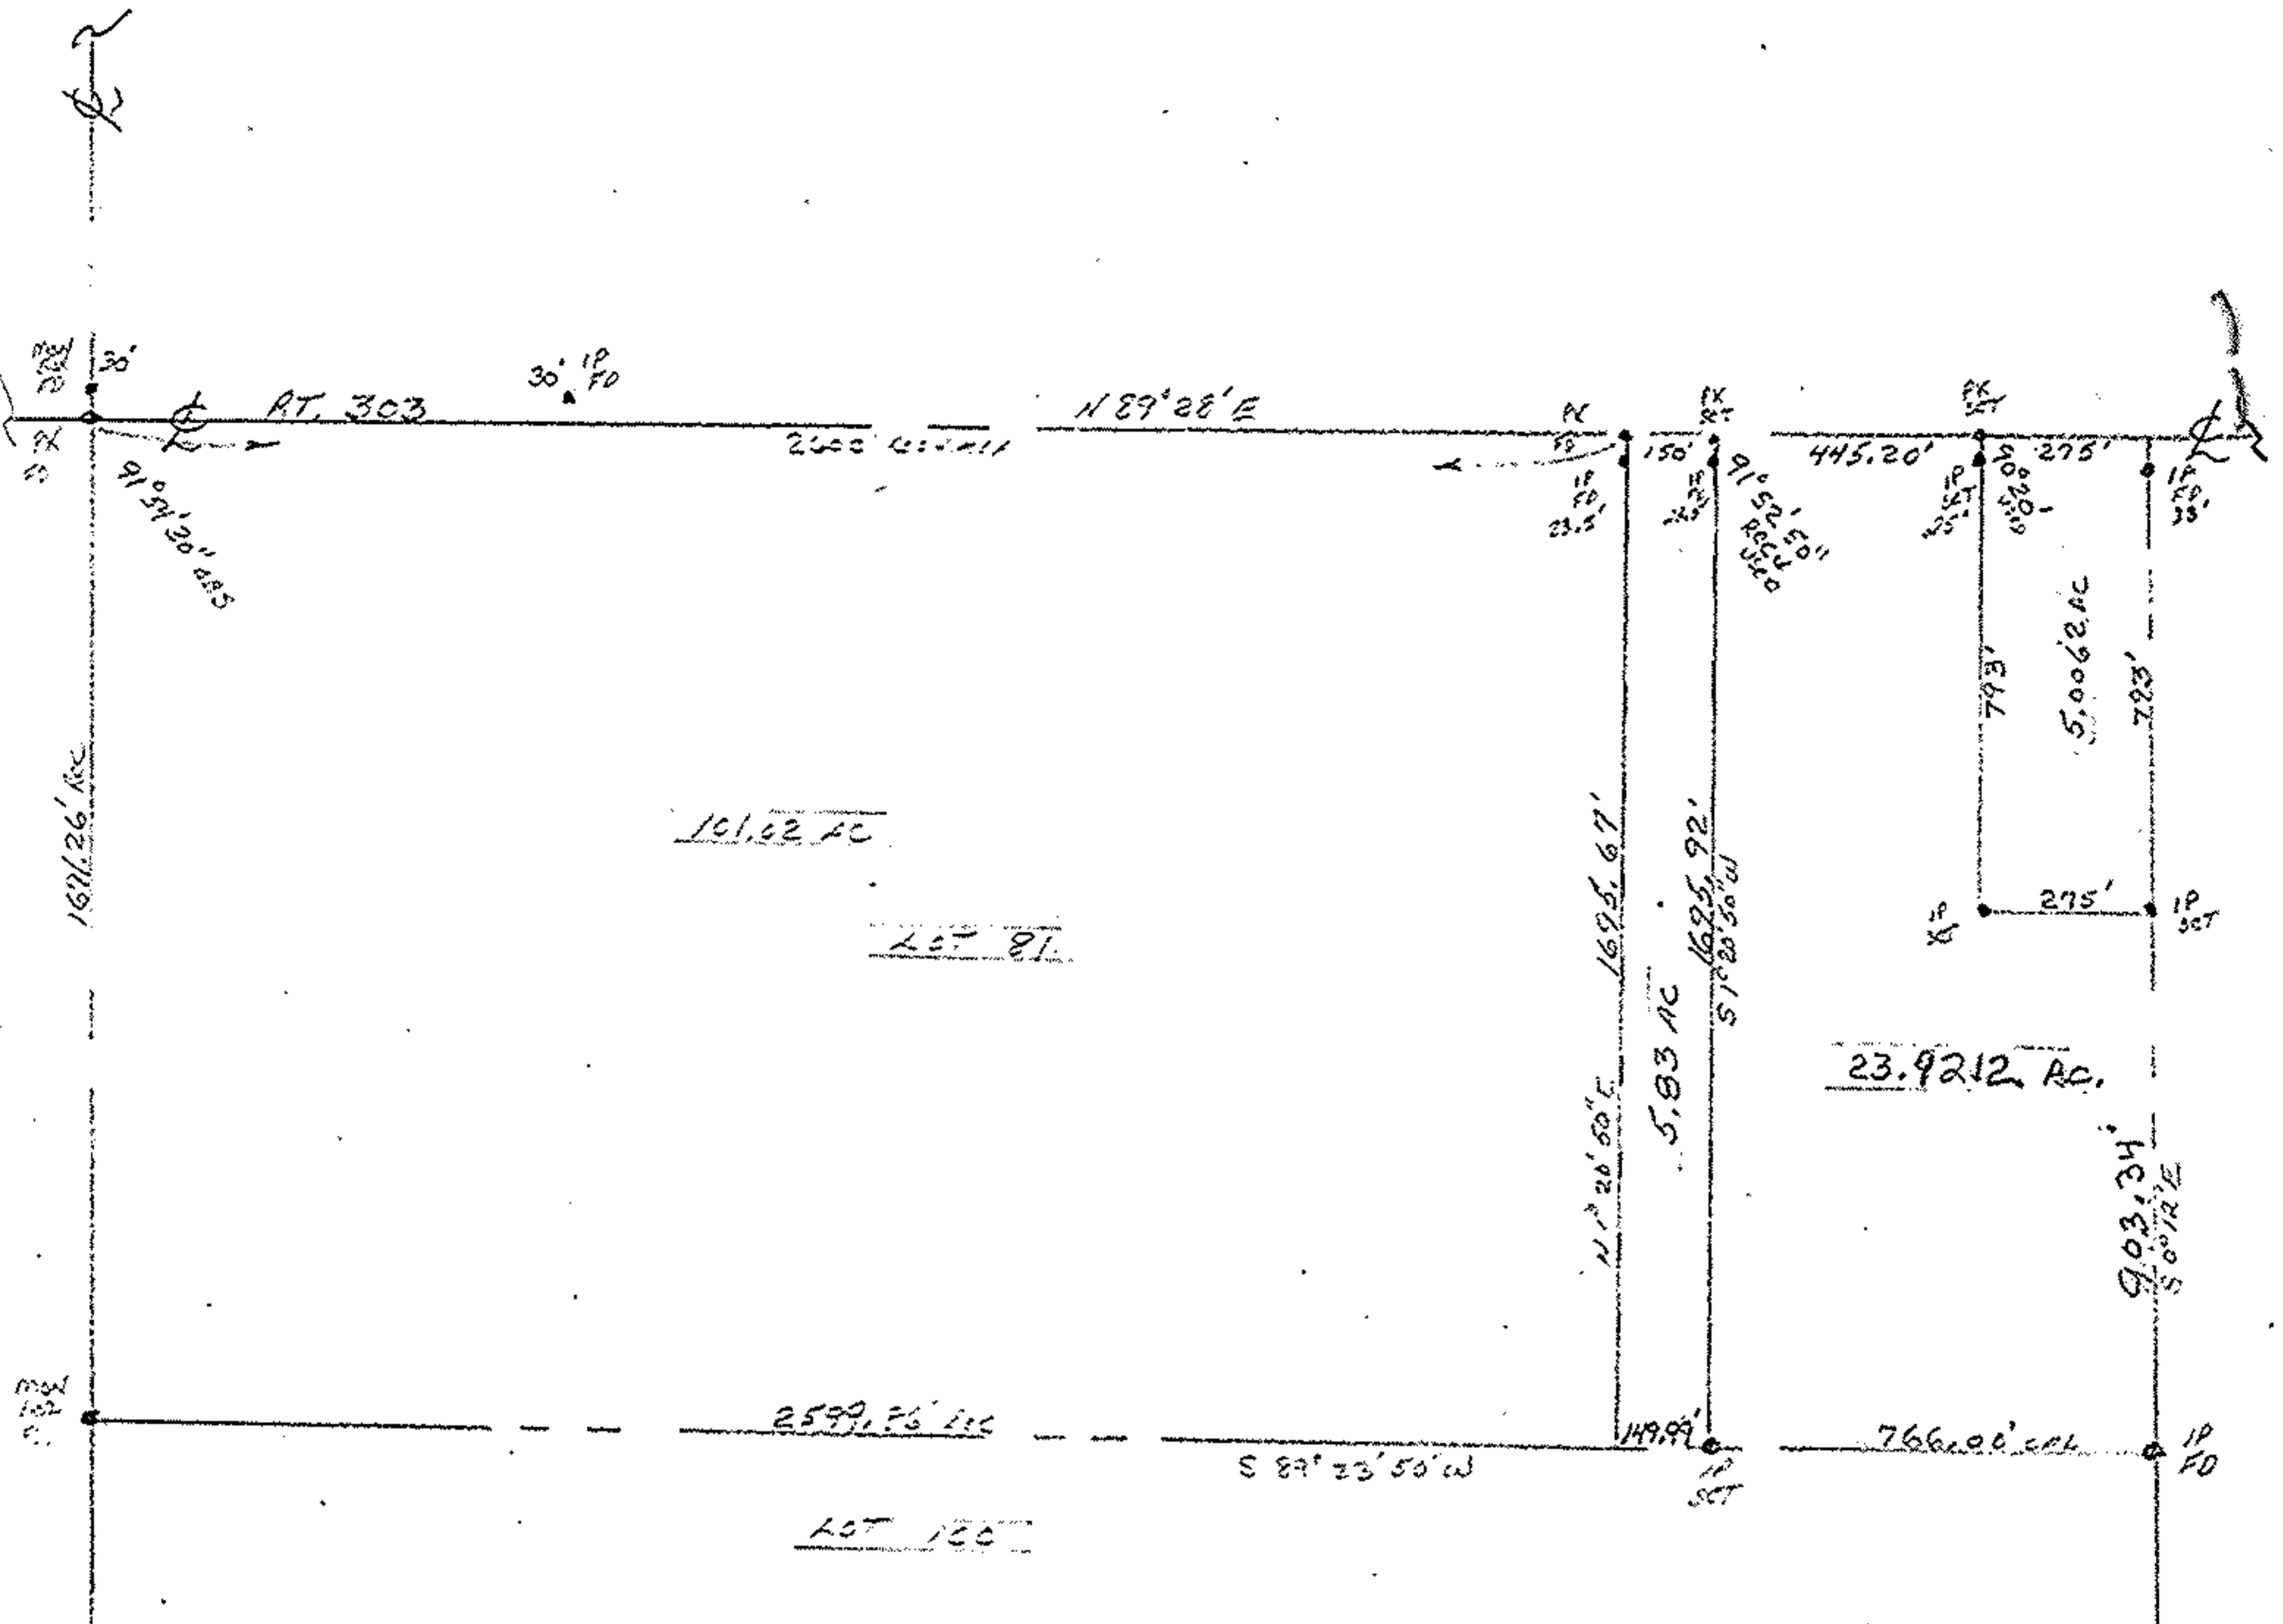

#00 320-A

APPROVED LORAIN CO. MAP DEPT
DATE 3-9-2000
PAGE 14-H
BY <i>J. Gilbert</i>
#00 320-A

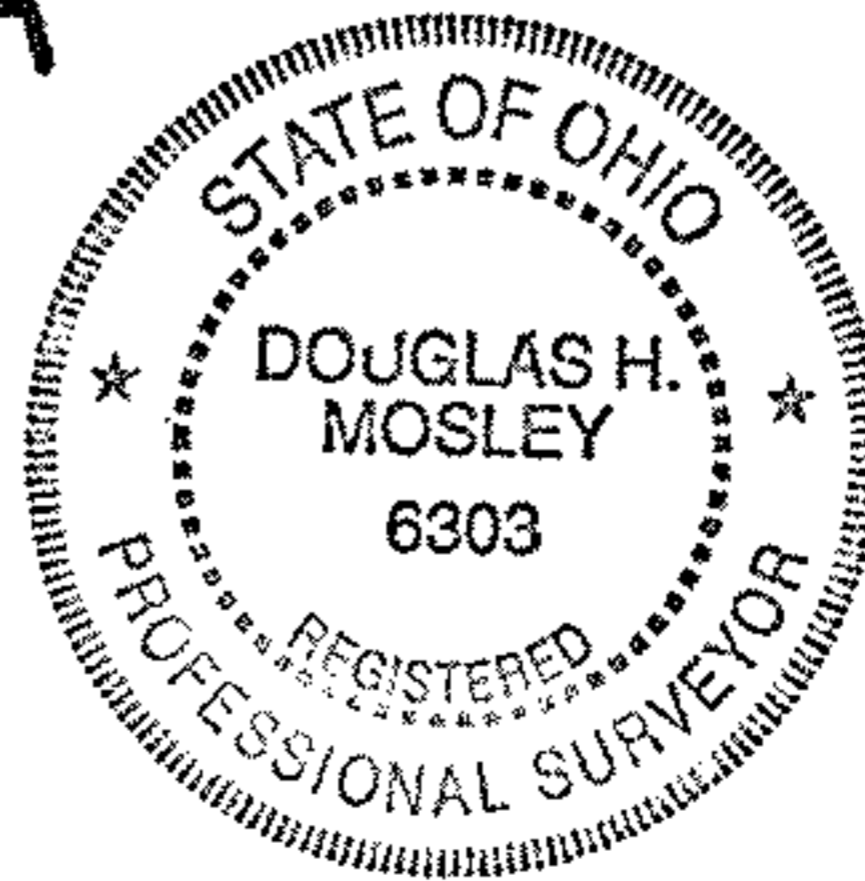

DATE: MARCH 31, 1980

SCALE: 1" = 500'

