
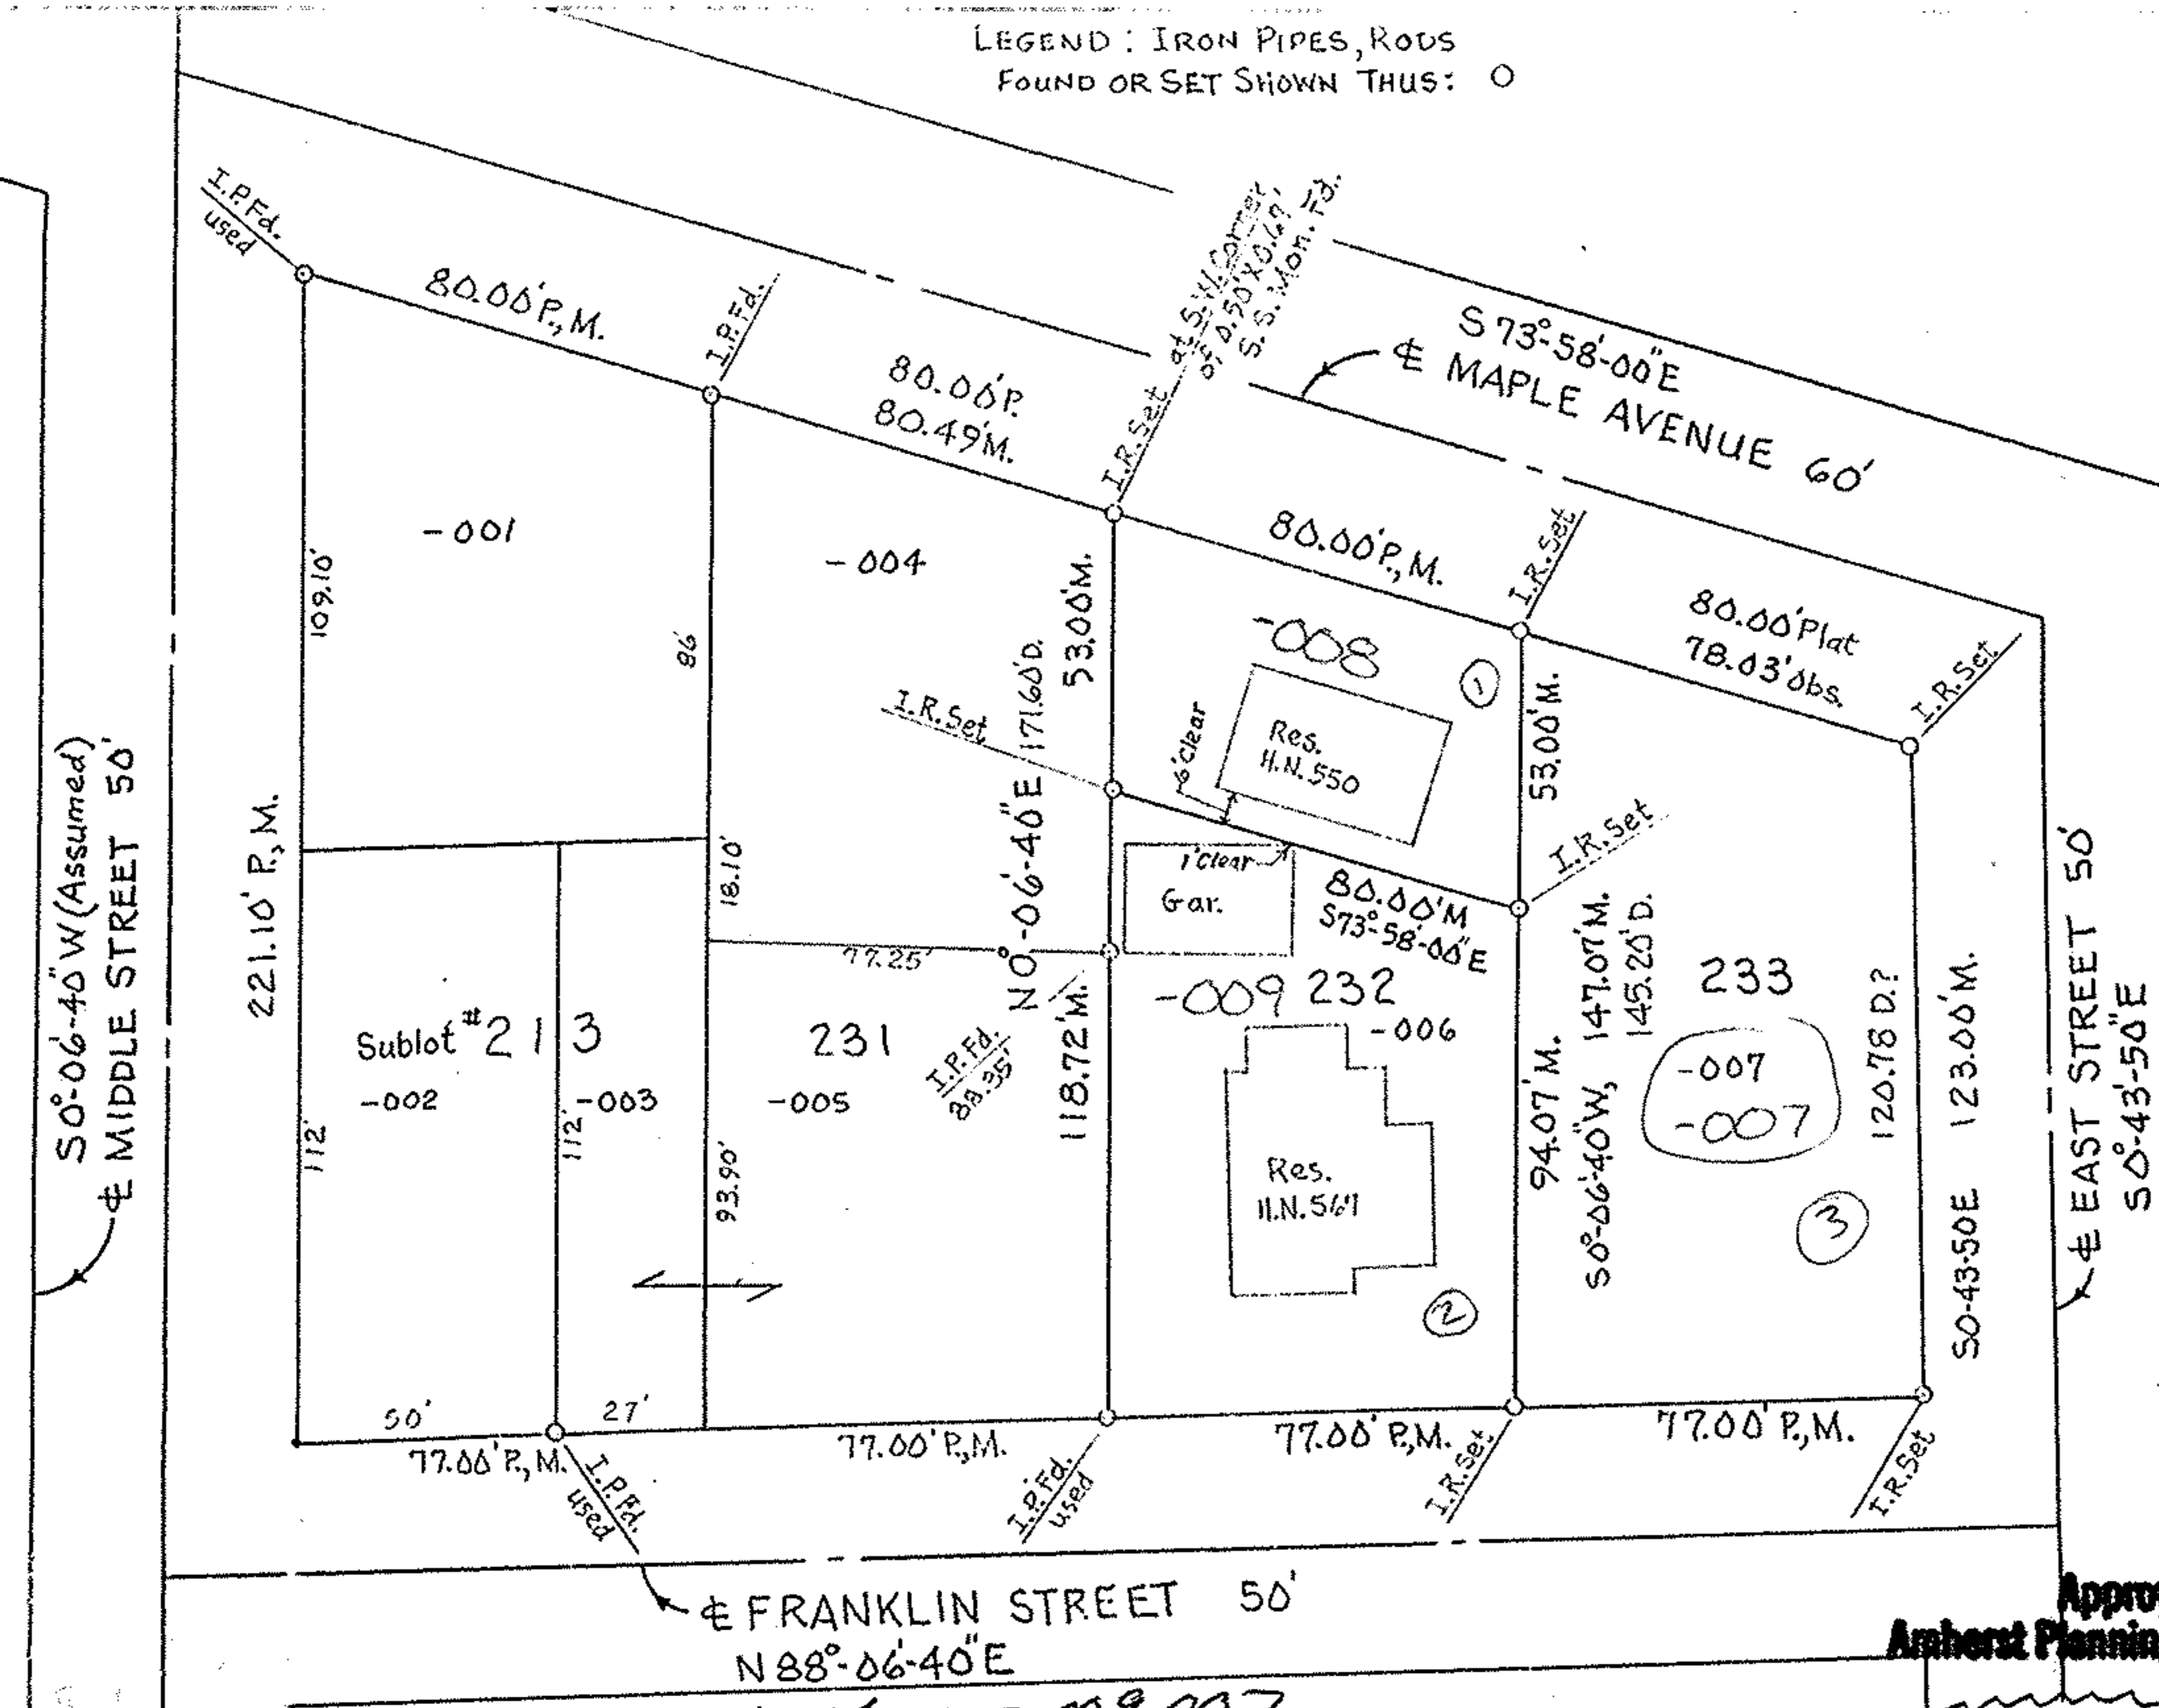


LEGEND: IRON PIPES, RODS
 FOUND OR SET SHOWN THUS: ○

NORTH

ASSUMED
 MERIDIAN

SCALE
 1"=50'

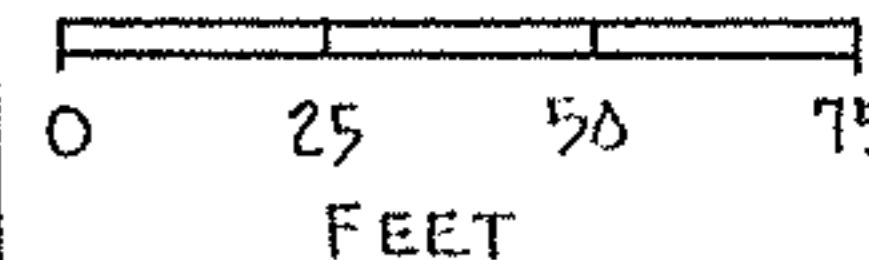

#00505

APPROVED
 LORAIN CO.
 MAP DEPT.

DATE 7/18/00

PAGE 5-00-024-B

BY T. SPILLMAN

00505

Approved
 Amherst Planning Commission

Mayor John P. ... 07-10-2000
 Date

05-00-024-114-008, 009, 007

Perm. Par. No. 05-00-024-114-006, Sublot No. 232
 " " " " " " " " -007, Sublot No. 233
 O.R. Volume 1429, P.191
 Josiah Harris Addition,
 Part of Original Amherst Twp. Lot No. 24,
 Plat Volume 2, Page 3, Lorain Co. Records

Charles P. Waryu
 CHARLES P. WARYU,
 Registered Surveyor
 No. 5029

MAP OF SURVEY MADE,
 DIVISION OF SUBLLOT NO. 232, ALL OF 233
 For Ralph L. Walker
 By Charles P. Waryu, Reg. Survey No. 5029
 March 2000