


PLAT OF SURVEY FOR HERBERT & MARGARET KRIEBEL

ORIGINAL LOTS 73 & 74 SHEFFIELD TOWNSHIP
SHEFFIELD VILLAGE LORAIN COUNTY OHIO

SCALE: 1" = 60'
NOVEMBER 1, 1957
C.E. Perfound
Registered Surveyor

NOTE: Iron pins found
or set shown thus: ●

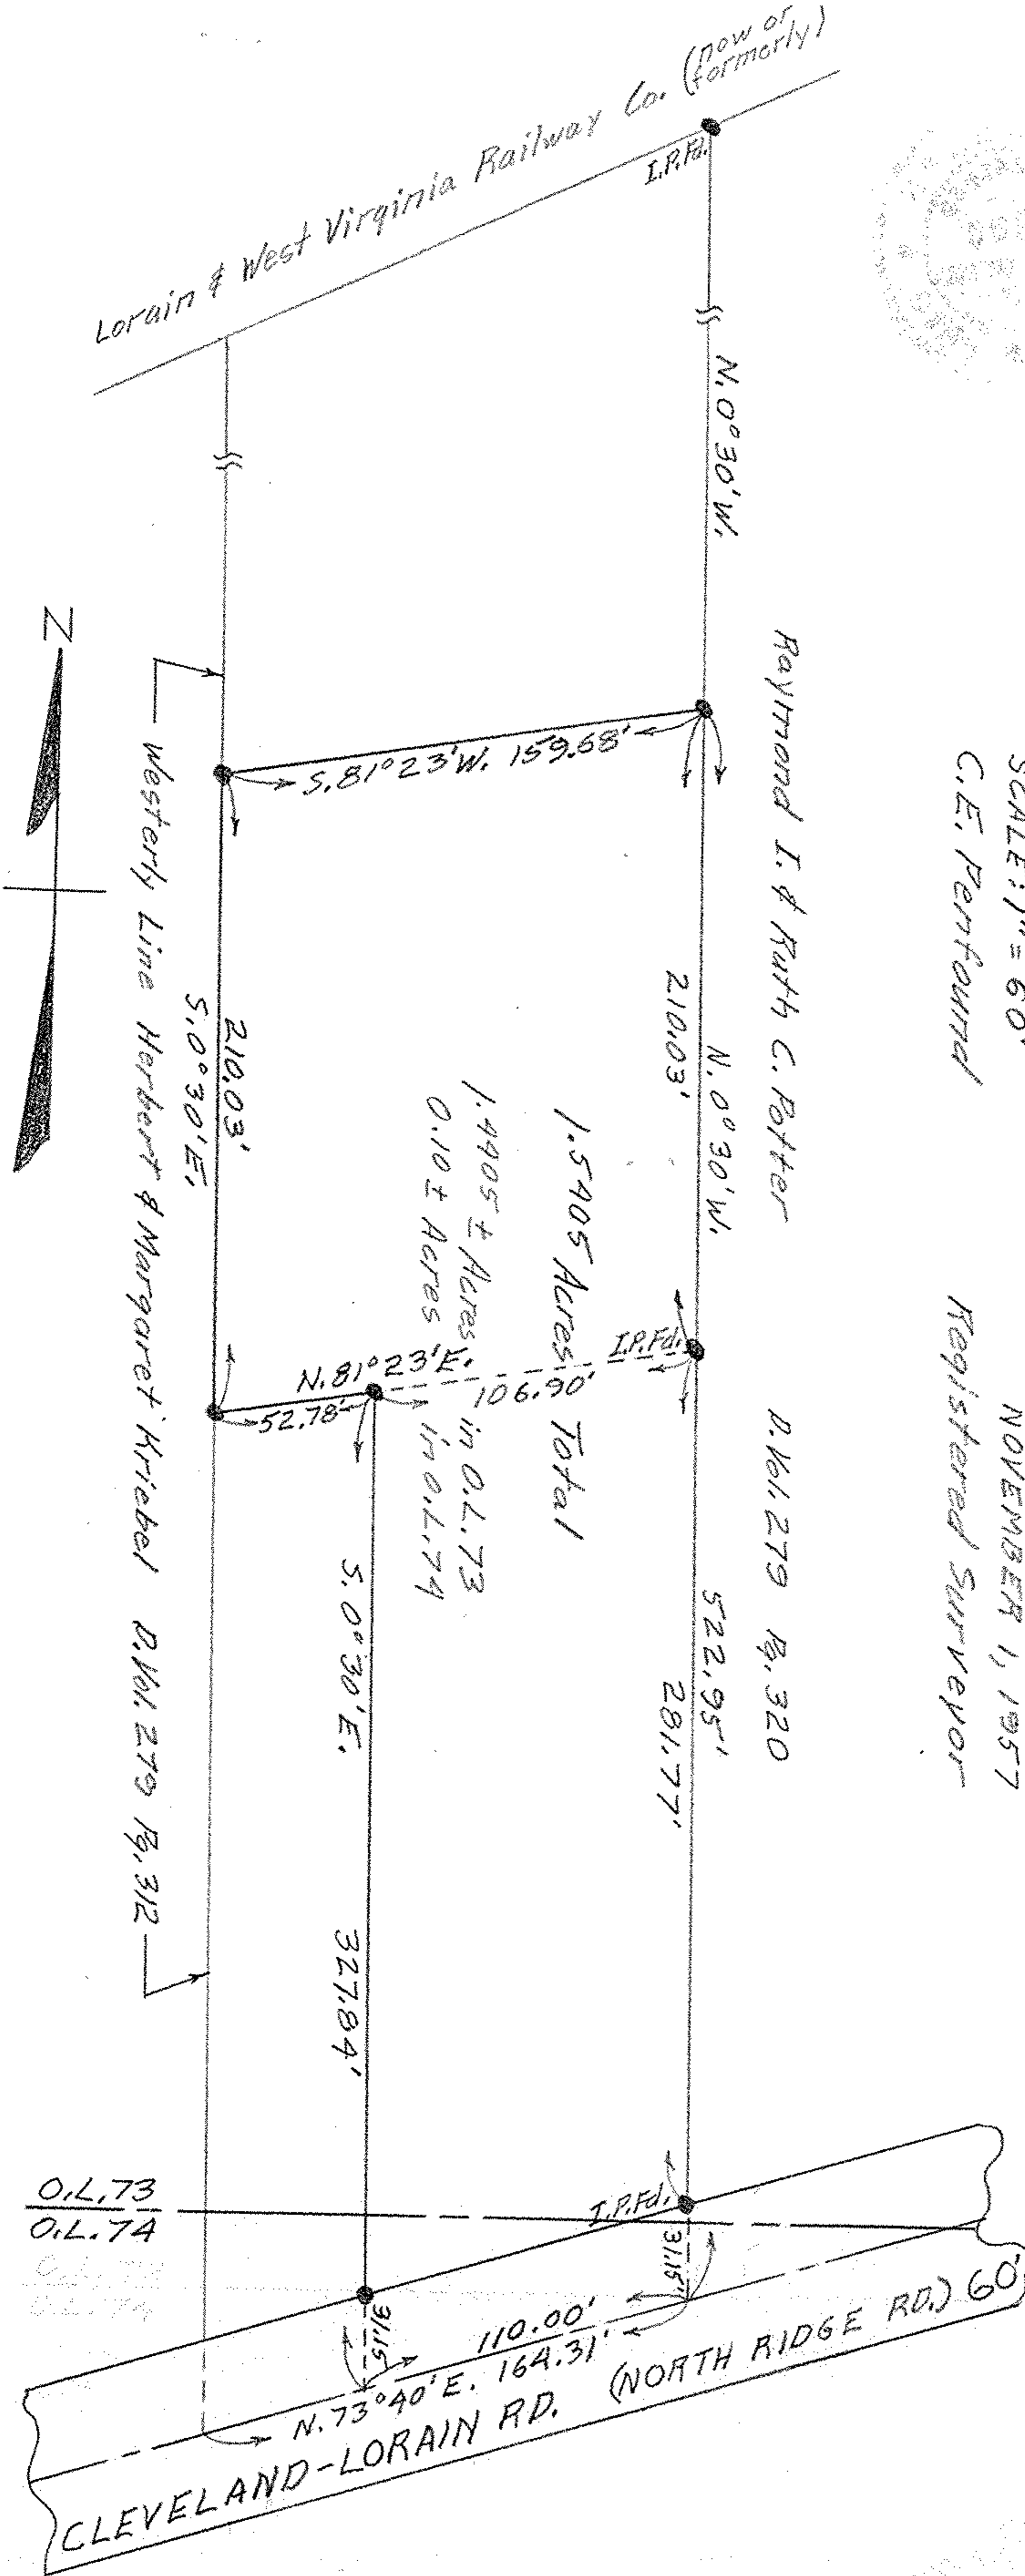

O.L. 73
O.L. 74