


See C&EP Surv. 12" File

17010
O. 17010
L. 17010
R. 17010
Pg. 552

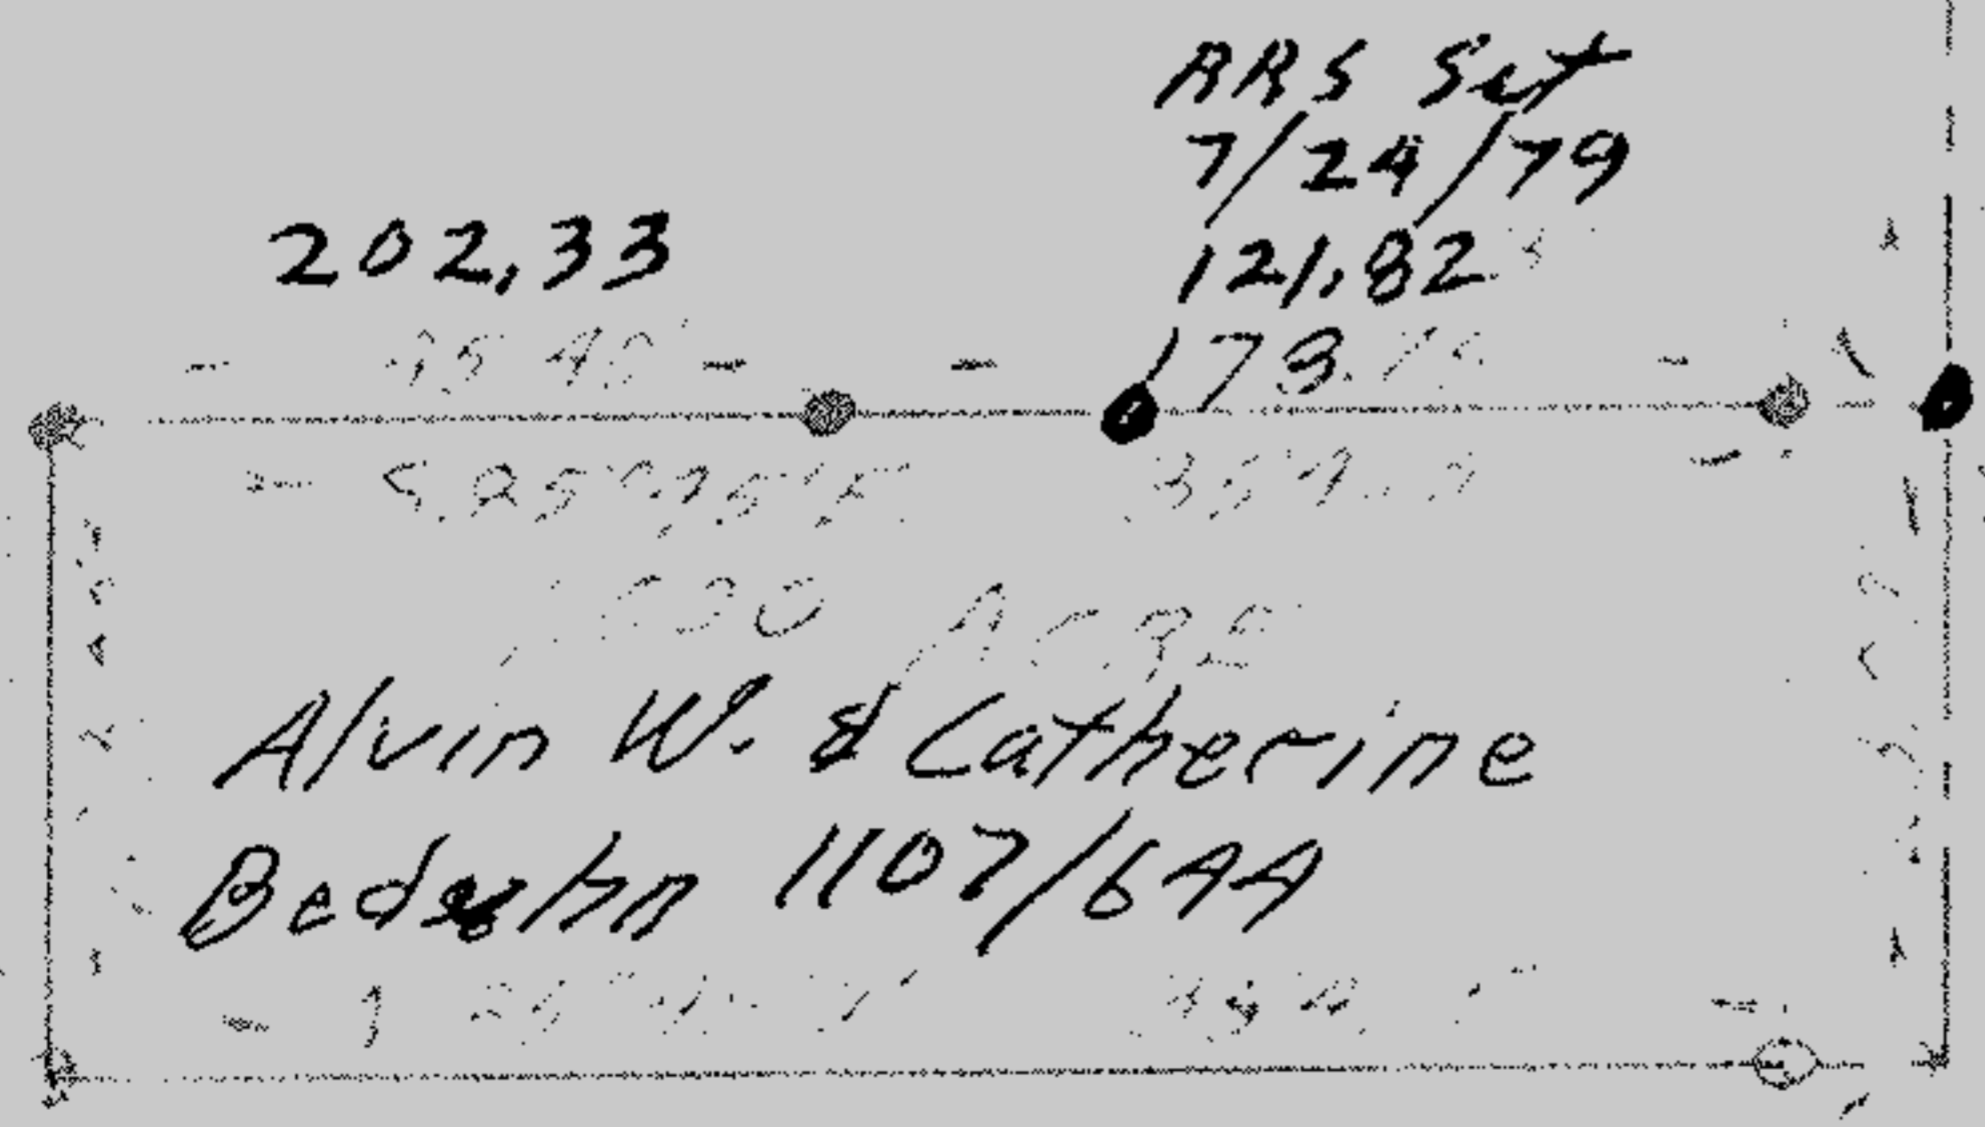

Replaced w/ 1/2 in Man-Box
by LORAIN CO. ENGR.

COWLEY ROAD

RICHARD A. & JANICE BROOKS (12" File)

See C&EP Surv. 12" File
for East side of Road



Alvin Beduhn 1107/69A
926-3265