


ERHART NORTHERN ROAD 46 1/2' (See Note below)

LORAIN COUNTY  
MEDINA COUNTY

PLAT OF RE-SURVEYING FOR  
**LESTER H. & ROSEMARY L. KLOOZ**  
 LOT 1 - SECTION 11 - LIVERPOOL TWP.  
 MEDINA COUNTY OHIO  
 SCALE: 1"=100' JUNE - 1976  
 Gary E. Penfound Reg. Surveyor No. 4957

Lorain County Road Record Vol. 3 Pg. 194 establishes  
 Erhart Northern Road as 46 1/2' - 30' existing in  
 Medina County and an additional 16 1/2' in Lorain  
 County, which approximates remaining fence lines.

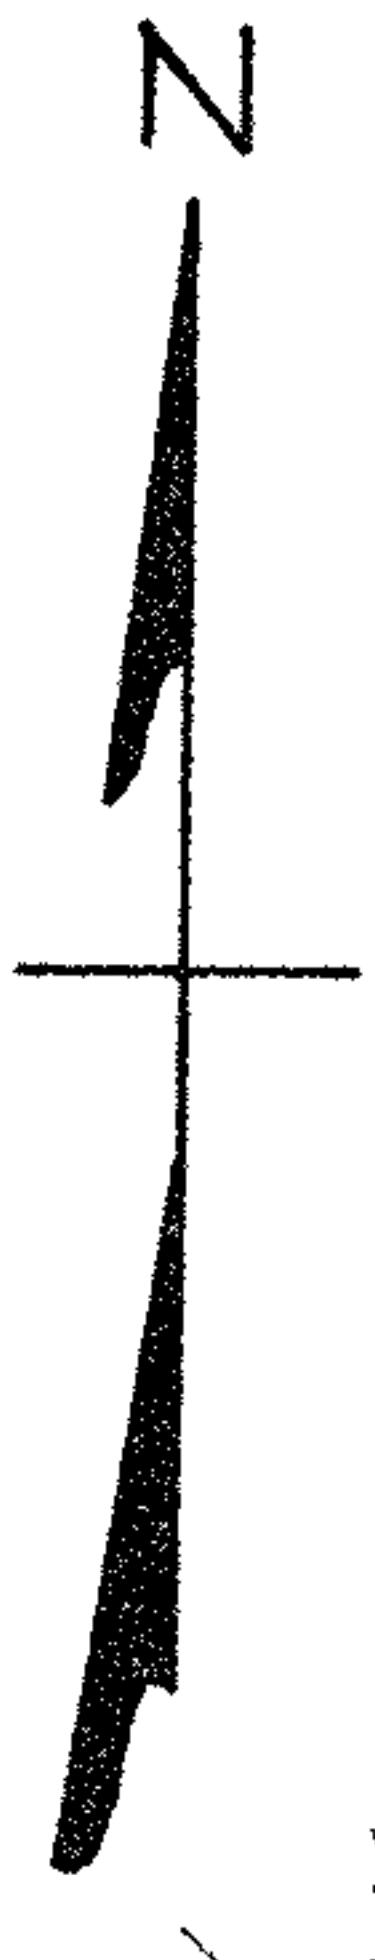

NOTES: o indicates iron pin set (and  
 remaining) from April 1972 surveys  
 unless otherwise designated.  
 • indicates iron pin set or reset  
 in June or July, 1976.

used for I.P.F.  
5,0°09'40"E.

LOT 1  
LOT 4

STATE ROUTE 303 60' CENTER ROAD

90°24' Rec. # Used