


# PLAT of SURVEY

PART of LOT 46

LITCHFIELD TWP MEDEINA CO  
OHIO

DATE ~ MAY 1948  
SCALE ~ 40'-1"  
SURVEYED BY ~ MEDEINA CO ENGINEERS  
FIELD NOTES ~ EA 403 EA 26

N 30

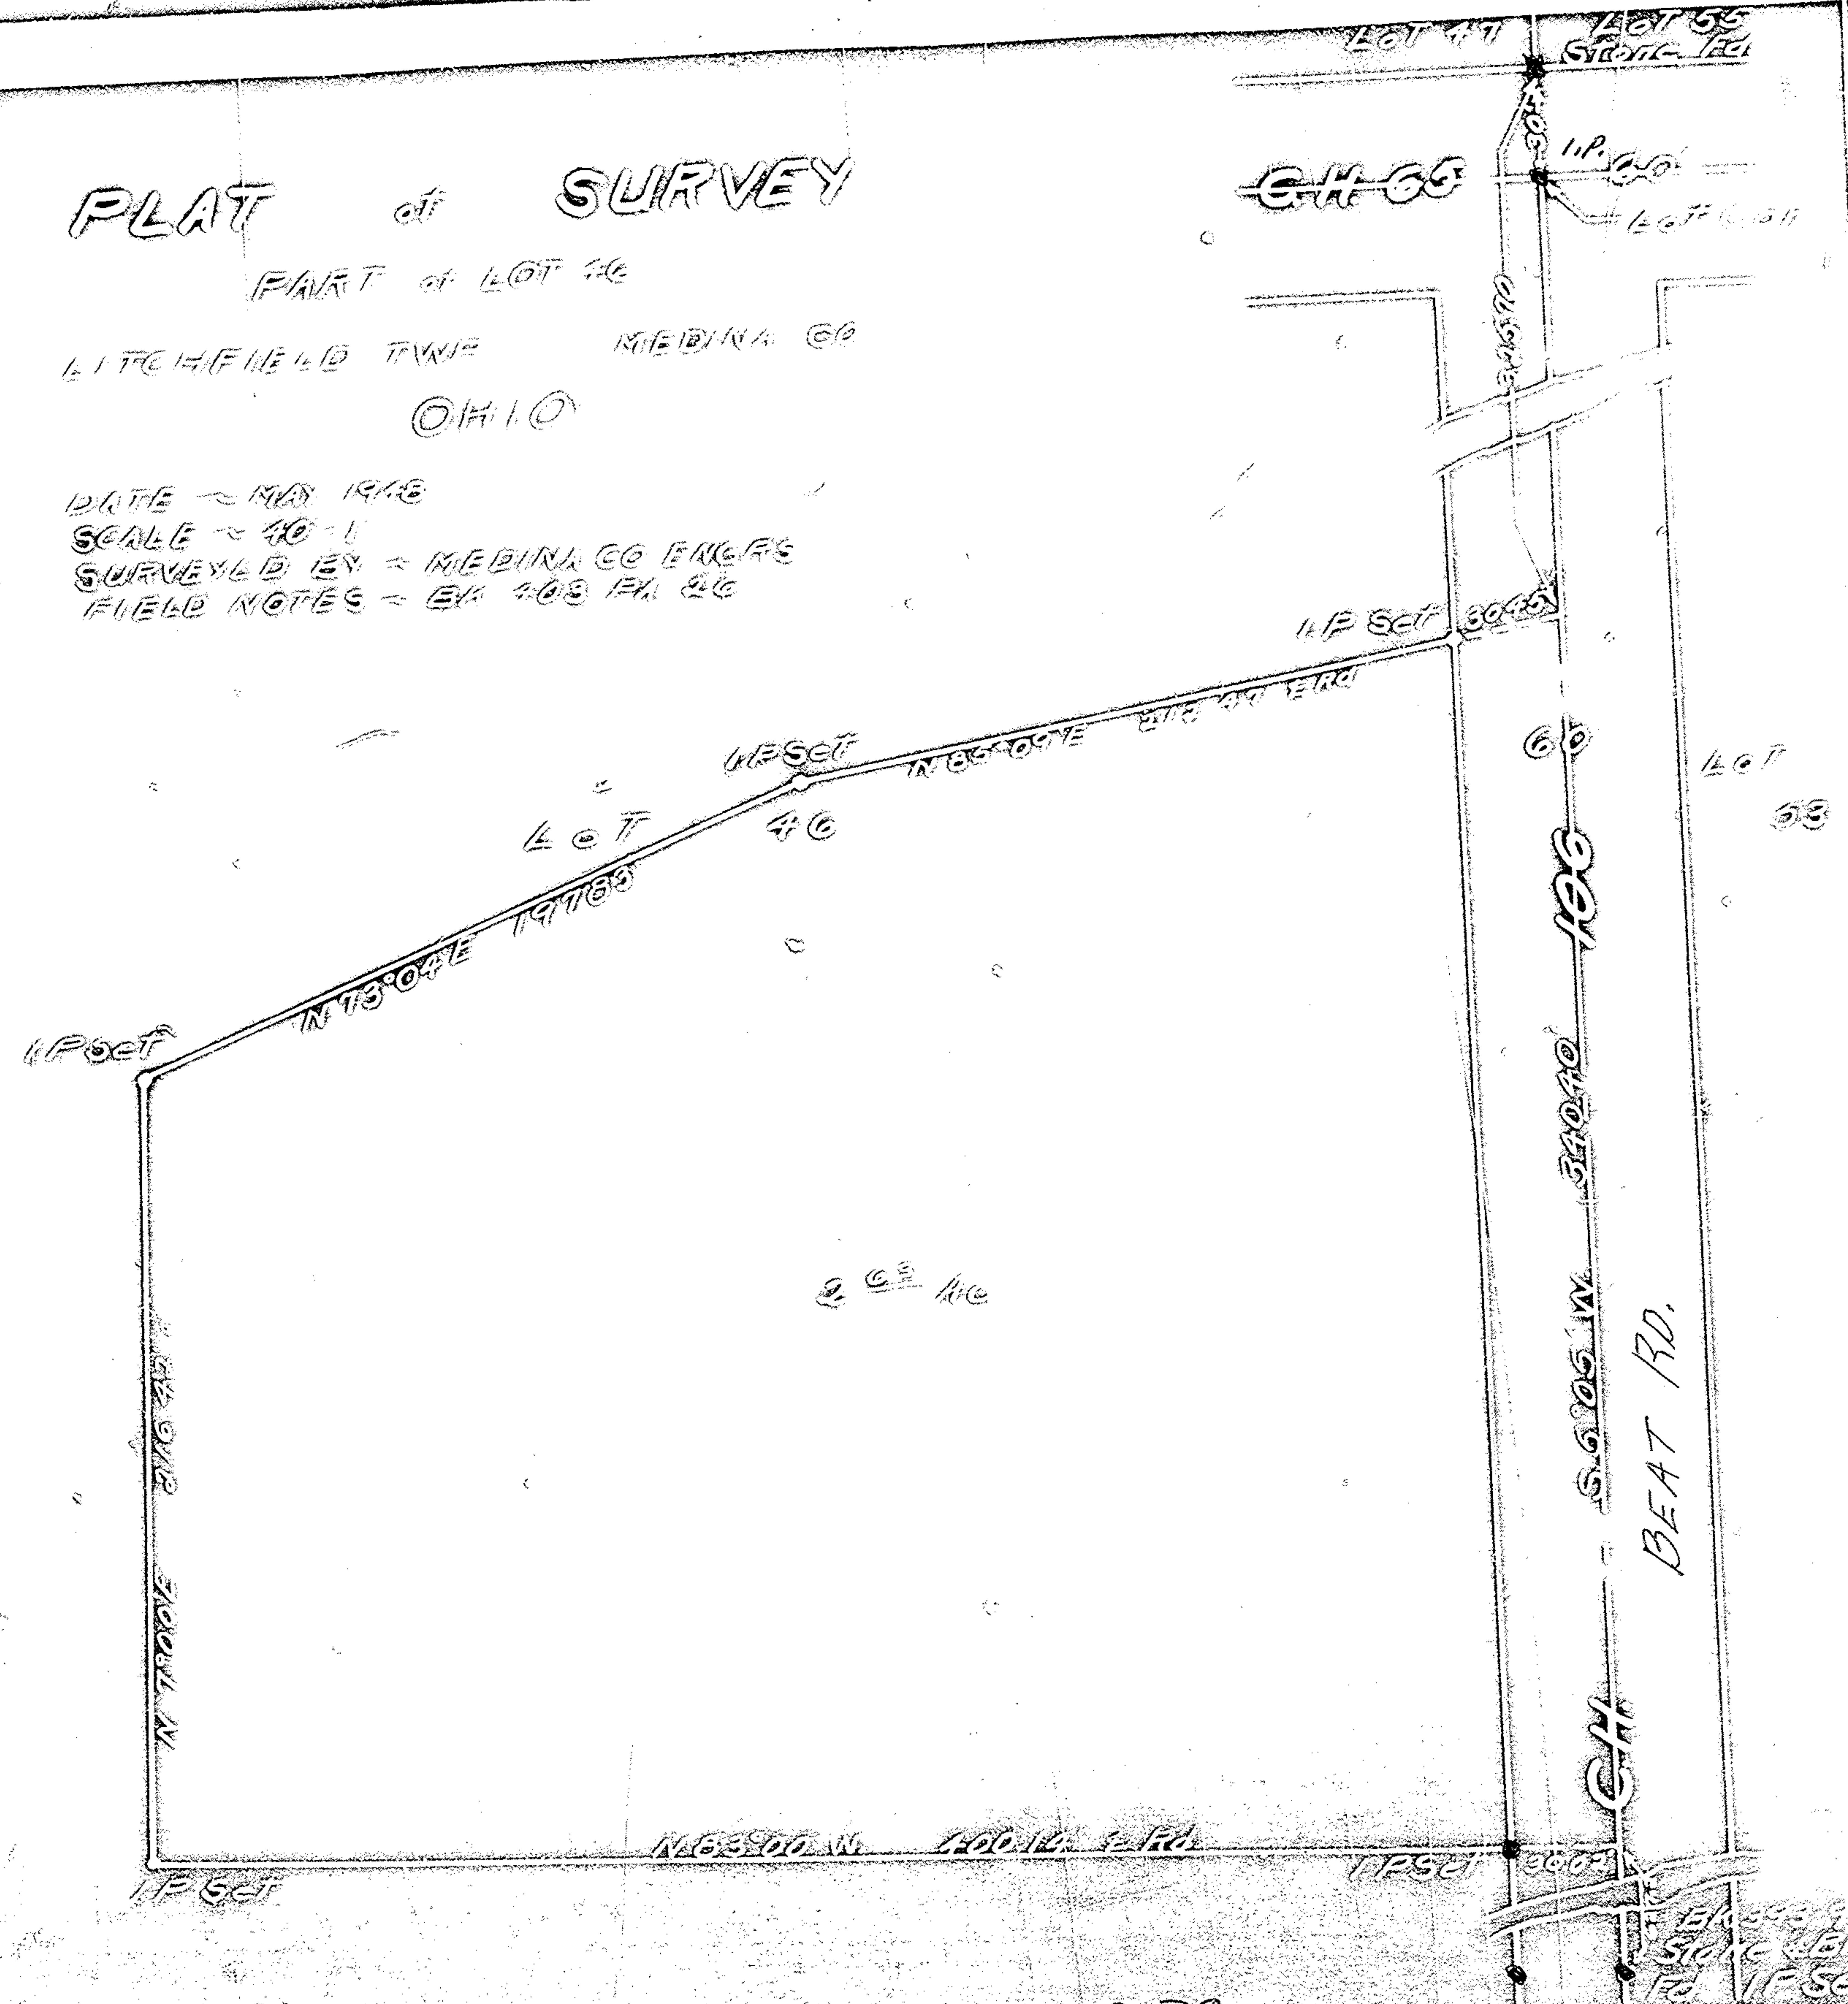

See FB 29-Pg. 79

# 9" File