


RICK DE GAETANO - COMPELLITION ~~CONSENT~~ BLDG. CO

WOOSTER - AVON LAKE ROAD - S.R. 83 (FRS S.R. 76)
(AKA AVON-BELDEN ROAD) 60' R.O.W.

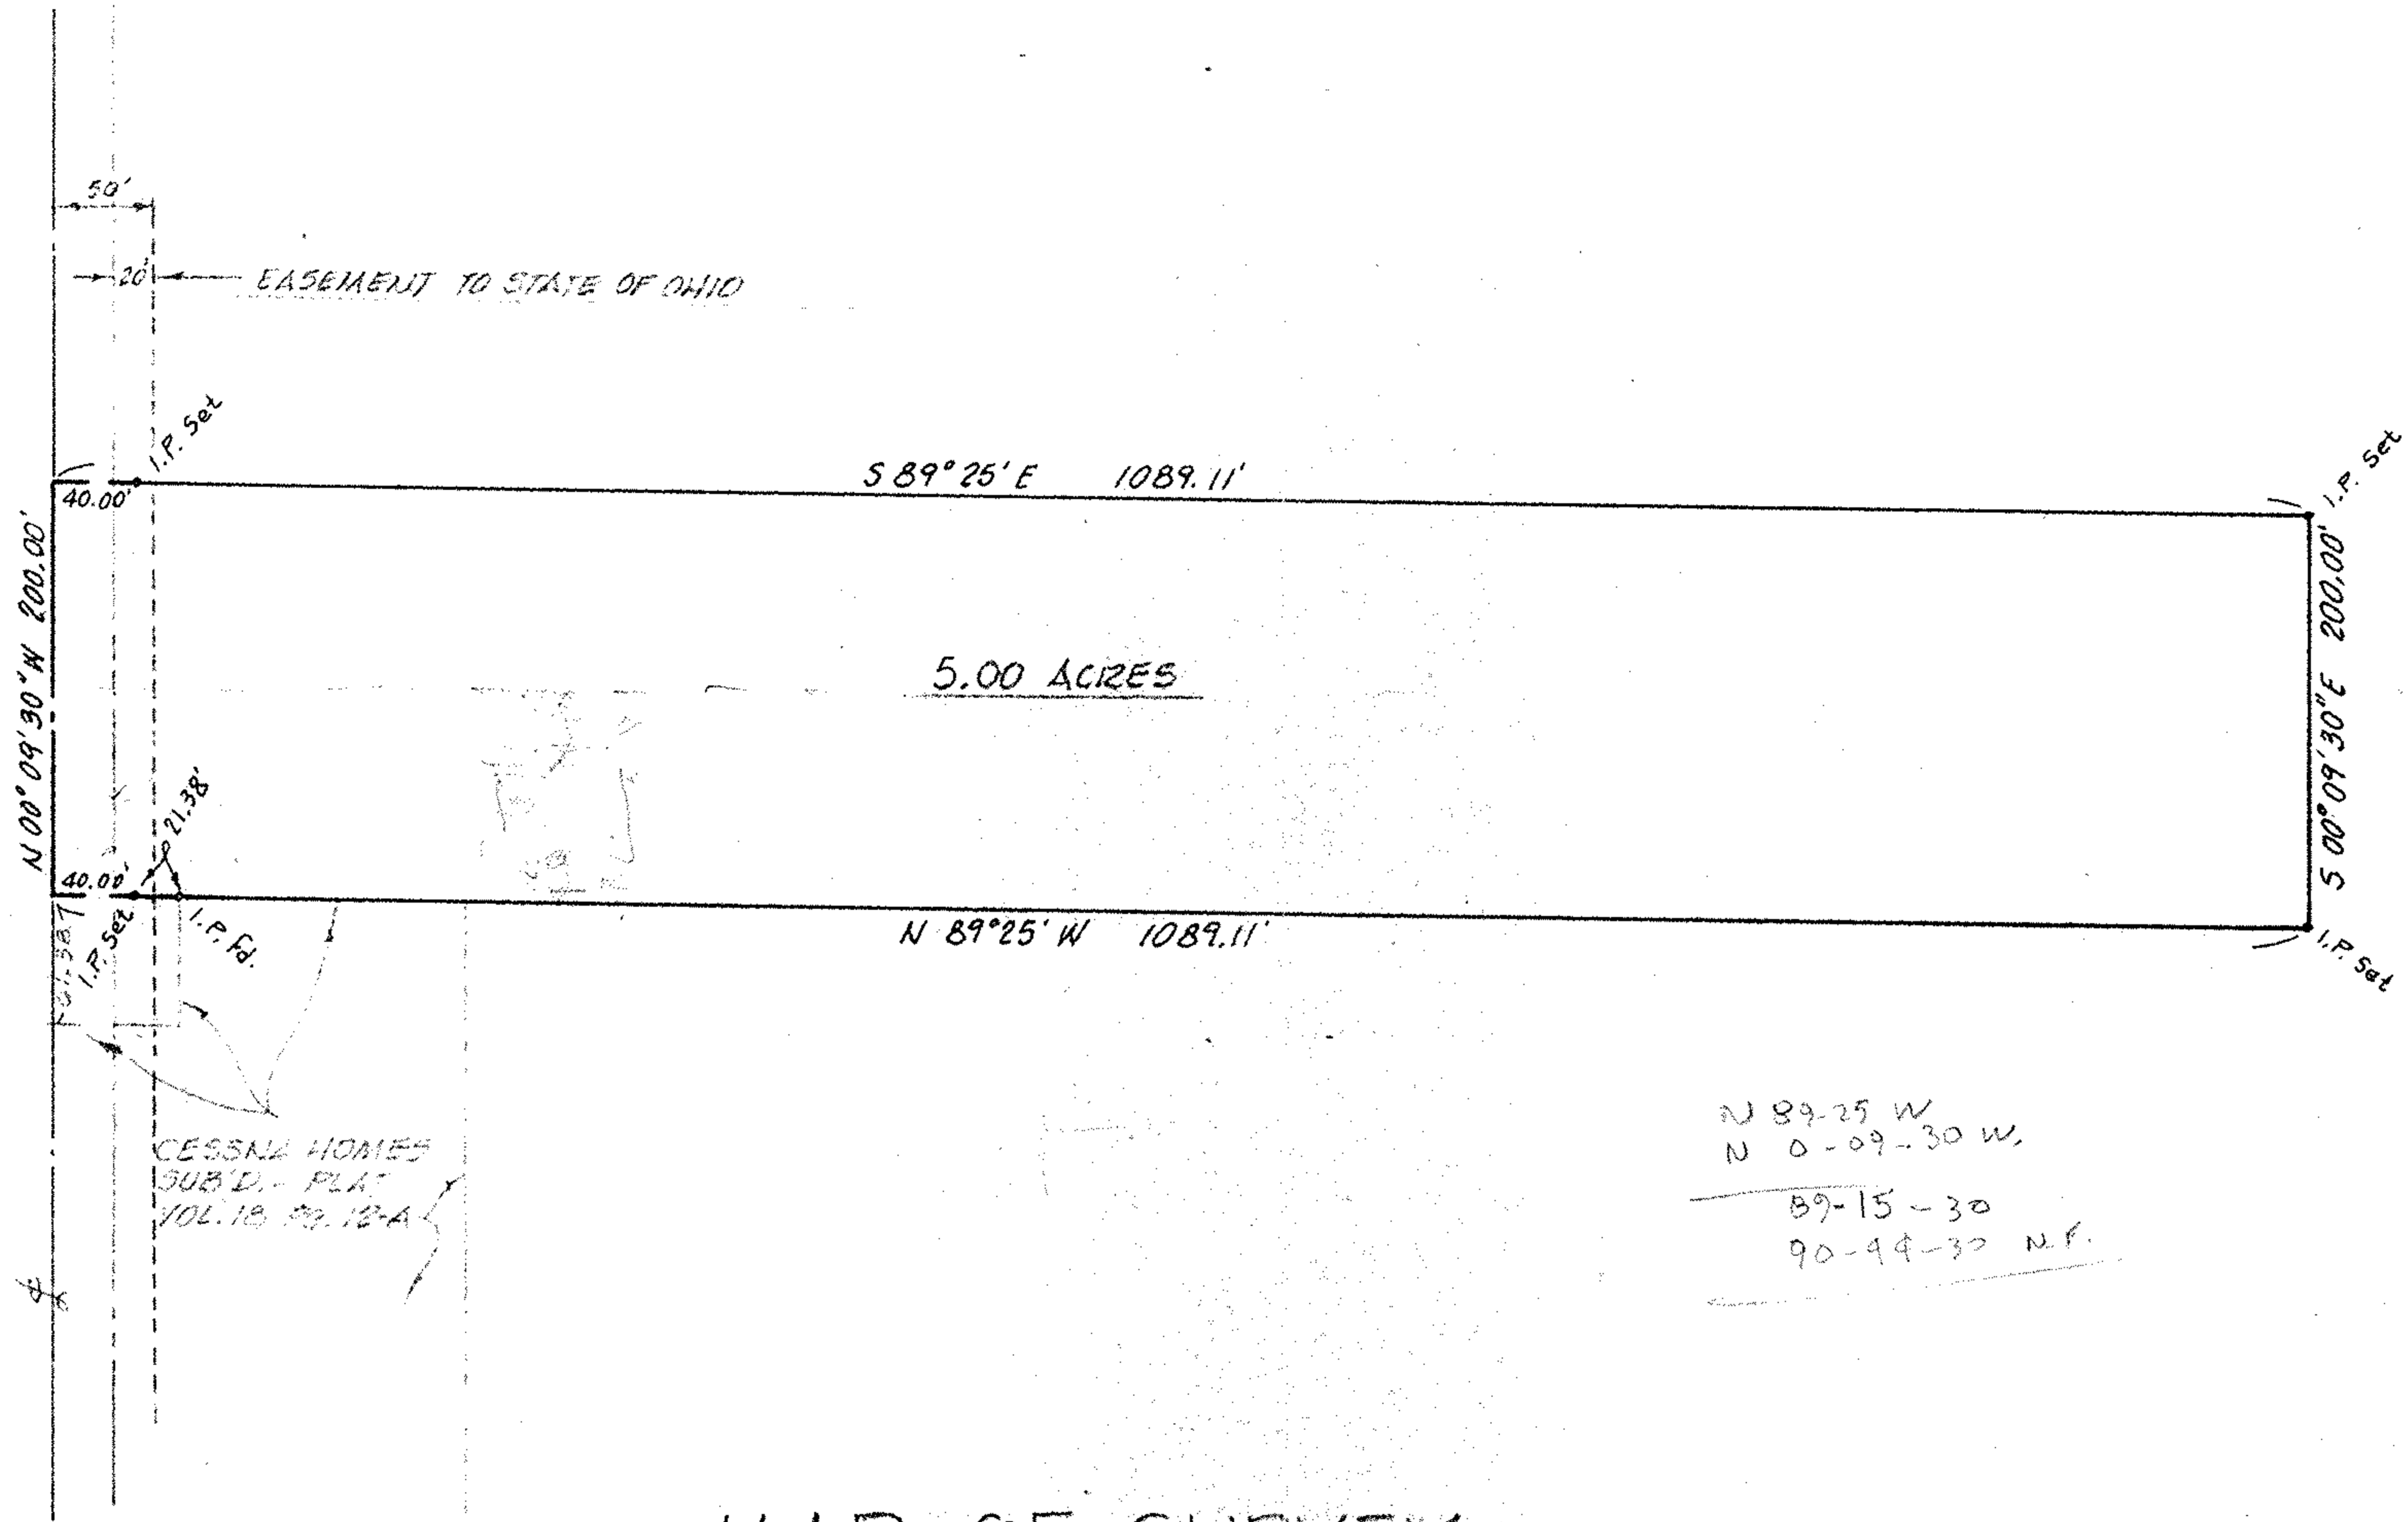

CESSNA HOMES
SUB'D. - PLAT
101.18 89.12-A

N 89-25 W
N 0-09-30 W,
89-15-30
90-44-30 N.F.

MAP OF SURVEY

PART of ORIGINAL LOT No. 48 of EATON TWP.
LORAIN COUNTY OHIO
APRIL 1977



SCALE: 1"=100'



PART OF PERMANENT PARCEL No. 11-00-048-000-001

McGLINCHY and ASSOCIATES
538 WEST BROAD STREET
ELYRIA OHIO 44035
JOB No. 771811