


WOOSTER - AVON LAKE ROAD - S.R. 83 (FKB S.R. 76)
(aka AVON-BELDEN ROAD) 60' E.O.W.

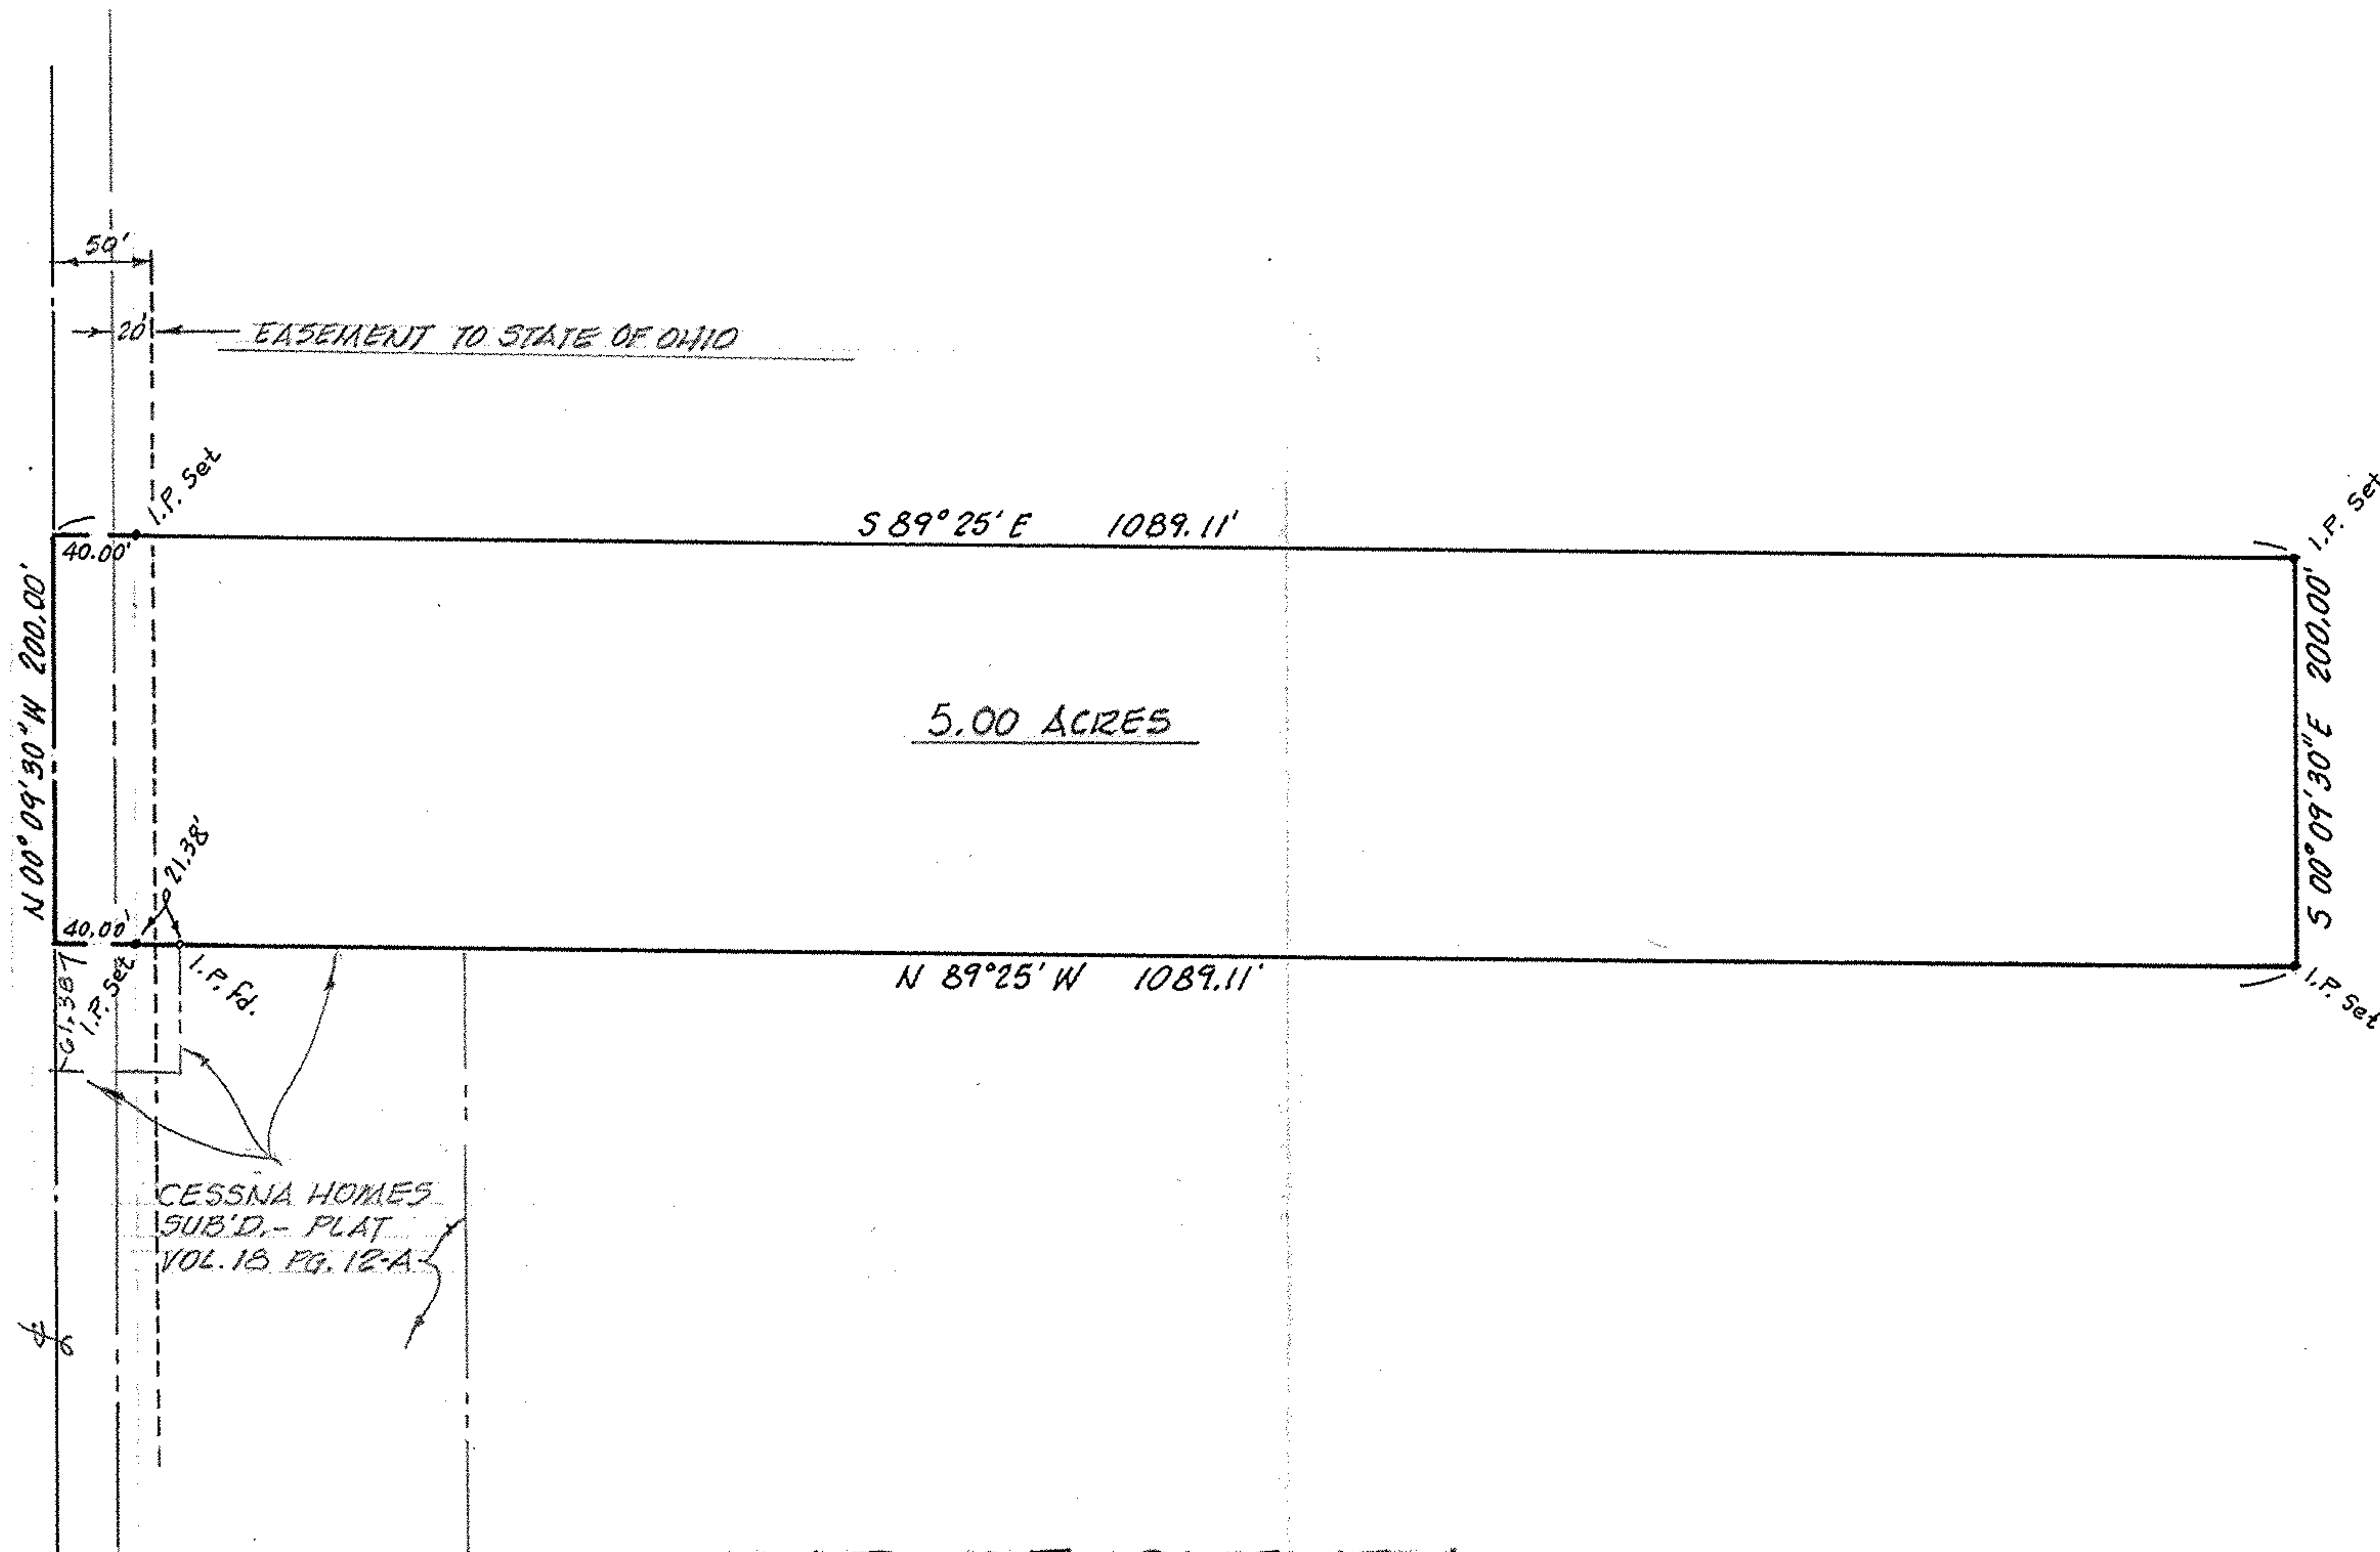


CESSNA HOMES
SUB'D. - PLAT
VOL. 18 PG. 12-A

MAP OF SURVEY

PART of ORIGINAL LOT No. 48 of EATON TWP.
LORAIN COUNTY OHIO
APRIL 1977

PART OF PERMANENT PARCEL No. 11-00-048-000-001

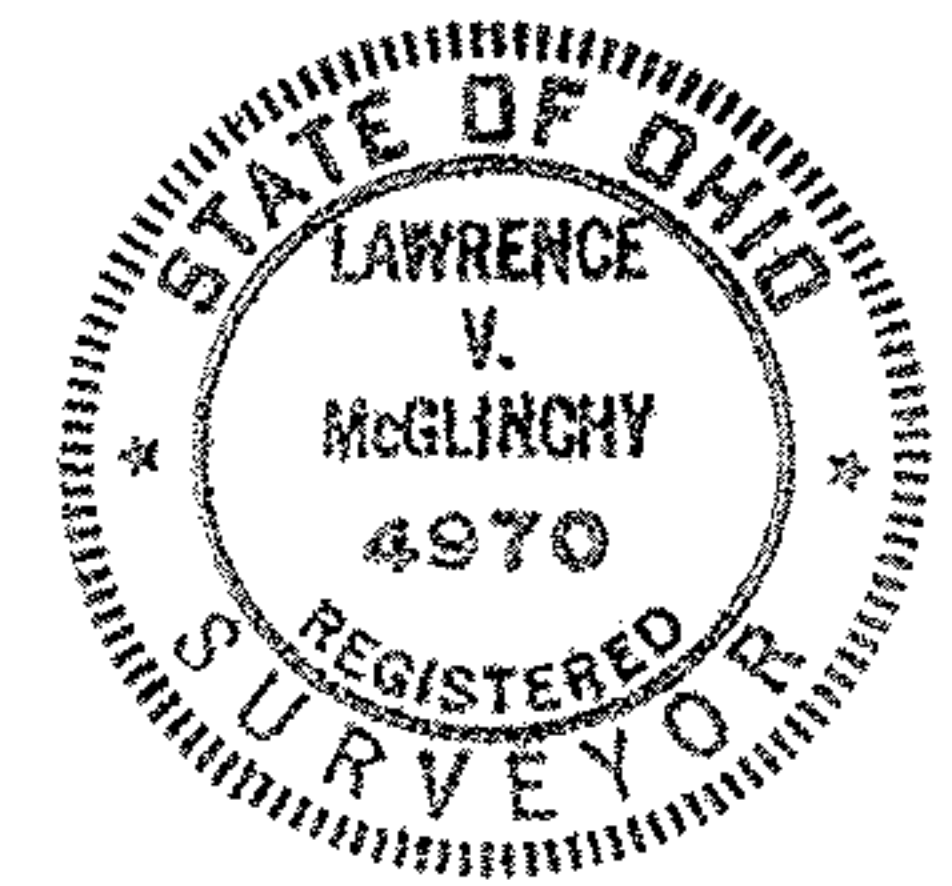

SCALE: 1" = 100'

McGLINCHY and ASSOCIATES
538 WEST BROAD STREET
ELYRIA OHIO 44035
JOB No. 771811