


NORTH
SCALE: 1"=40'

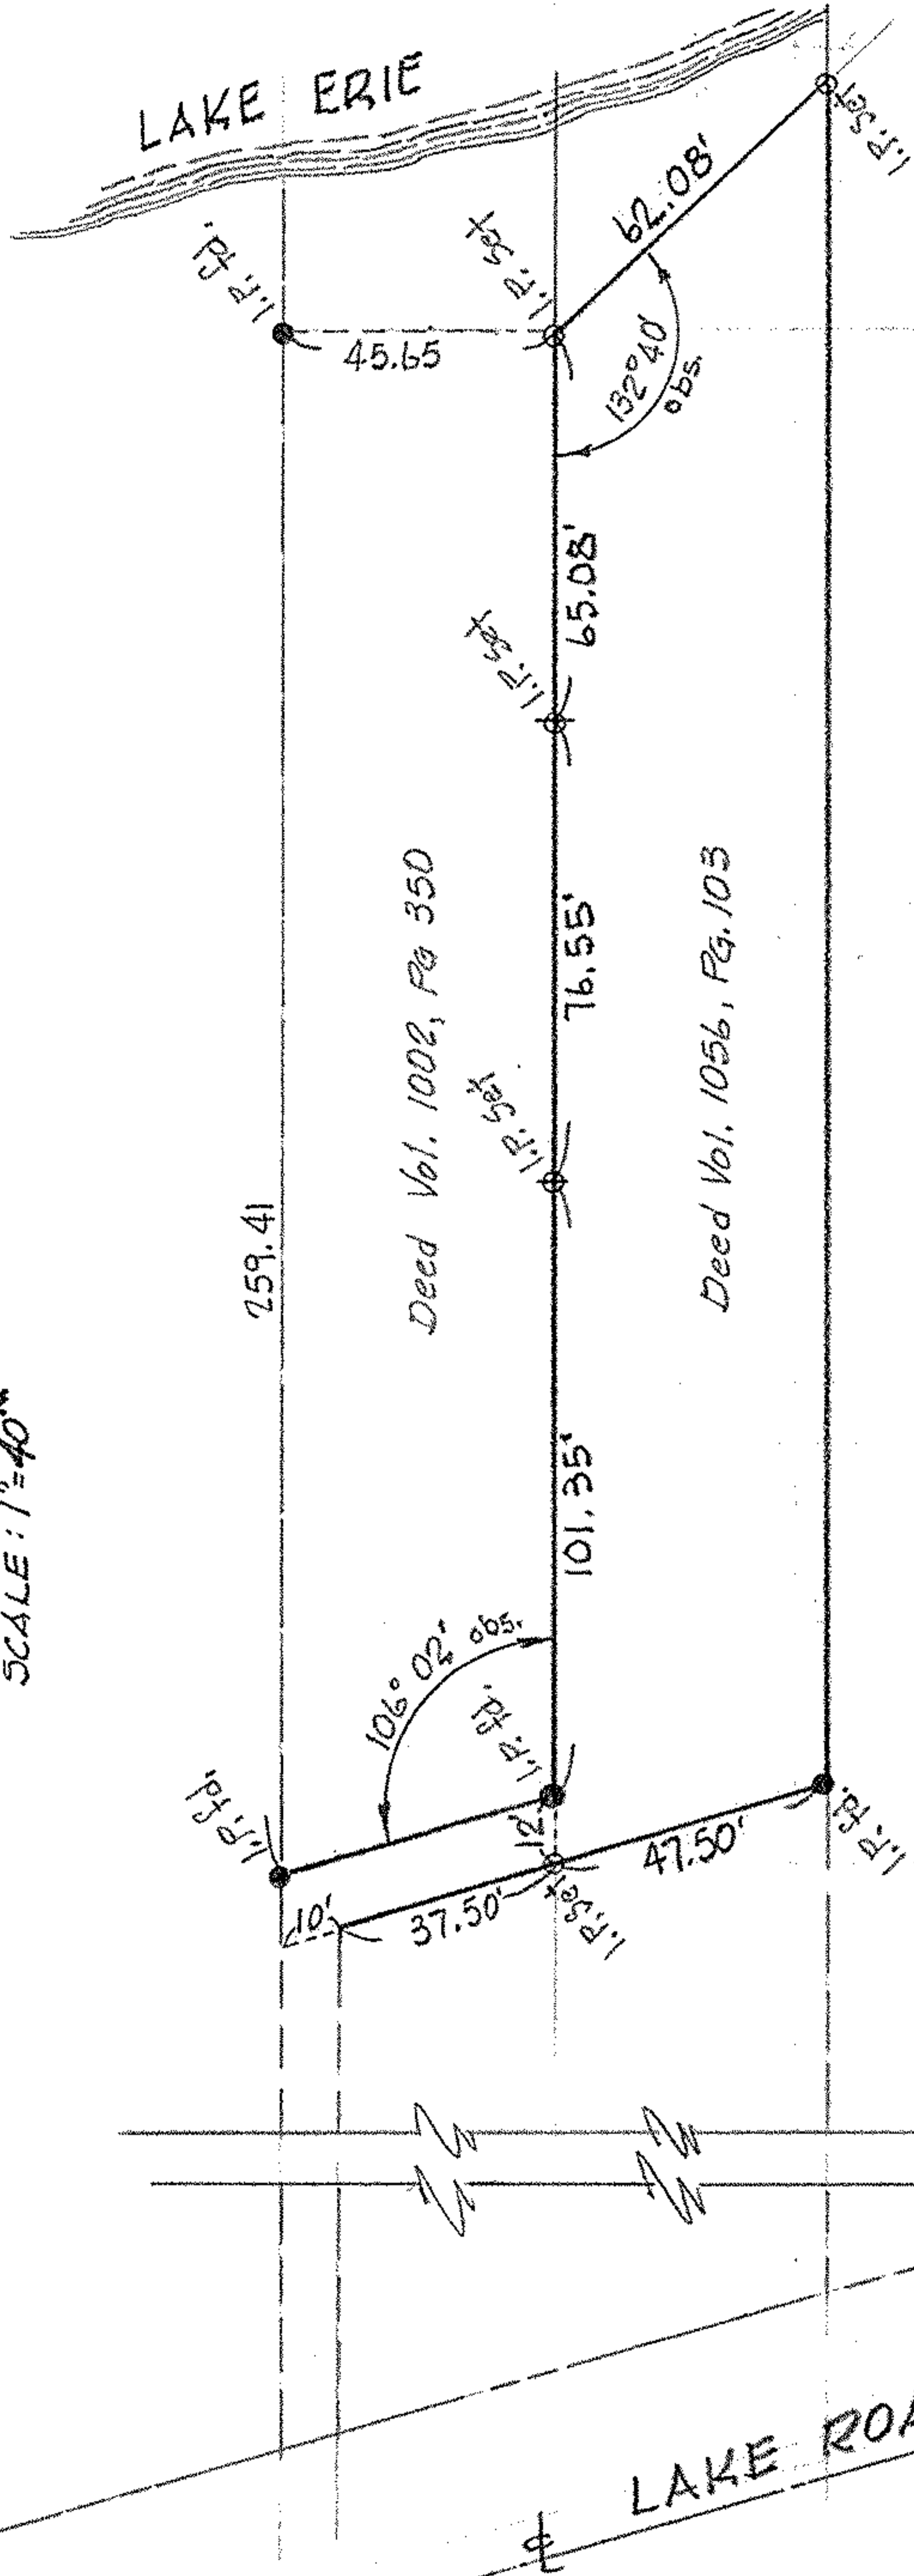

MAP of SURVEY

for
JON CURTIS

PART of ORIG. SHEFFIELD TWP LOT 33
CITY of SHEFFIELD LAKE, LORAIN CO., OHIO

PART P.P. # 03-00-033-101-023

McGLINCHY and ASSOCIATES
PROFESSIONAL ENGINEERS & SURVEYORS
ELYRIA
OHIO
APRIL, 1978
JOB # 783210