


YORKSHIRE CT. 40'

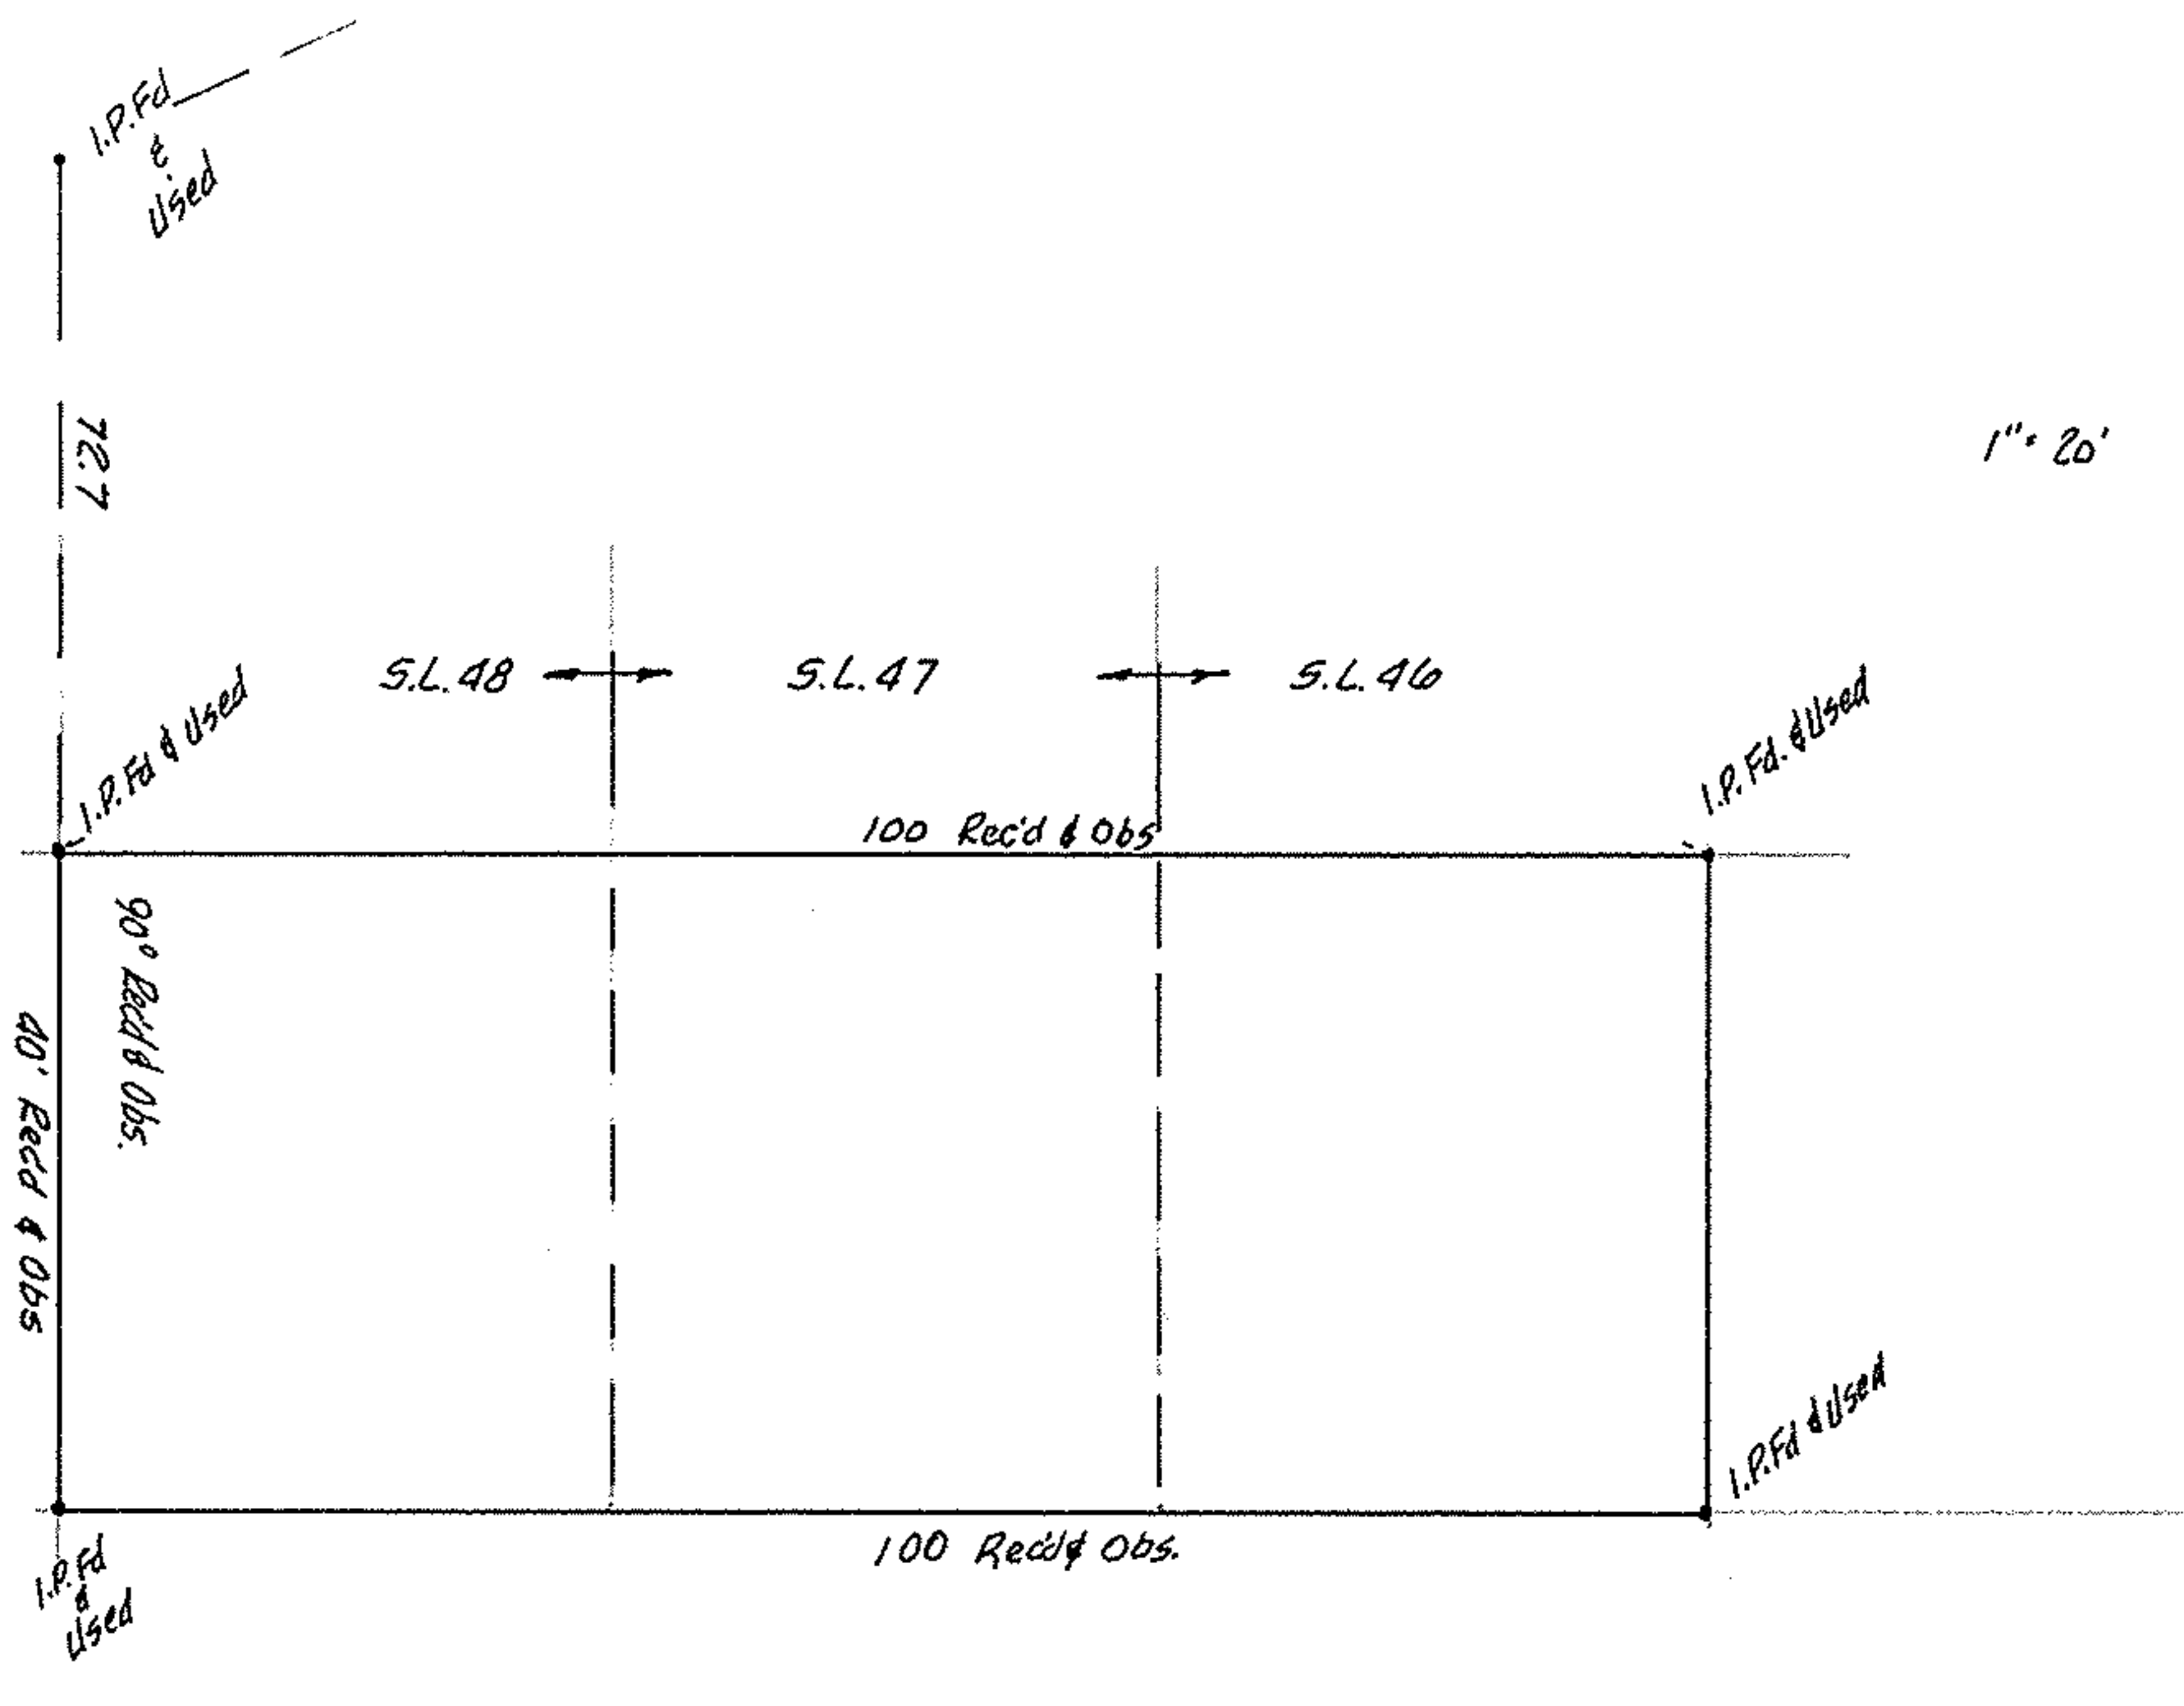

MAP of SURVEY
106 YORKSHIRE CT.
ELYRIA, OHIO

WILLIAM A. & DOLORES PEAT
DEED VOL 665 PAGE 309

P.P. # 06-25-012-103-006
PART of SUBLOTS 46, 47 & 48 of ABBEY ALLOTMENT
PLAT VOL. 10, PAGE 1 - PART of ORIG. ELYRIA TWP.
LOT 12, EAST of BLACK RIVER - NOW in CITY of ELYRIA, OHIO

REGISTERED SURVEYORS & ENGINEERS
MCGLINCHY & ASSOCIATES
OCT. 1978 #784206
CTIC # E176,454