


S 89°50' E 299.99'

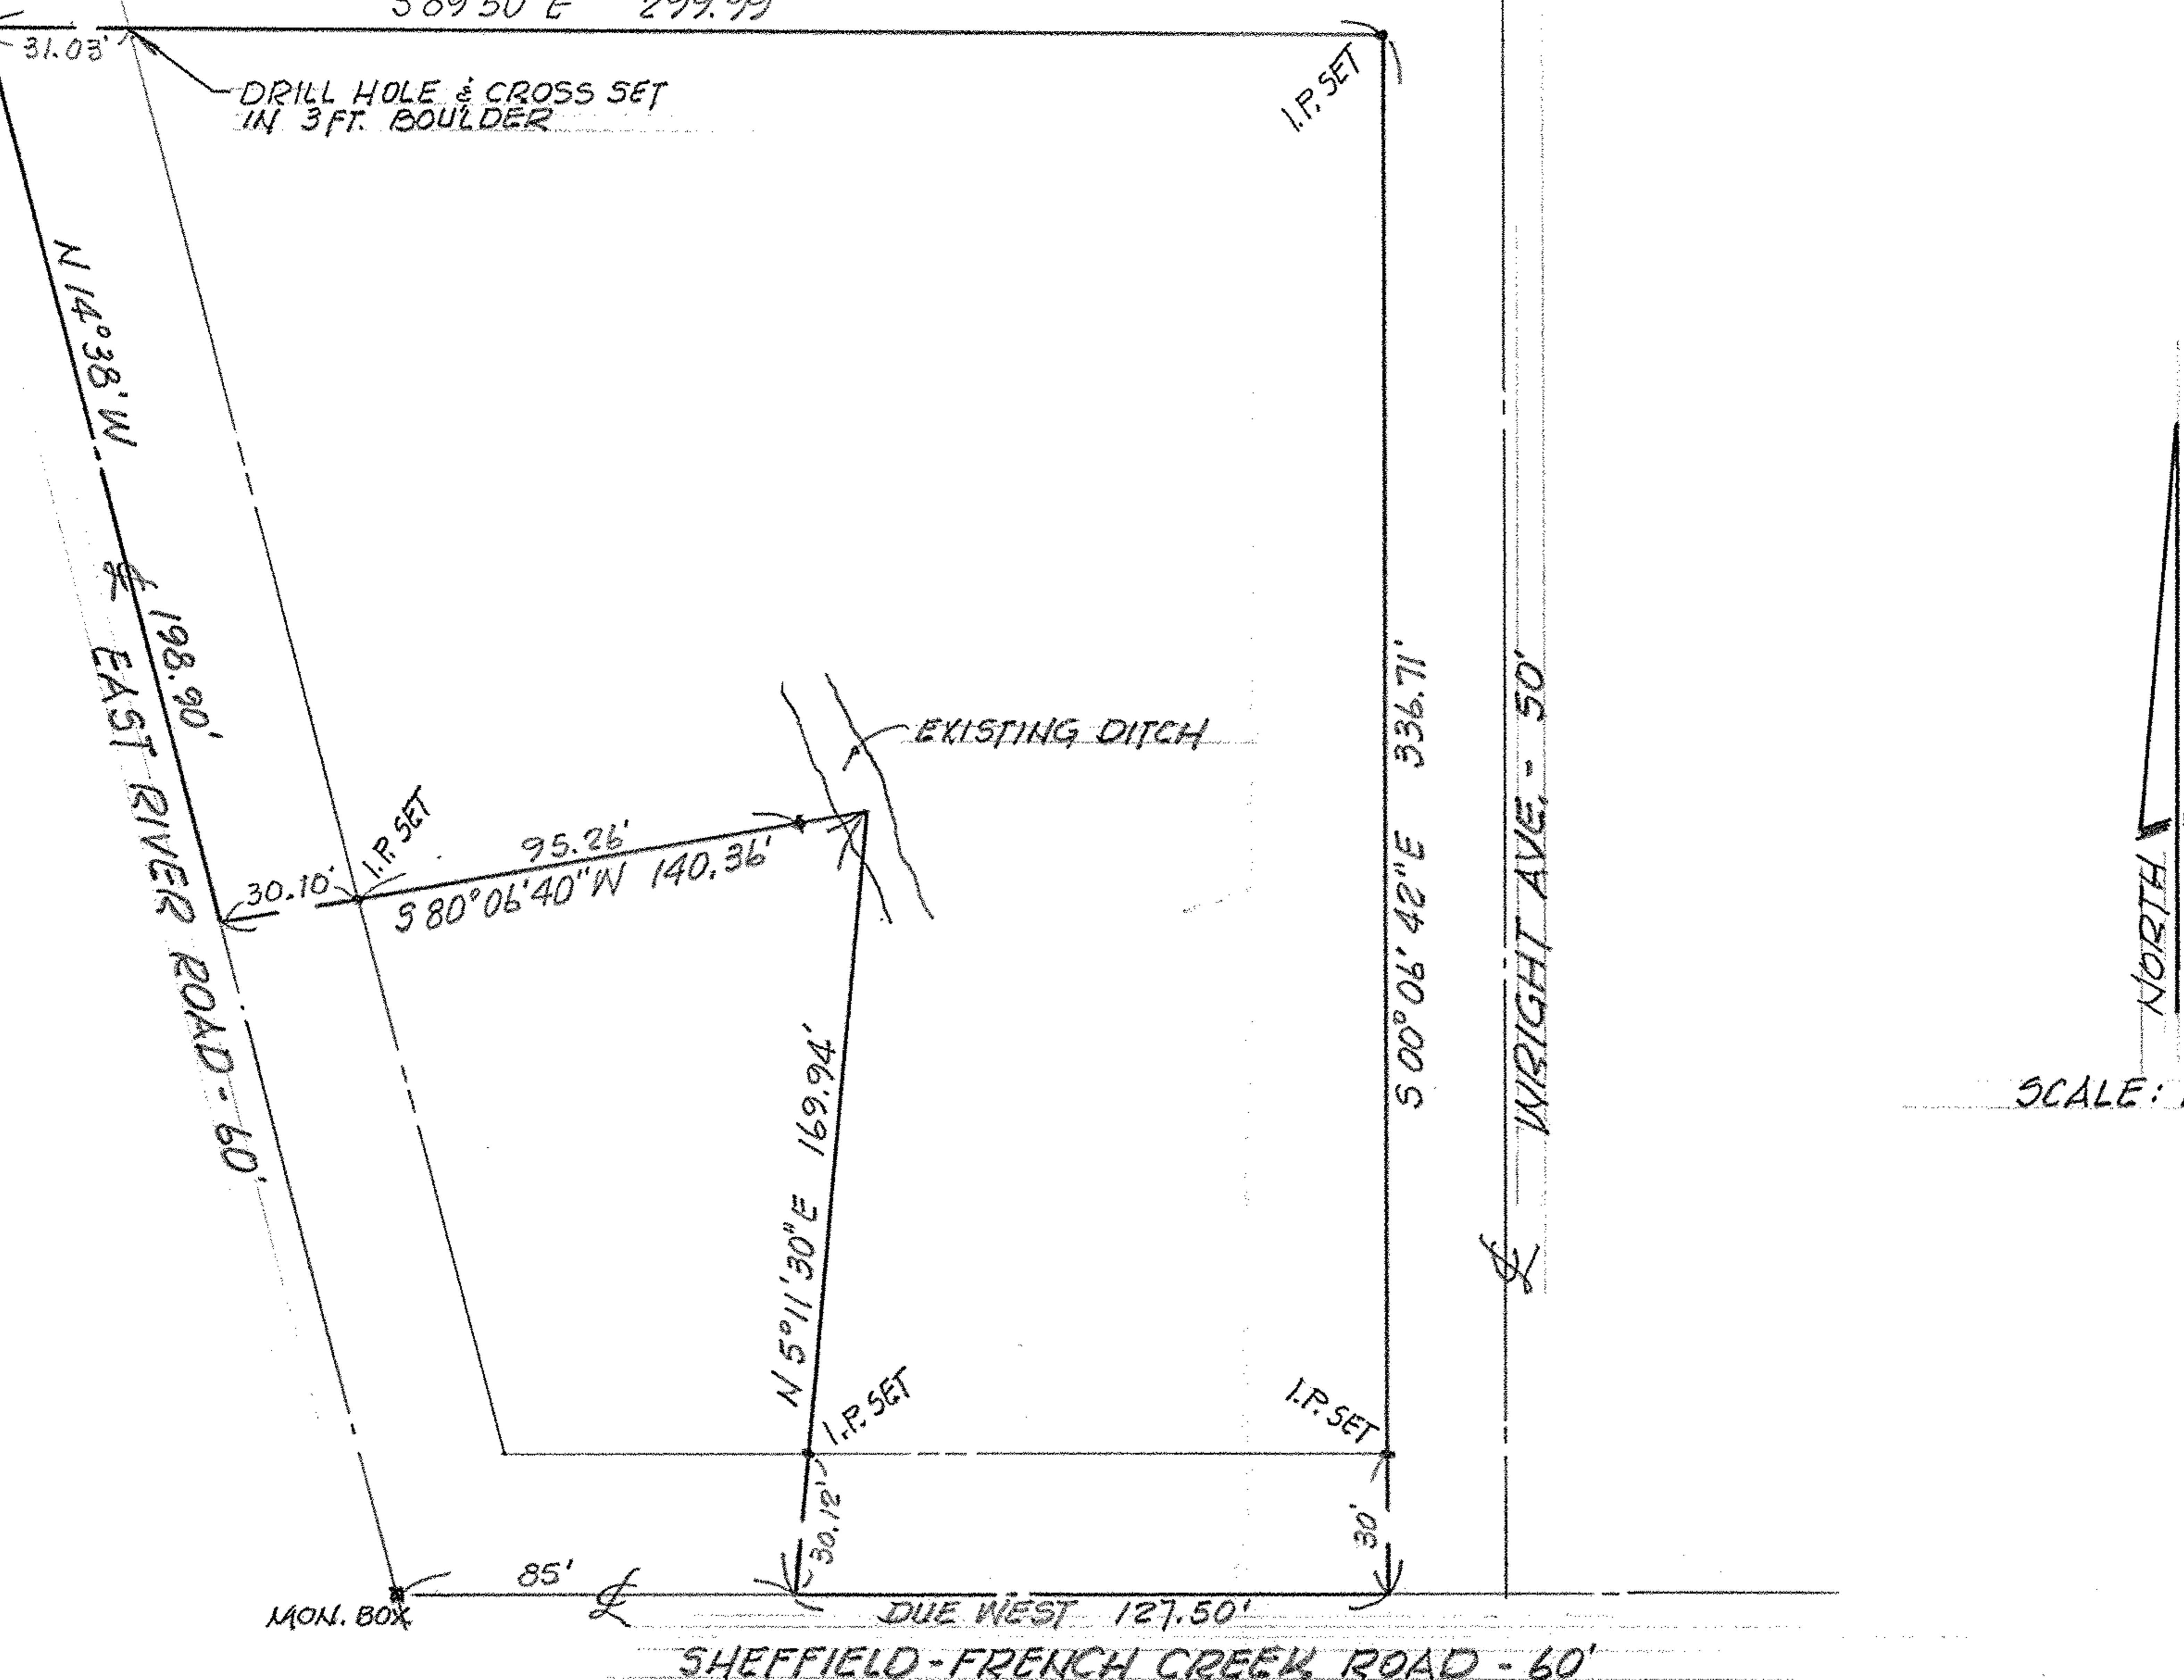

MAP of SURVEY

PREPARED FOR HILDA MULERO et al.

PART of ORIGINAL SHEFFIELD TWP. LOT No. 66
VILLAGE of SHEFFIELD, LORAIN COUNTY, OHIO

MCGLINCHY and ASSOCIATES
PROFESSIONAL ENGINEER & SURVEYORS
ELYRIA,
OHIO
AUGUST 1978
783743