




SCALE: 1" = 20'

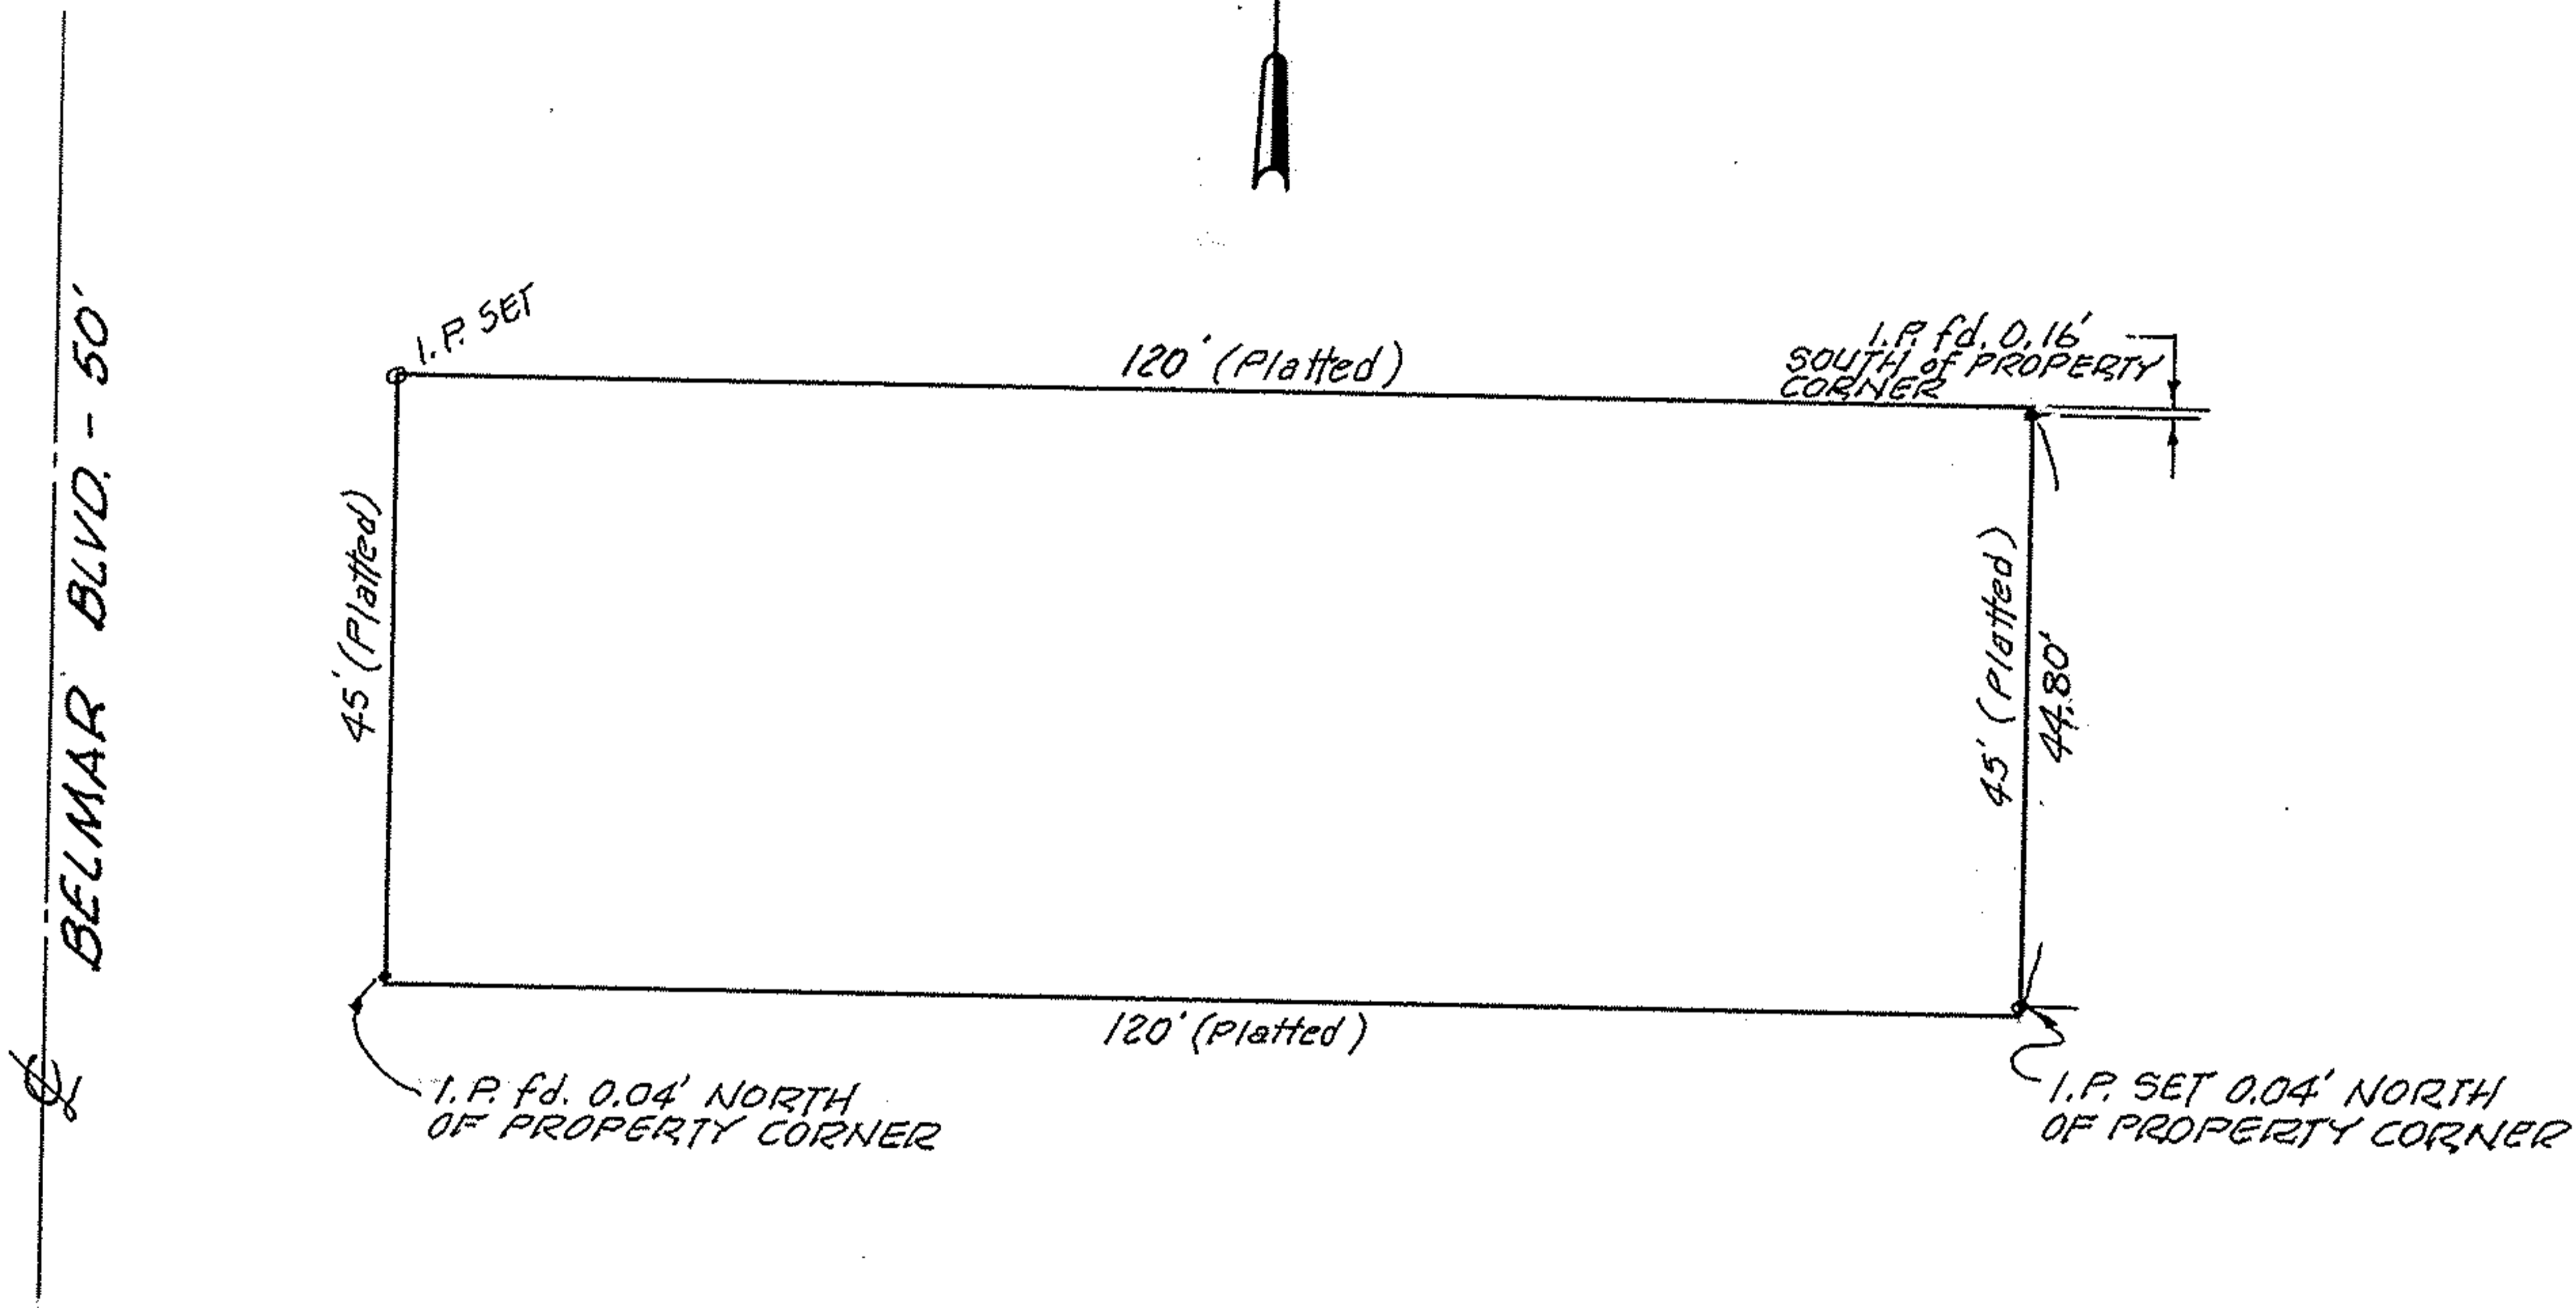

MAP of SURVEY

for RUTH ANN MILES

SUBLOT 290 of BELMAR BEACH SUB'D.
PART of ORIG. AVON TWP. SECTION 7
CITY of AVON LAKE, LORAIN CO., OHIO

McGLINCHY & ASSOCIATES
ELYRIA OHIO
JULY 1978 #783659