


W. 12th STREET - 66' (FKA FIFTH AVE.)

HAMILTON AVENUE - 60' (FKA HARRISON ST.)



SCALE: 1" = 20'

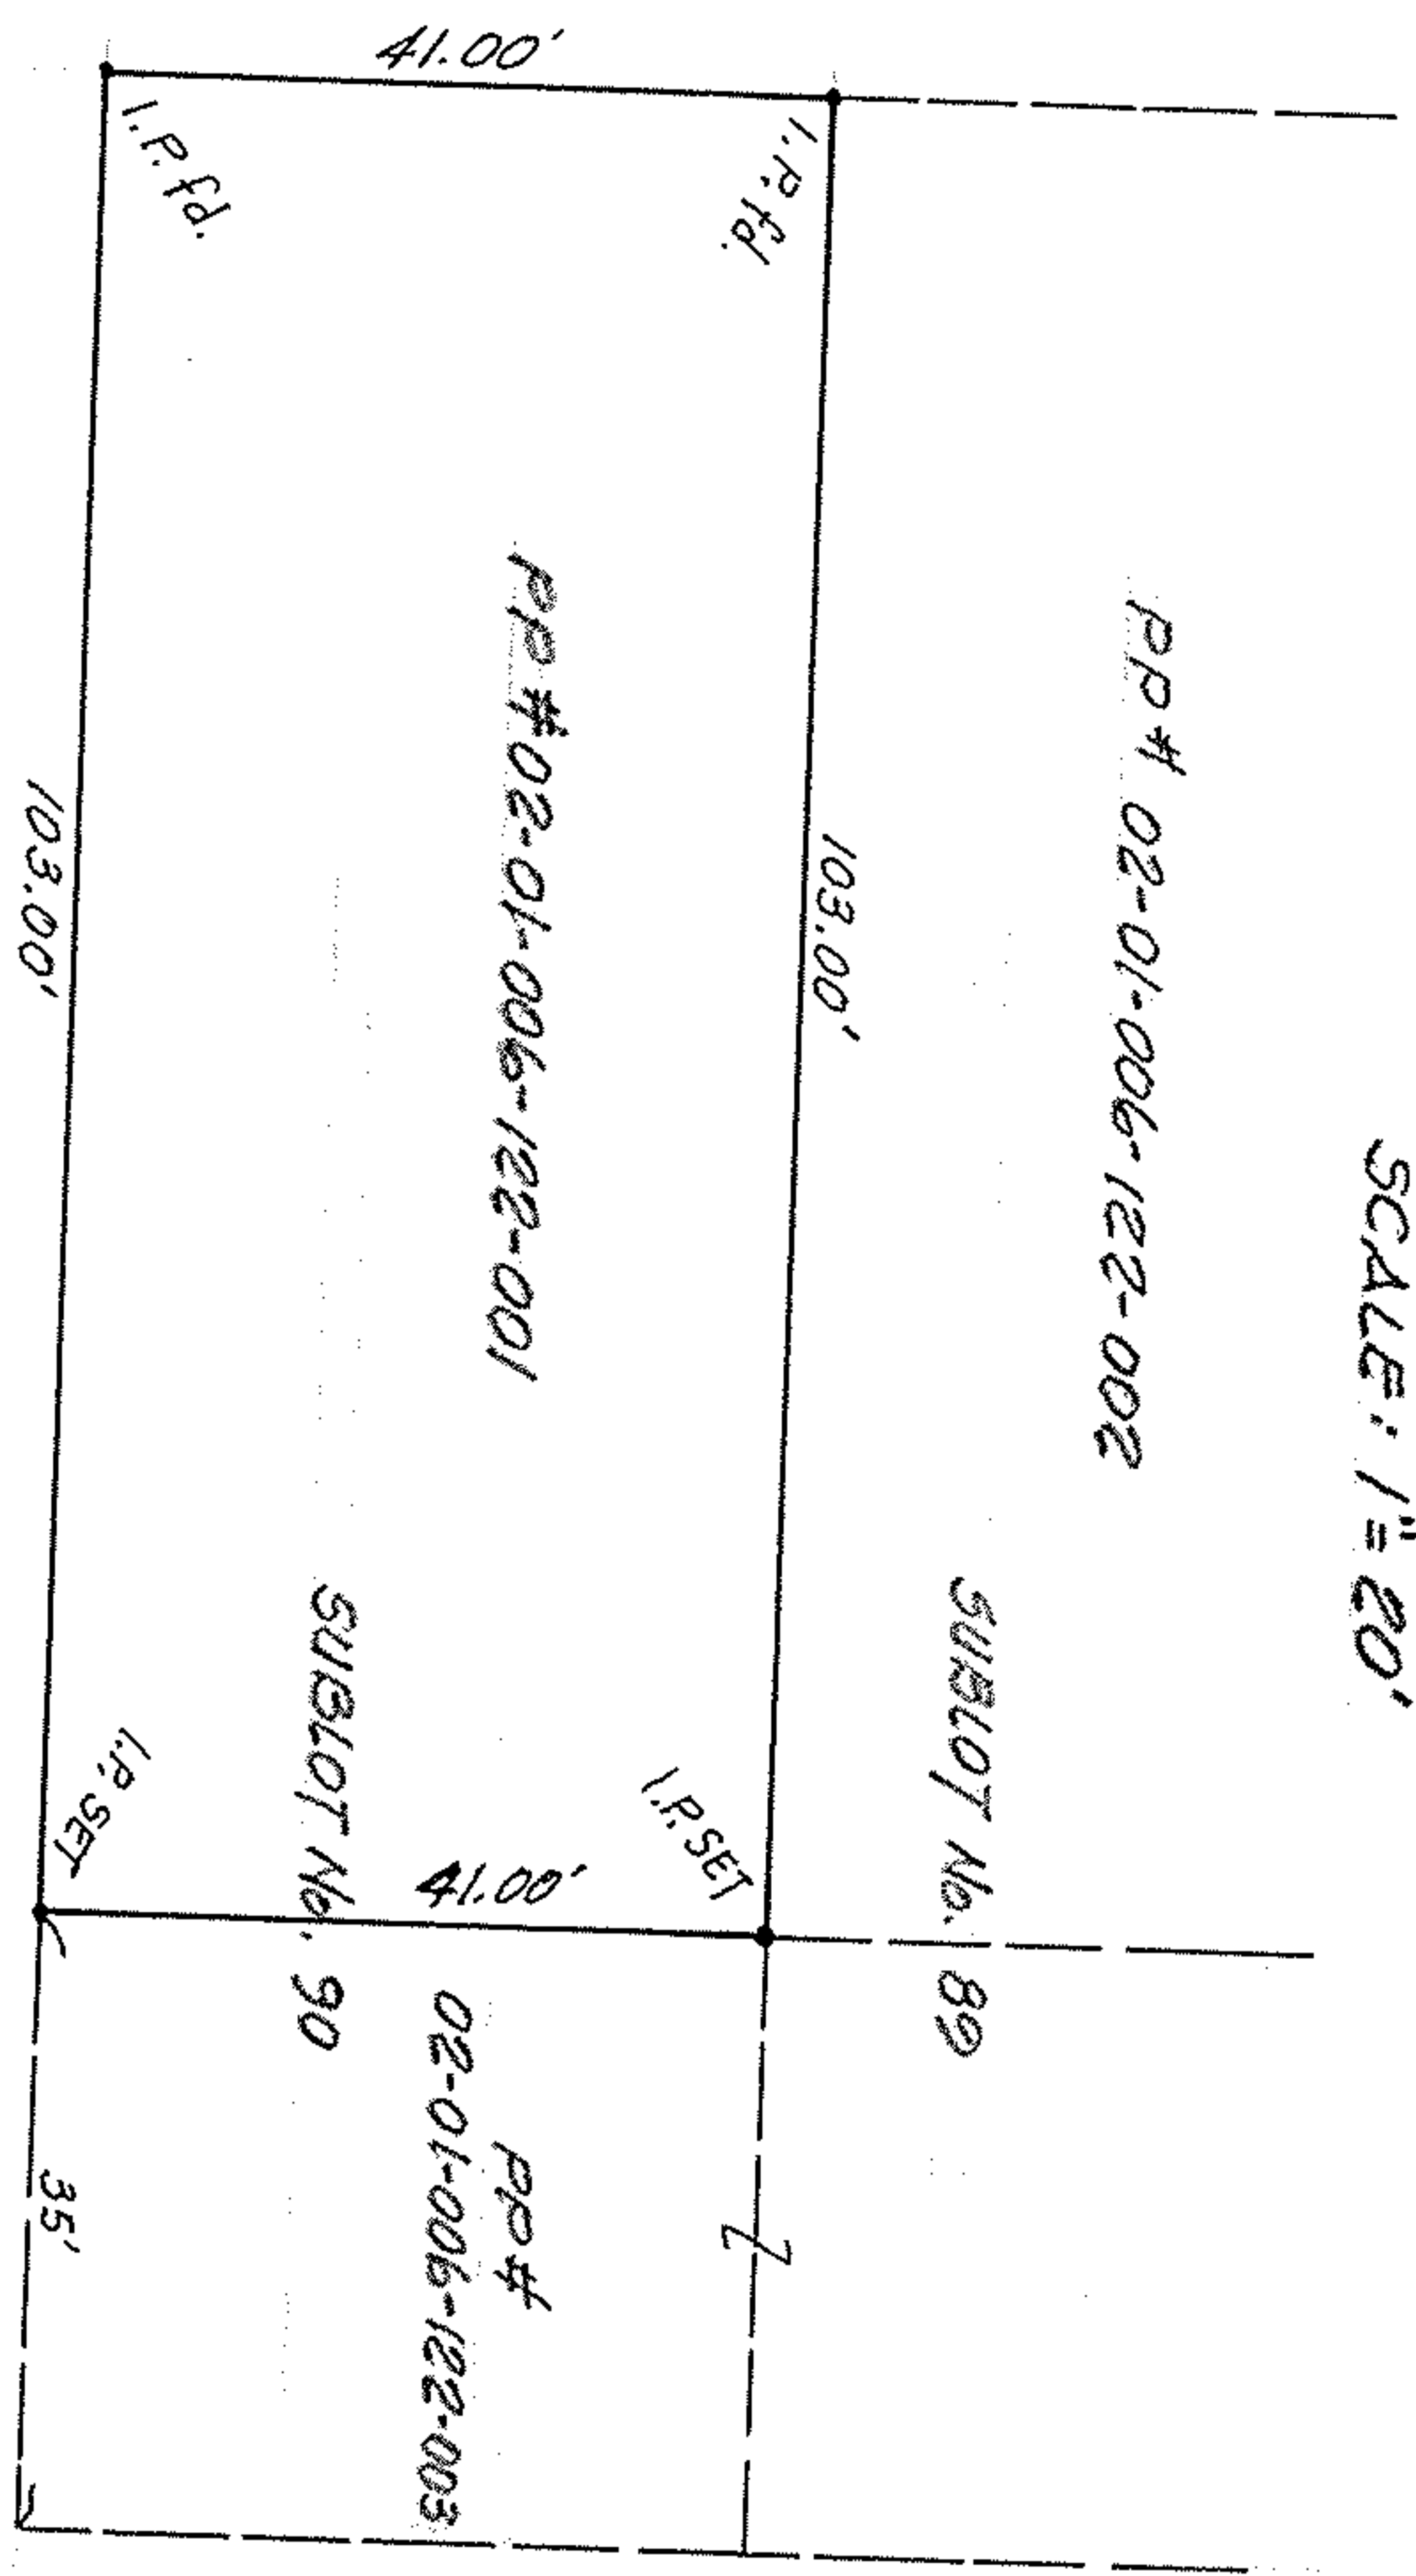

MAP of SURVEY
PREPARED FOR ROSE OLSEN

PART of SUBLOT 90 in E.R. PERKINS TRUSTEE
ADDITION - PLAT VOL. 7 PG. 21 - & PART of
ORIGINAL BLAIR RIVER TWP. LOT 6, TRACT 1
CITY of LORAIN, LORAIN COUNTY, OHIO

McGLINCHY & ASSOCIATES
PROFESSIONAL ENGINEER & SURVEYORS
ELIZIA
AUGUST, 1978
OHIO
#783944