


1"=20'

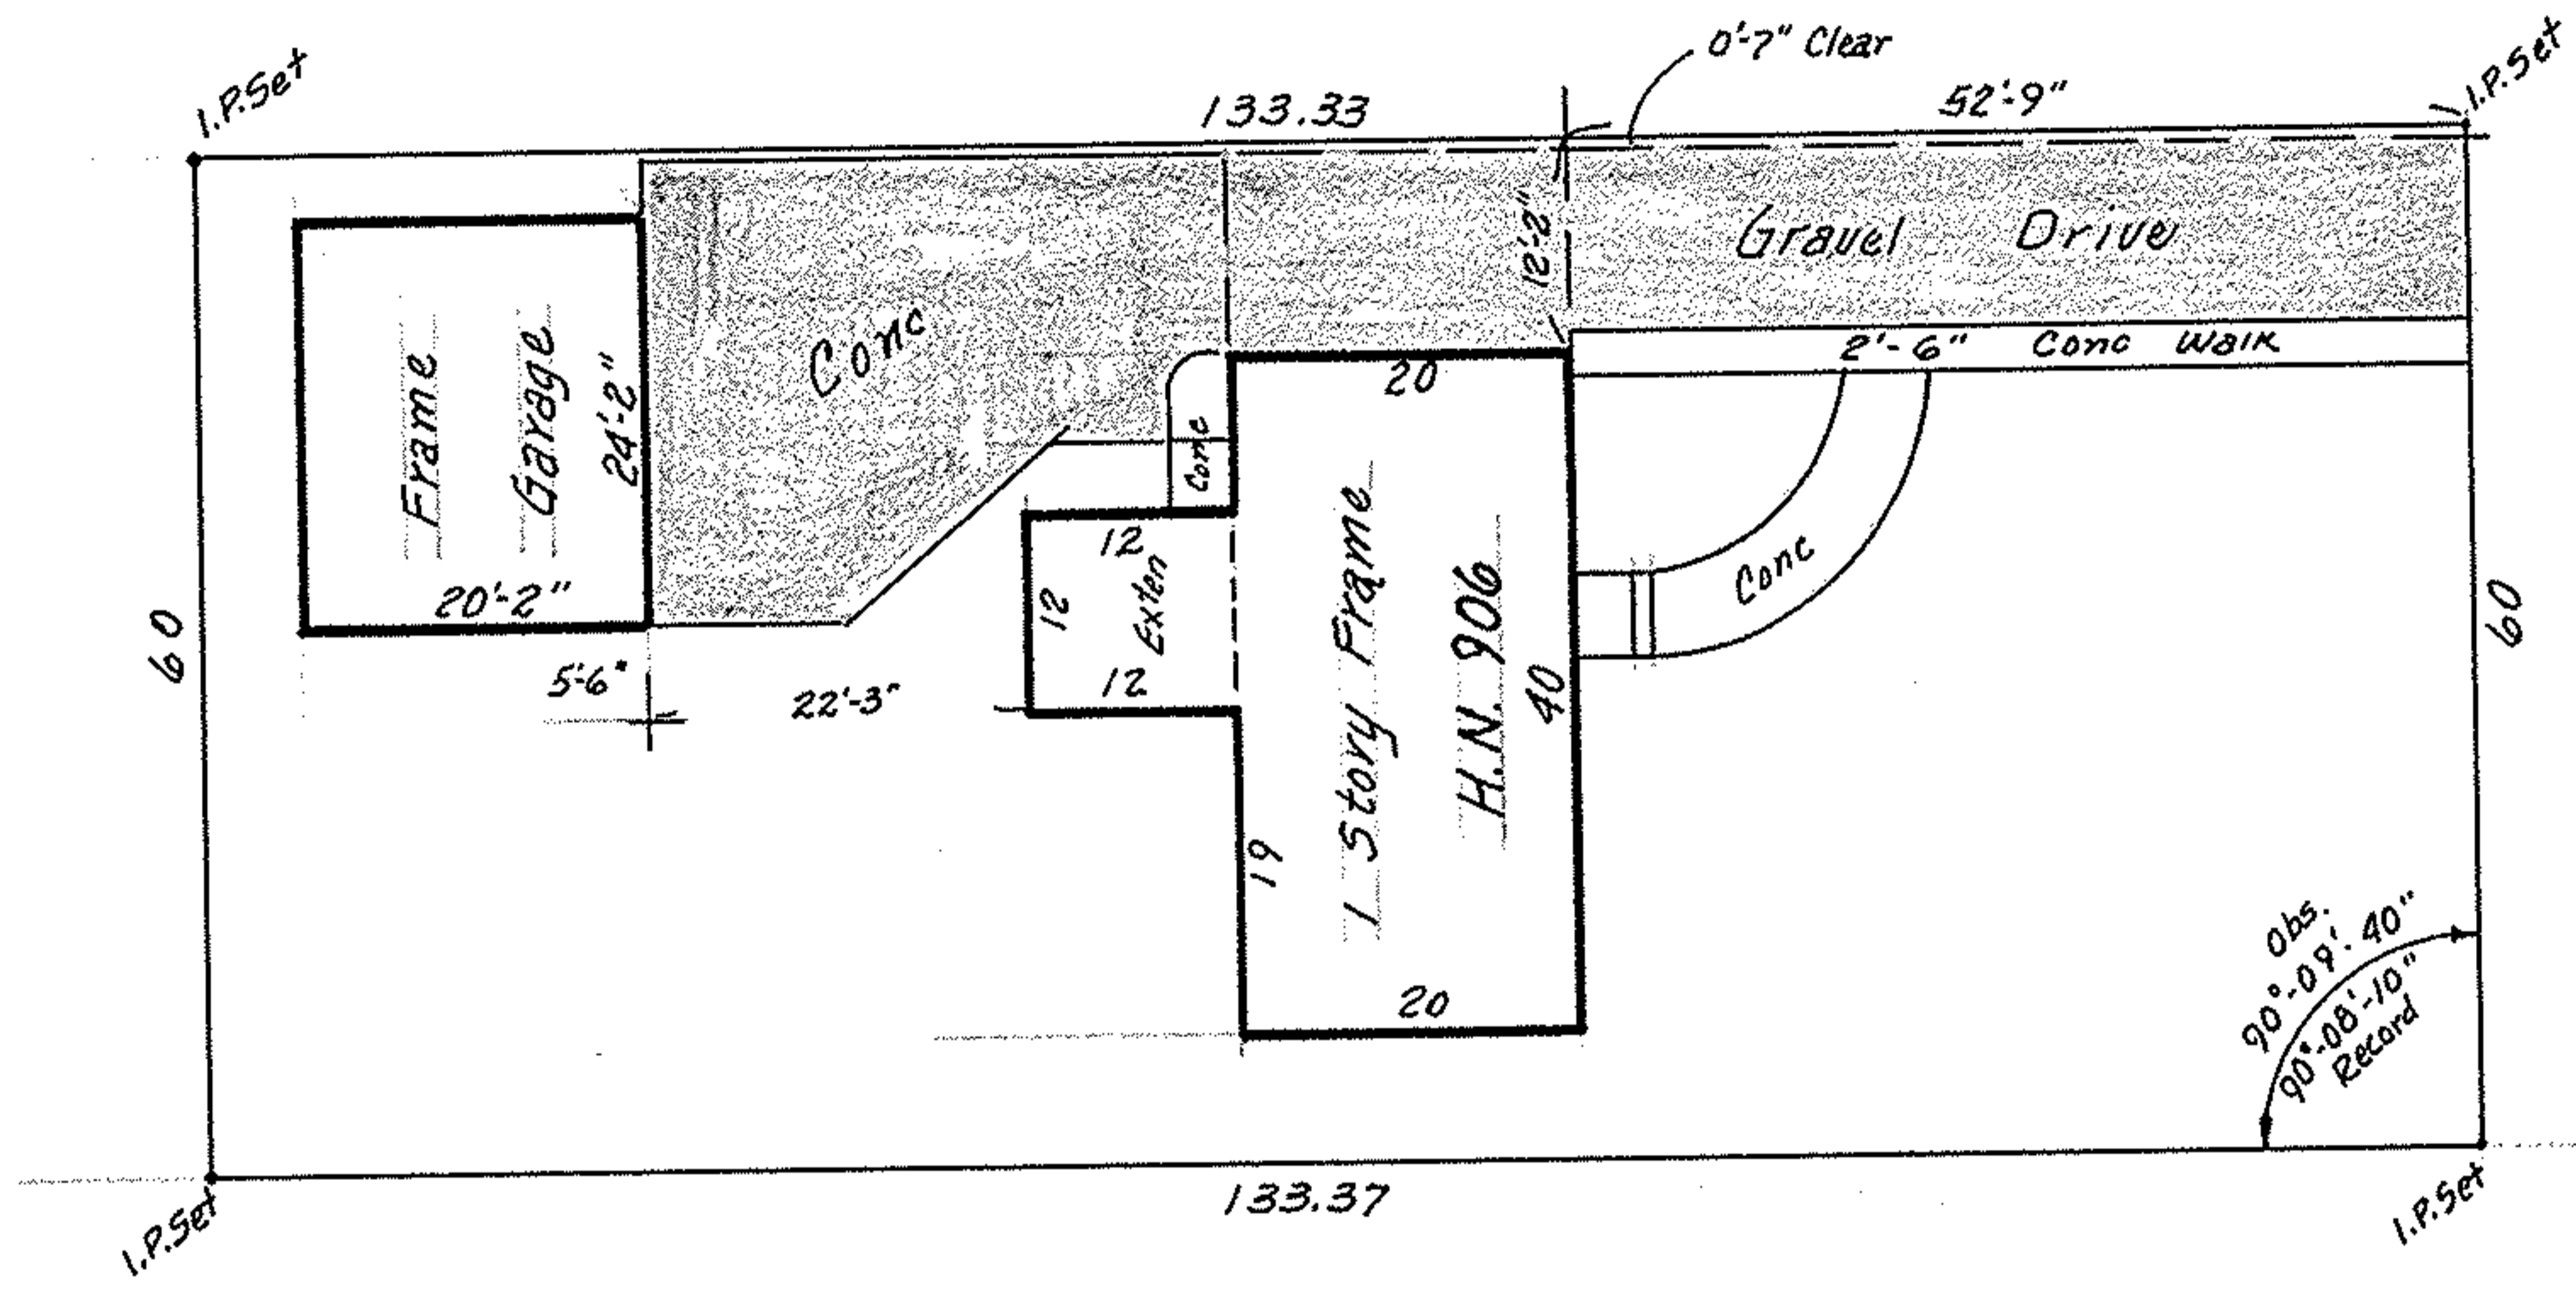

WEST DRIVE 50'

P.P. # 03-00-043-113-029  
SUBLOT #152 of MAPLE GROVE SUBDIVISION

PLAT VOL. 17 PAGE 30  
PART of ORIG. SHEFFIELD TWP. LOT 43  
NOW in CITY of SHEFFIELD LAKE, OHIO

THIS IS A PLAT OF SURVEY:  
FOR MORTGAGE LOAN PURPOSES ONLY

McGLINCHY & ASSOCIATES  
OCT. 22, 1979 #795666