


Scale: 1" = 20'

I hereby certify location as shown for the existing gas well is correct.

Lawrence V. McGlinchy
 Lawrence V. McGlinchy
 Reg. Surveyor No. 4970

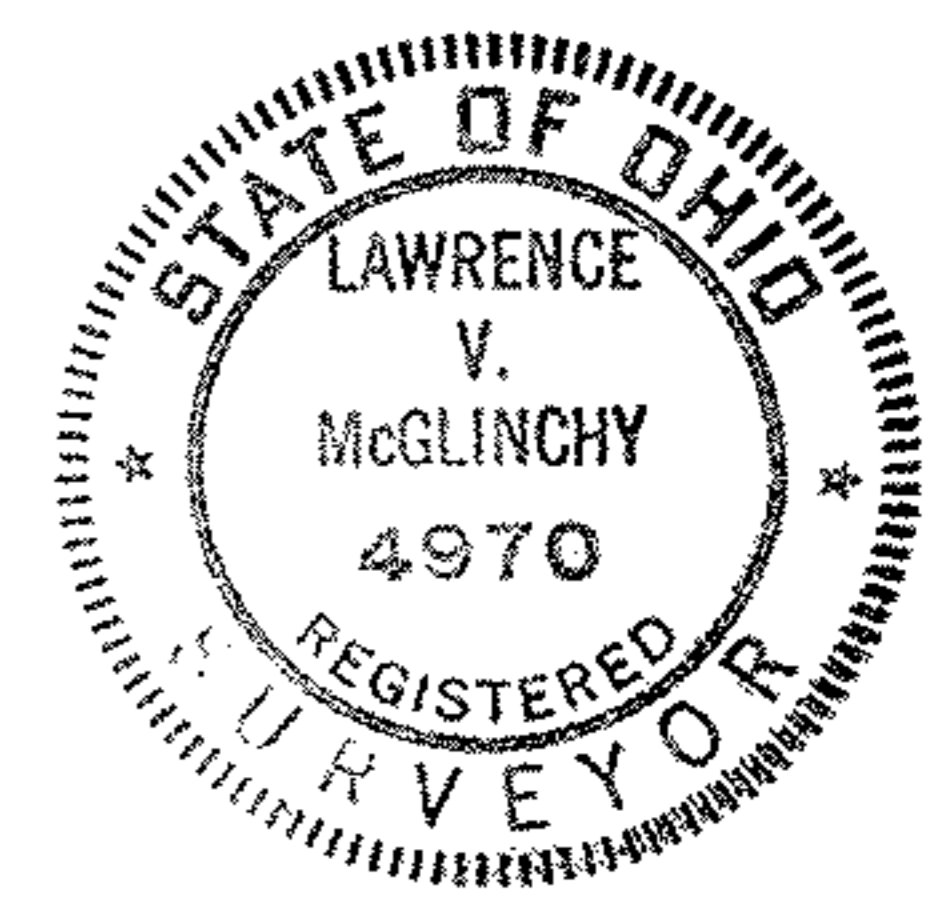

LOCATION MAP
 showing existing Gas Well
 on Property owned by
 Mary Solovey
 Imperial Cafe, 3177 Elyria, Avenue
 Lorain, Ohio

McGLINCHY & ASSOCIATES
 Professional Engineers & Surveyors
 538 West Broad St. Elyria, Ohio
 Job No. 74135