



17TH ST. 66' R/W

Drill Hole in Concrete Wall 299.95 Rec. 300.00 Obs.

I.P. Set in Parking Lot

97°37' Obs.  
97°34' 30" Rec.  
50.00'  
I.P. Set

S.L. 222

W.S. Streater Tr. Sub.  
Vol. 5, Pg. 11, Vol. 15, Pg. 70

Block 12  
S.L. 1  
W.A. Bramans Sub. Vol. 3, Pg. 21

90°02'10"

153.62 Rec. 153.78 Obs. I.P. to I.P.

I.P. Fd. & Obs S.L. 2

100.00' Rec. & Used

LONG AVENUE 66' R/W

50.00'  
I.P. Fd & Used

30.57 Rec.  
30.68 Obs.

82°42'40" Obs.

158.40 Rec. & Obs.


I.P. Fd. Buried  
I.P. Set 0.1' North

I.P. Fd. & Used

S.L. 222-See Deed Vol 251, Page 302		
S.L. 1	364	500
S.L. 2	364	295

18th St.

I.P. IN MON. BOX USED

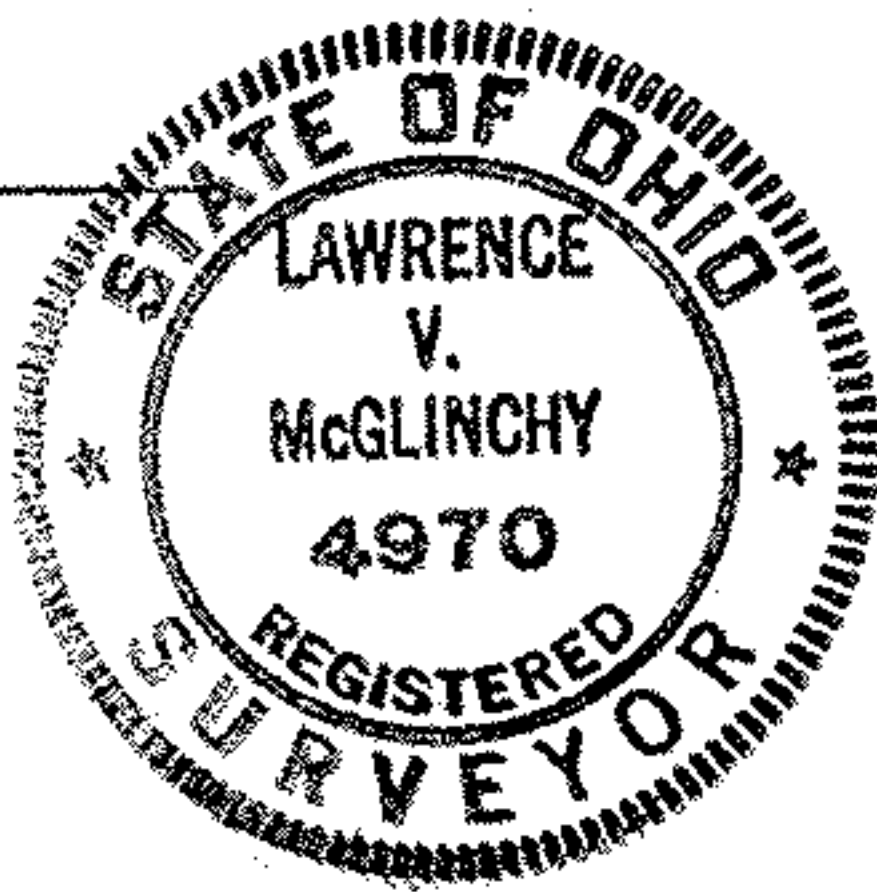

MAP OF SURVEY FOR  
UNITED POLISH CLUB  
17TH ST. & LONG AVE.  
LORAIN, OHIO SEPT. 1974

McGLINCHY & ASSOCIATES  
1"=40'  
ELYRIA, OHIO  
323-7491

LVM  
Job. No. 7493  
988-2394

OAKDALE AVENUE 66' R/W