




1" = 20'

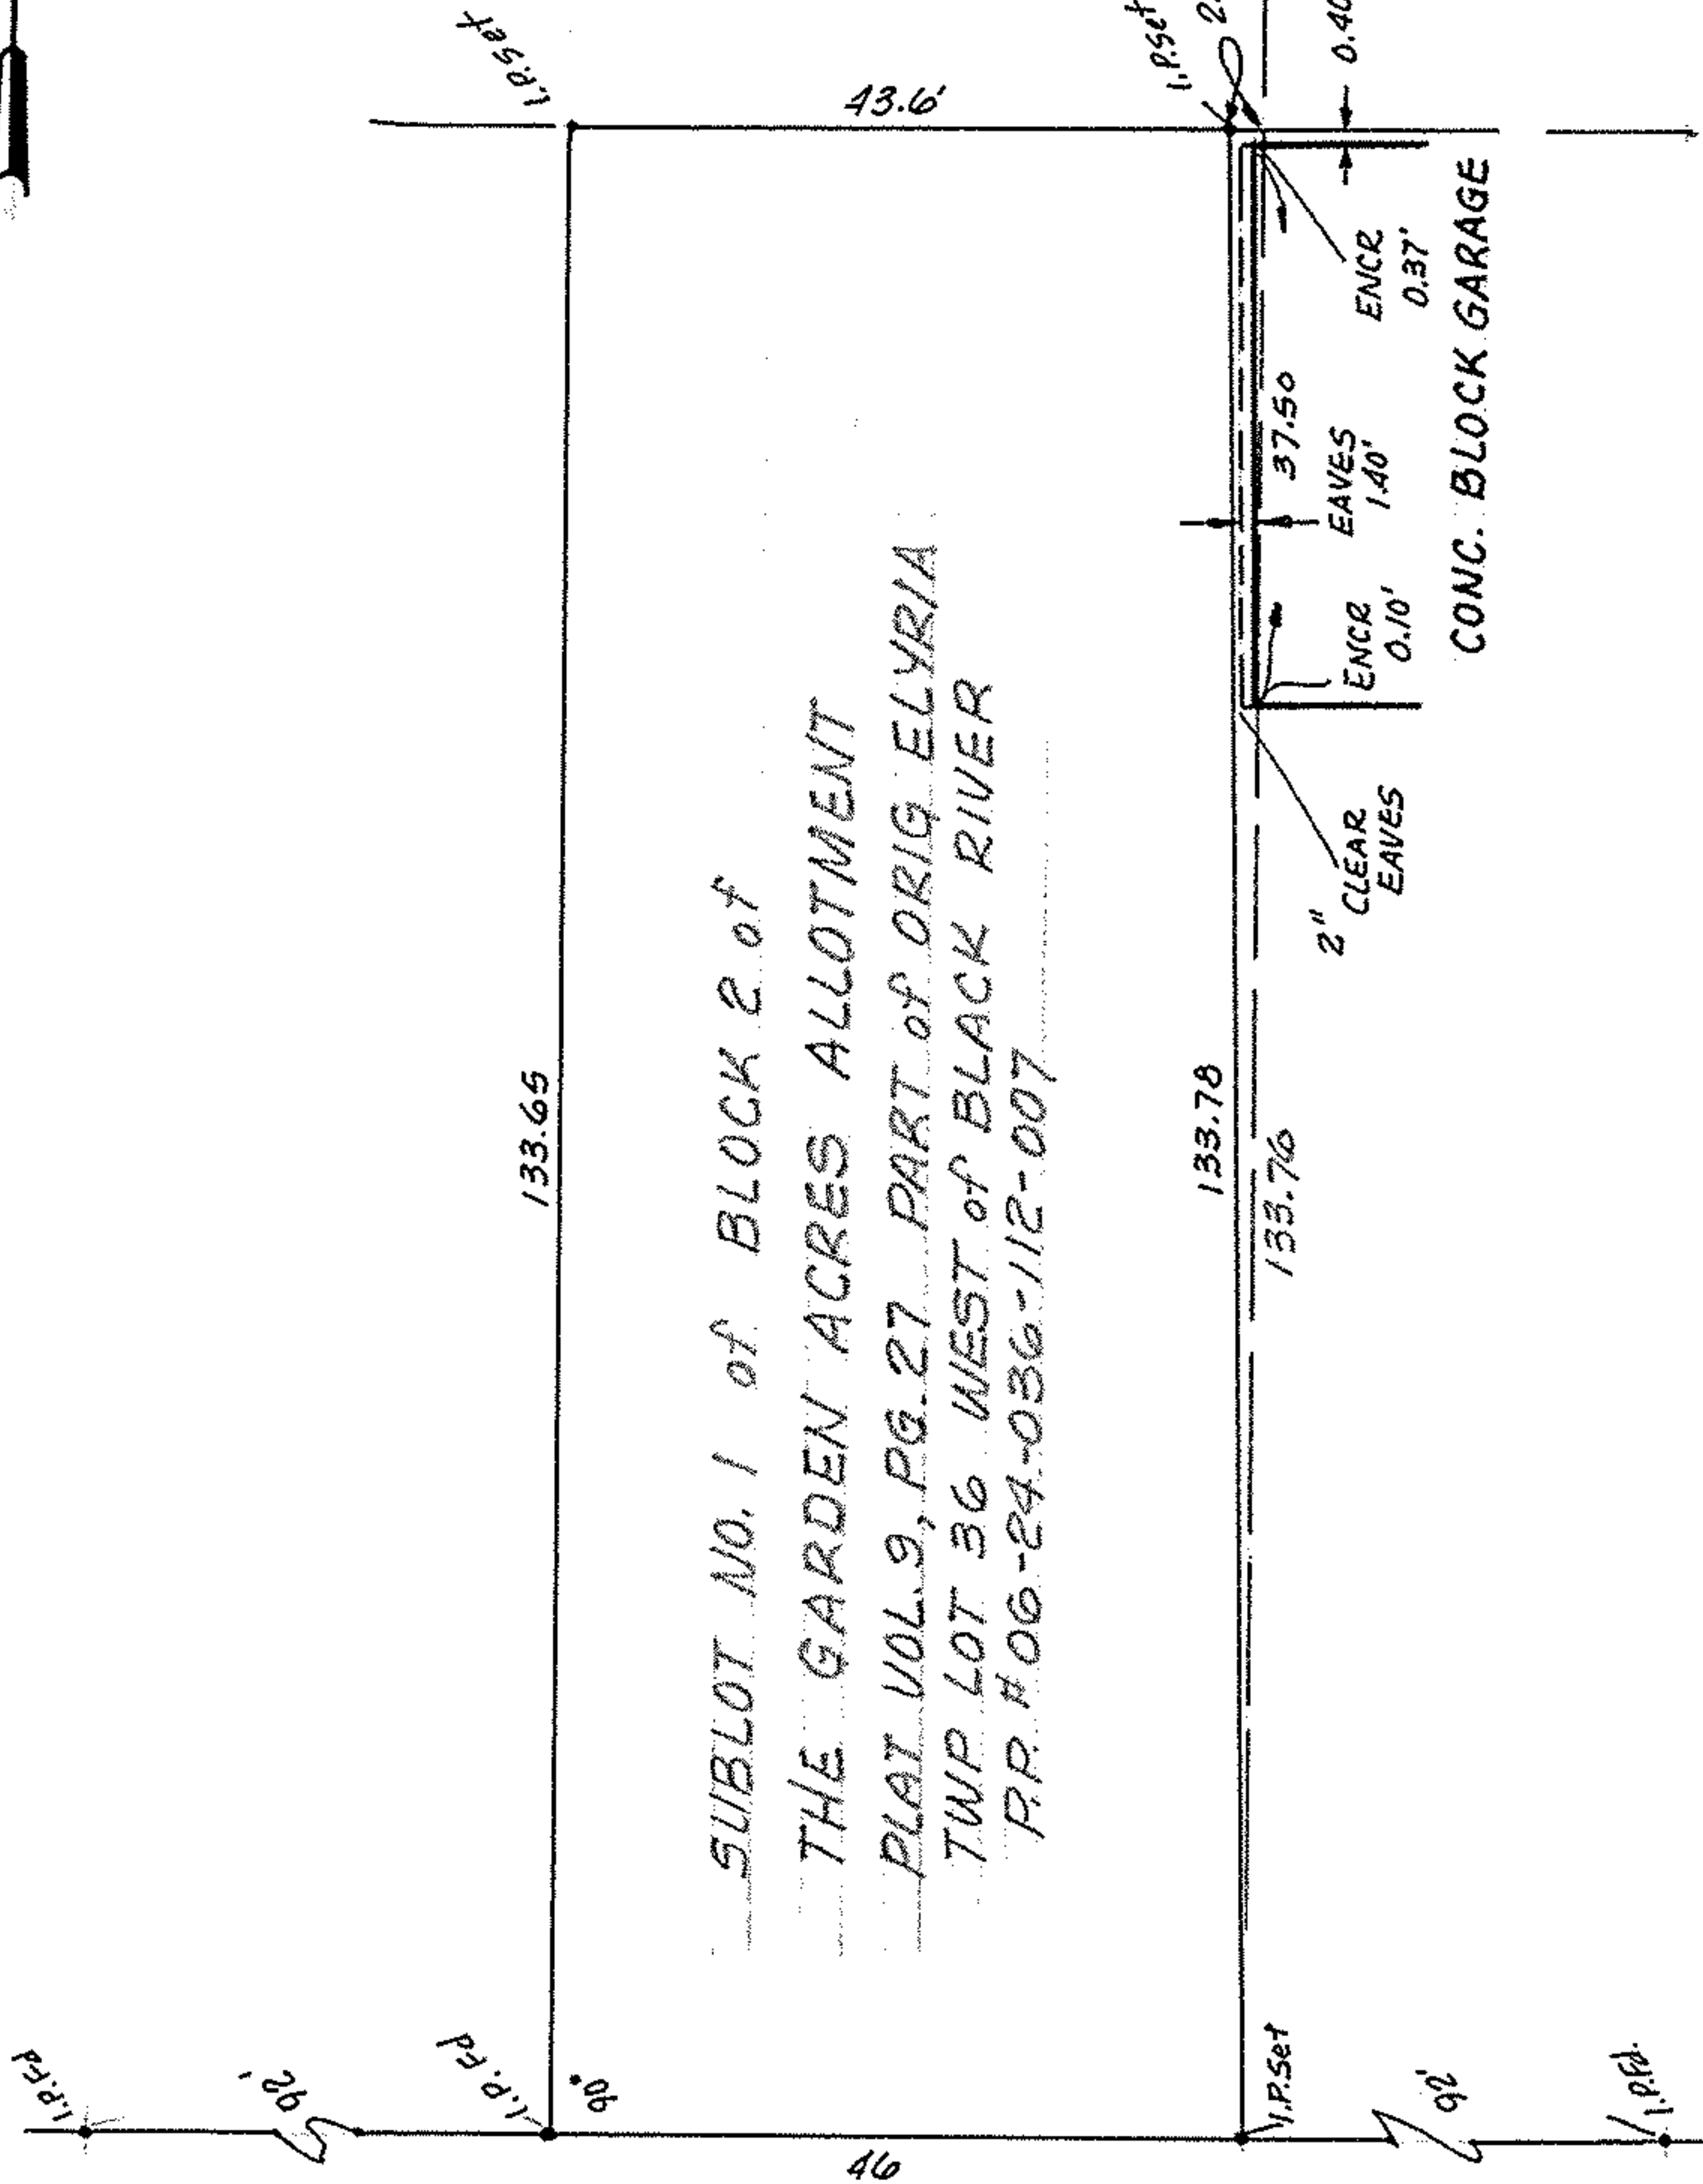

SUBLOT NO. 1 of BLOCK 2 of
 THE GARDEN ACRES ALLOTMENT
 PLAT VOL. 9, PG. 27 PART of ORIG ELYRIA
 TWP LOT 36 WEST of BLACK RIVER
 P.P. #06-24-036-112-007

MAP of SURVEY for
 BILL GARRETT BUILDERS INC.
 674 OBERLIN RD. - ELYRIA, OHIO

WARDEN AVE. 50

McGLINCHY & ASSOCIATES INC.
 REGISTERED SURVEYORS & ENGINEERS
 # 806224
 MARCH 5, 1980