


1"=30'

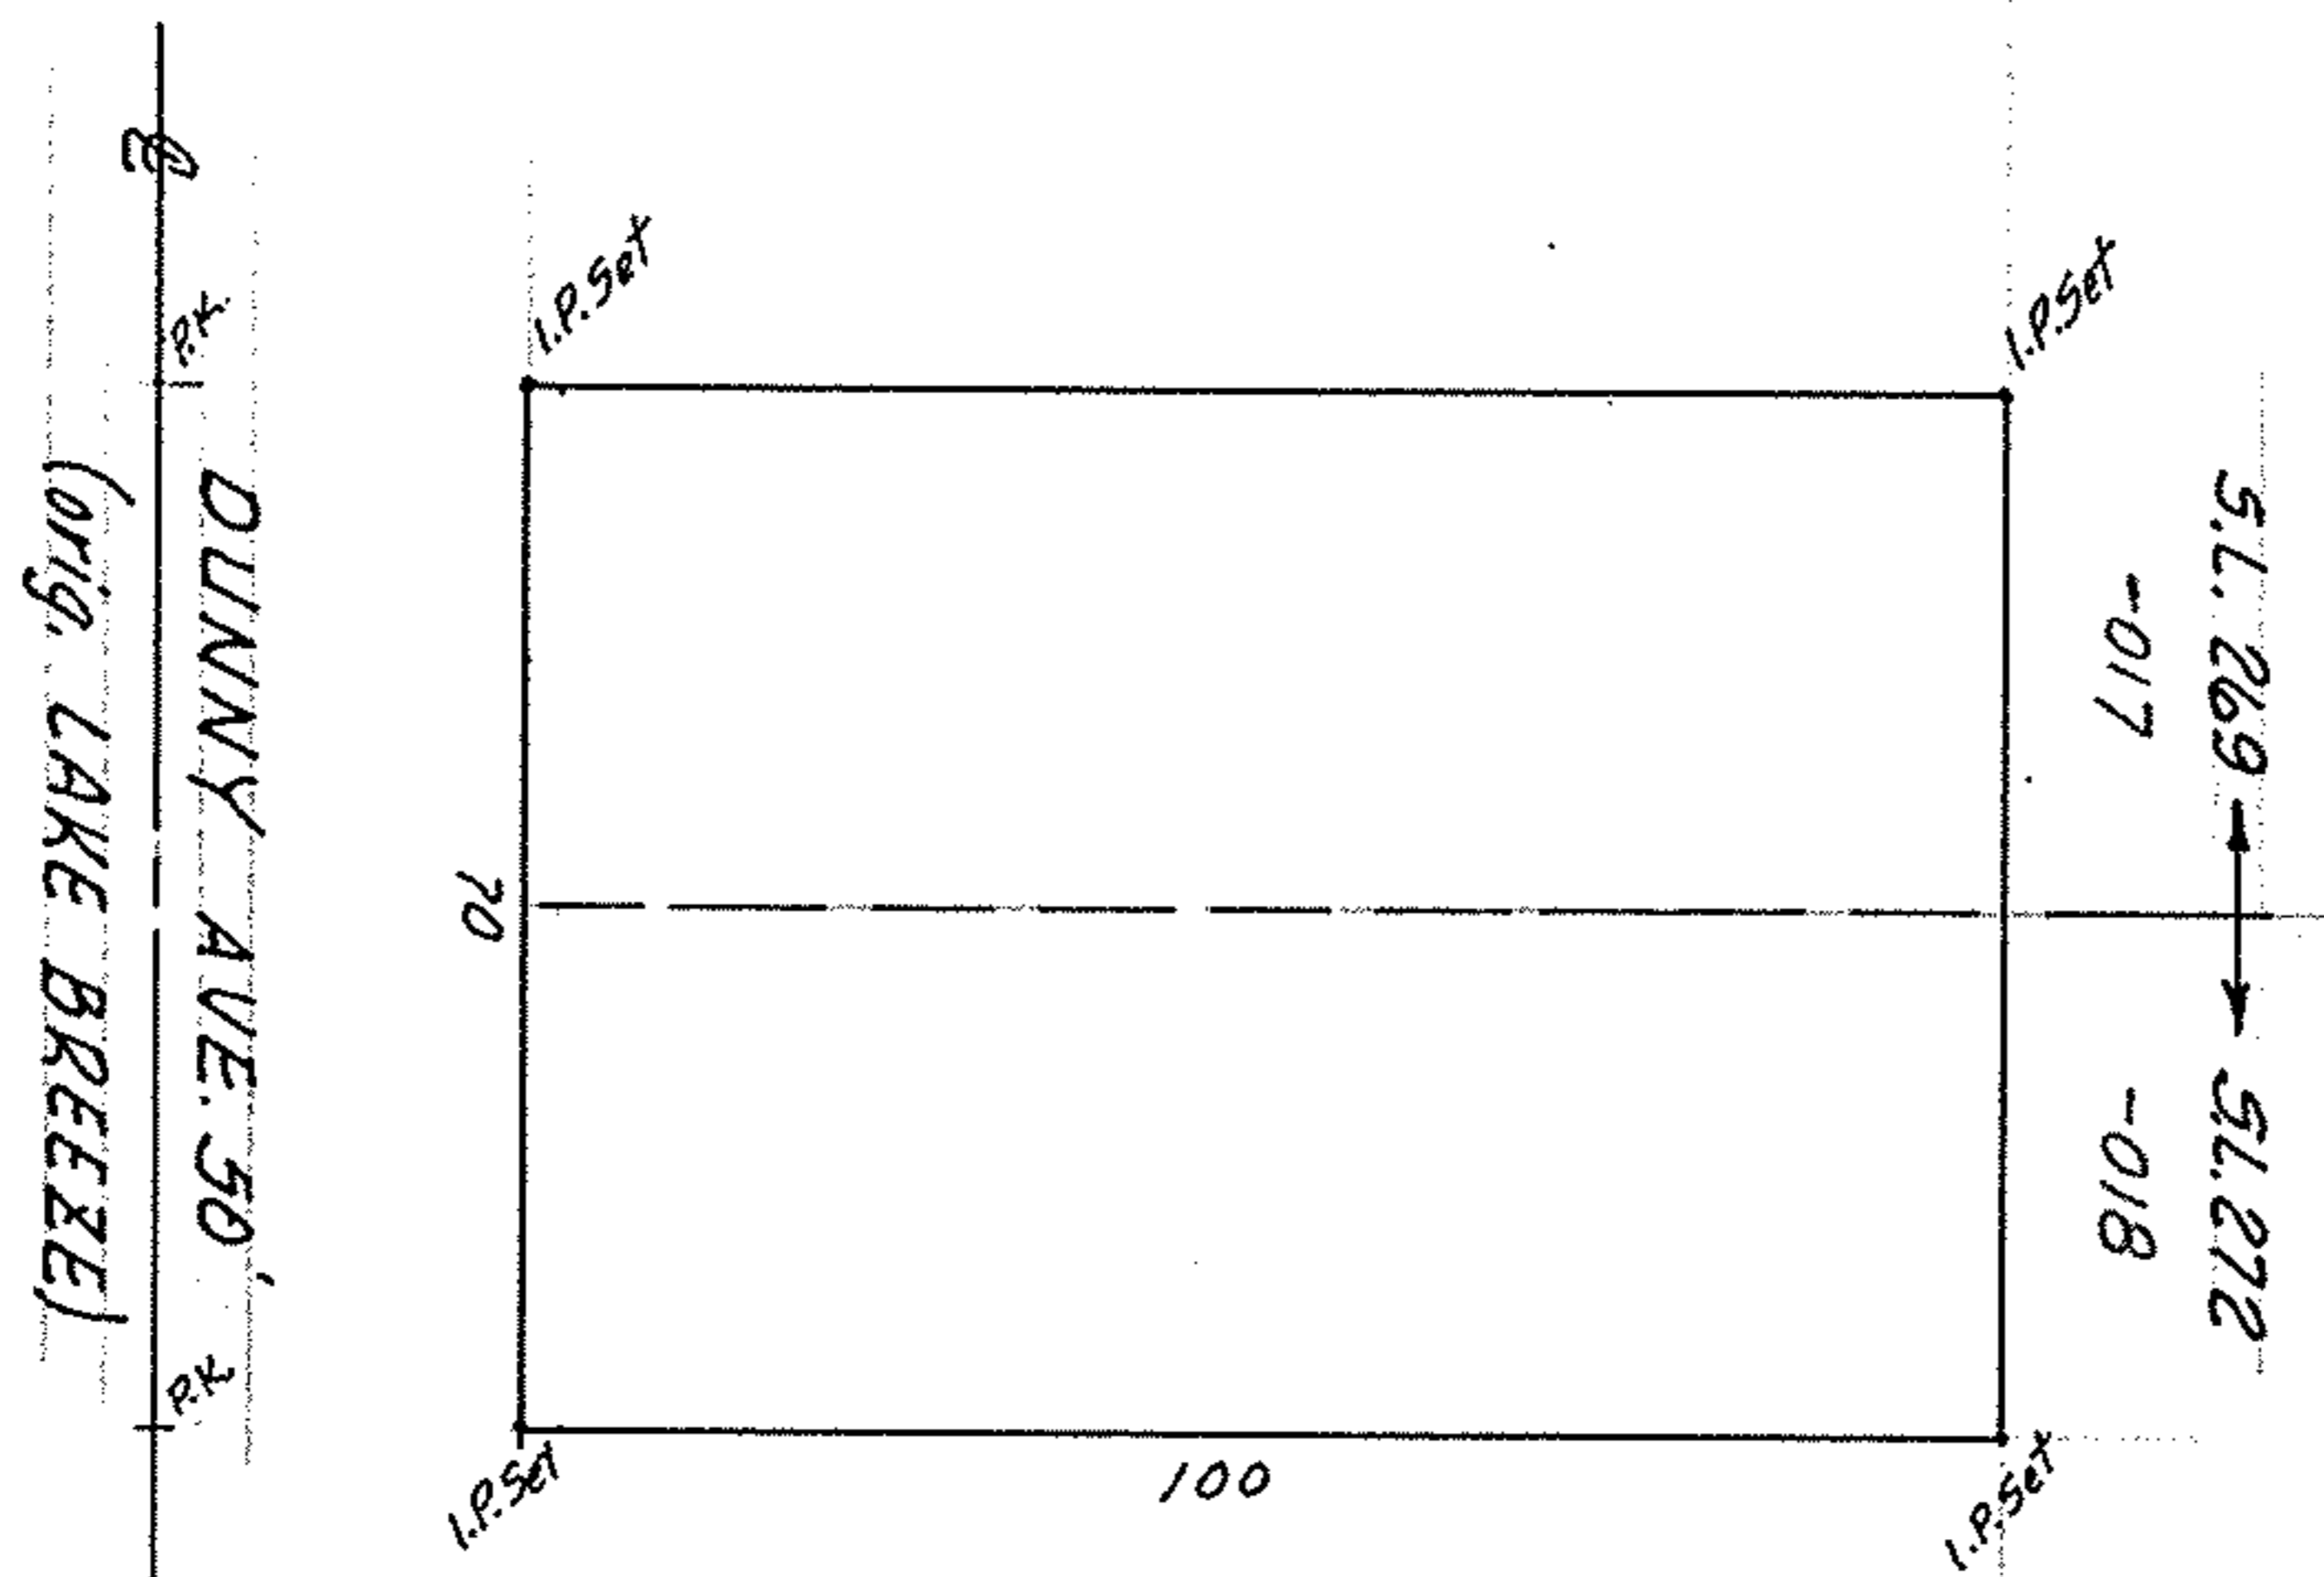

FENCE ON ADJACENT PROPERTY  
ENCROACHES 0.1'± AT REAR

SUBLOTS # PP #03-00-040-119-017 & -018  
269 & 272 of BLOCK 'C' of CLEVELAND  
BEACH ALLOTMENT

PLAT VOL. 9 PAGE 30  
PART of ORIG. SHEFFIELD TWP. LOT 40  
NOW in CITY of SHEFFIELD LAKE, OHIO

THIS IS A PLAT OF SURVEY:  
FOR ISABELL REALTY

**McGLINCHY & ASSOCIATES INC.**

MAY 7, 1980

#806296c