


1"=20'

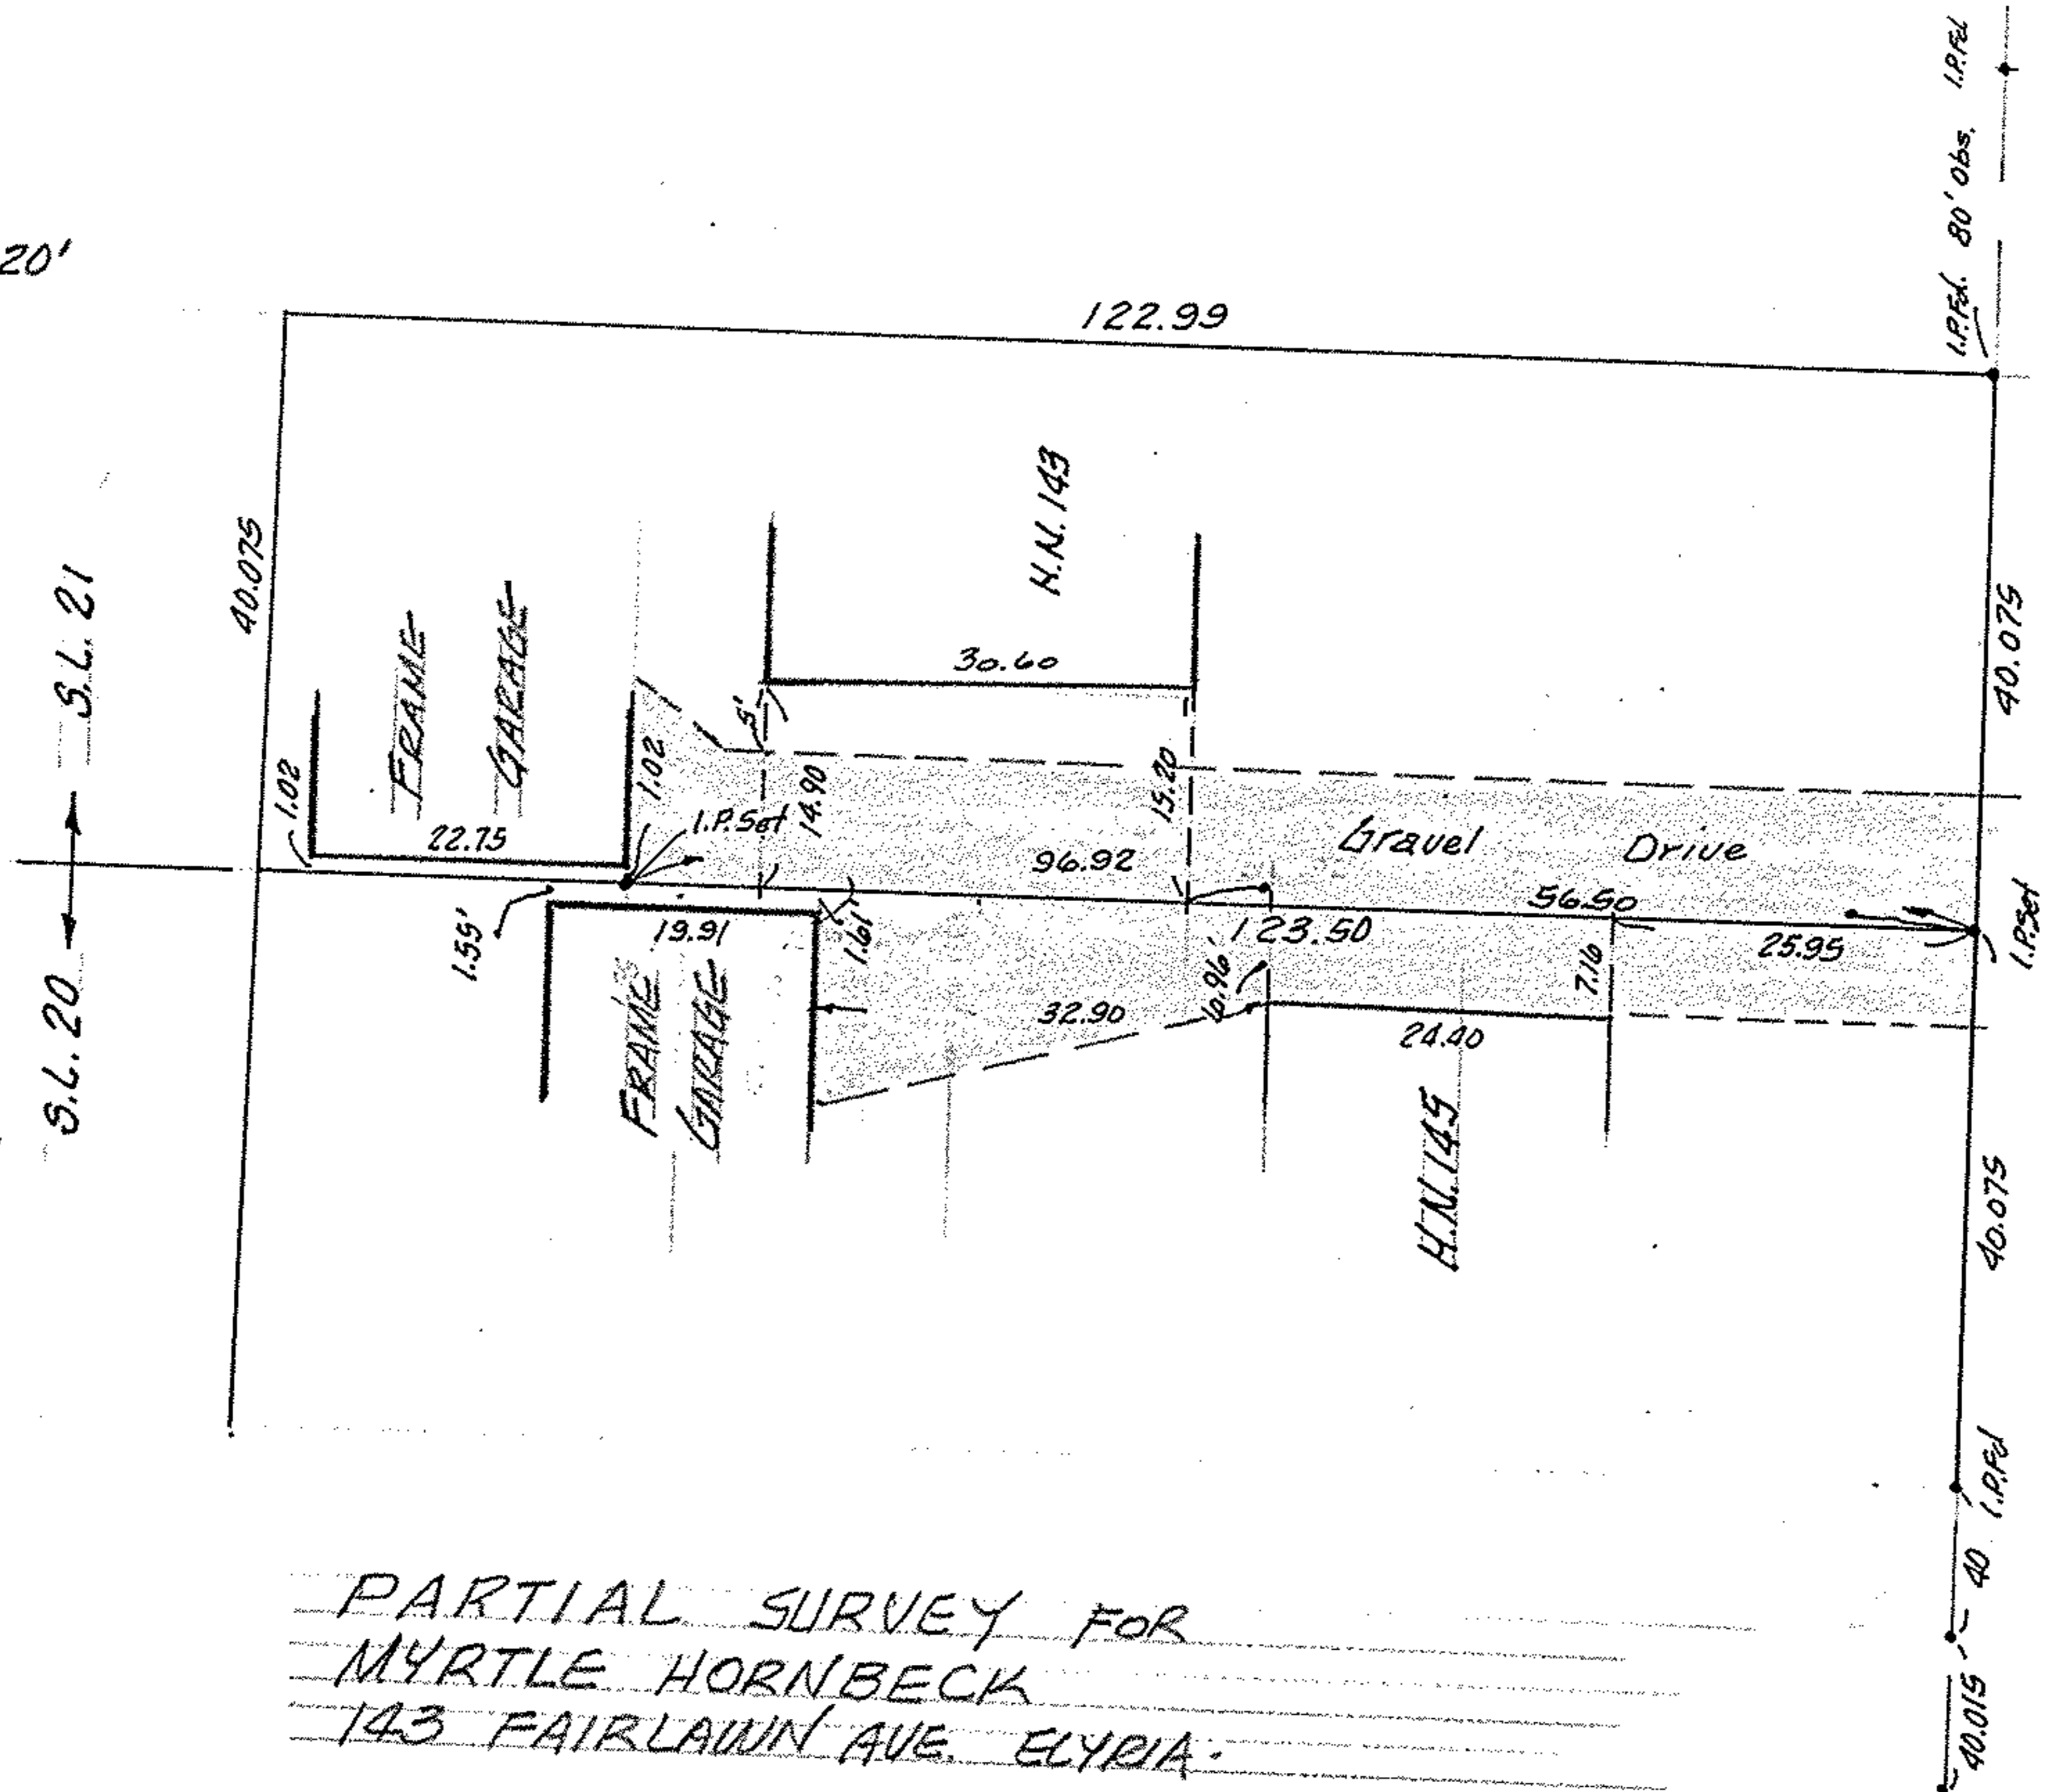

PARTIAL SURVEY FOR
 MYRTLE HORNBECK
 143 FAIRLAWN AVE. ELYRIA.

SUBLOT #21 of AVONDALE PARK ALLOTMENT

PLAT VOL. 6 PAGE 2
 PART of ORIG. ELYRIA
 NOW in CITY of ELYRIA

TWP. LOT 15 - EAST of BLACK RIVER
 , OHIO

THIS IS NOT A PLAT OF SURVEY:

McGLINCHY & ASSOCIATES INC.

MAR. 3, 1981

#816661