


# SITE PLAN

FOR  
 03-00-099-  
 PERM. PAR. NO. 101-007 SUBLOT NO. 5 ST. NO. E. 37<sup>th</sup>  
 BUILDER KENNETH WELLS TELEPHONE \_\_\_\_\_  
 DATE: MAY 1, 1980 LAWRENCE V. MCGLINCHY  
 SCALE: 1" = 30' REGISTERED SURVEYOR  
 NO. 4970

## LEGEND

- 00.0 EXIST. GRADE
- 00.0 PROPOSED GRADE
- 00.0 CERTIFIED GRADE
- DIRECTION OF SURFACE WATER FLOW

DESCRIPTION and LOCATION:	ELEV.
BENCH MARK: N.W. CORNER OF CATCH BASIN	63.93
F.H.A. 100 YR. F.P. REG.	66.70
TOP OF FINISH. FOUNDATION	67.41
LOWEST FINISHED FLOOR	72.67
LOWEST HABITABLE FL.	65.75

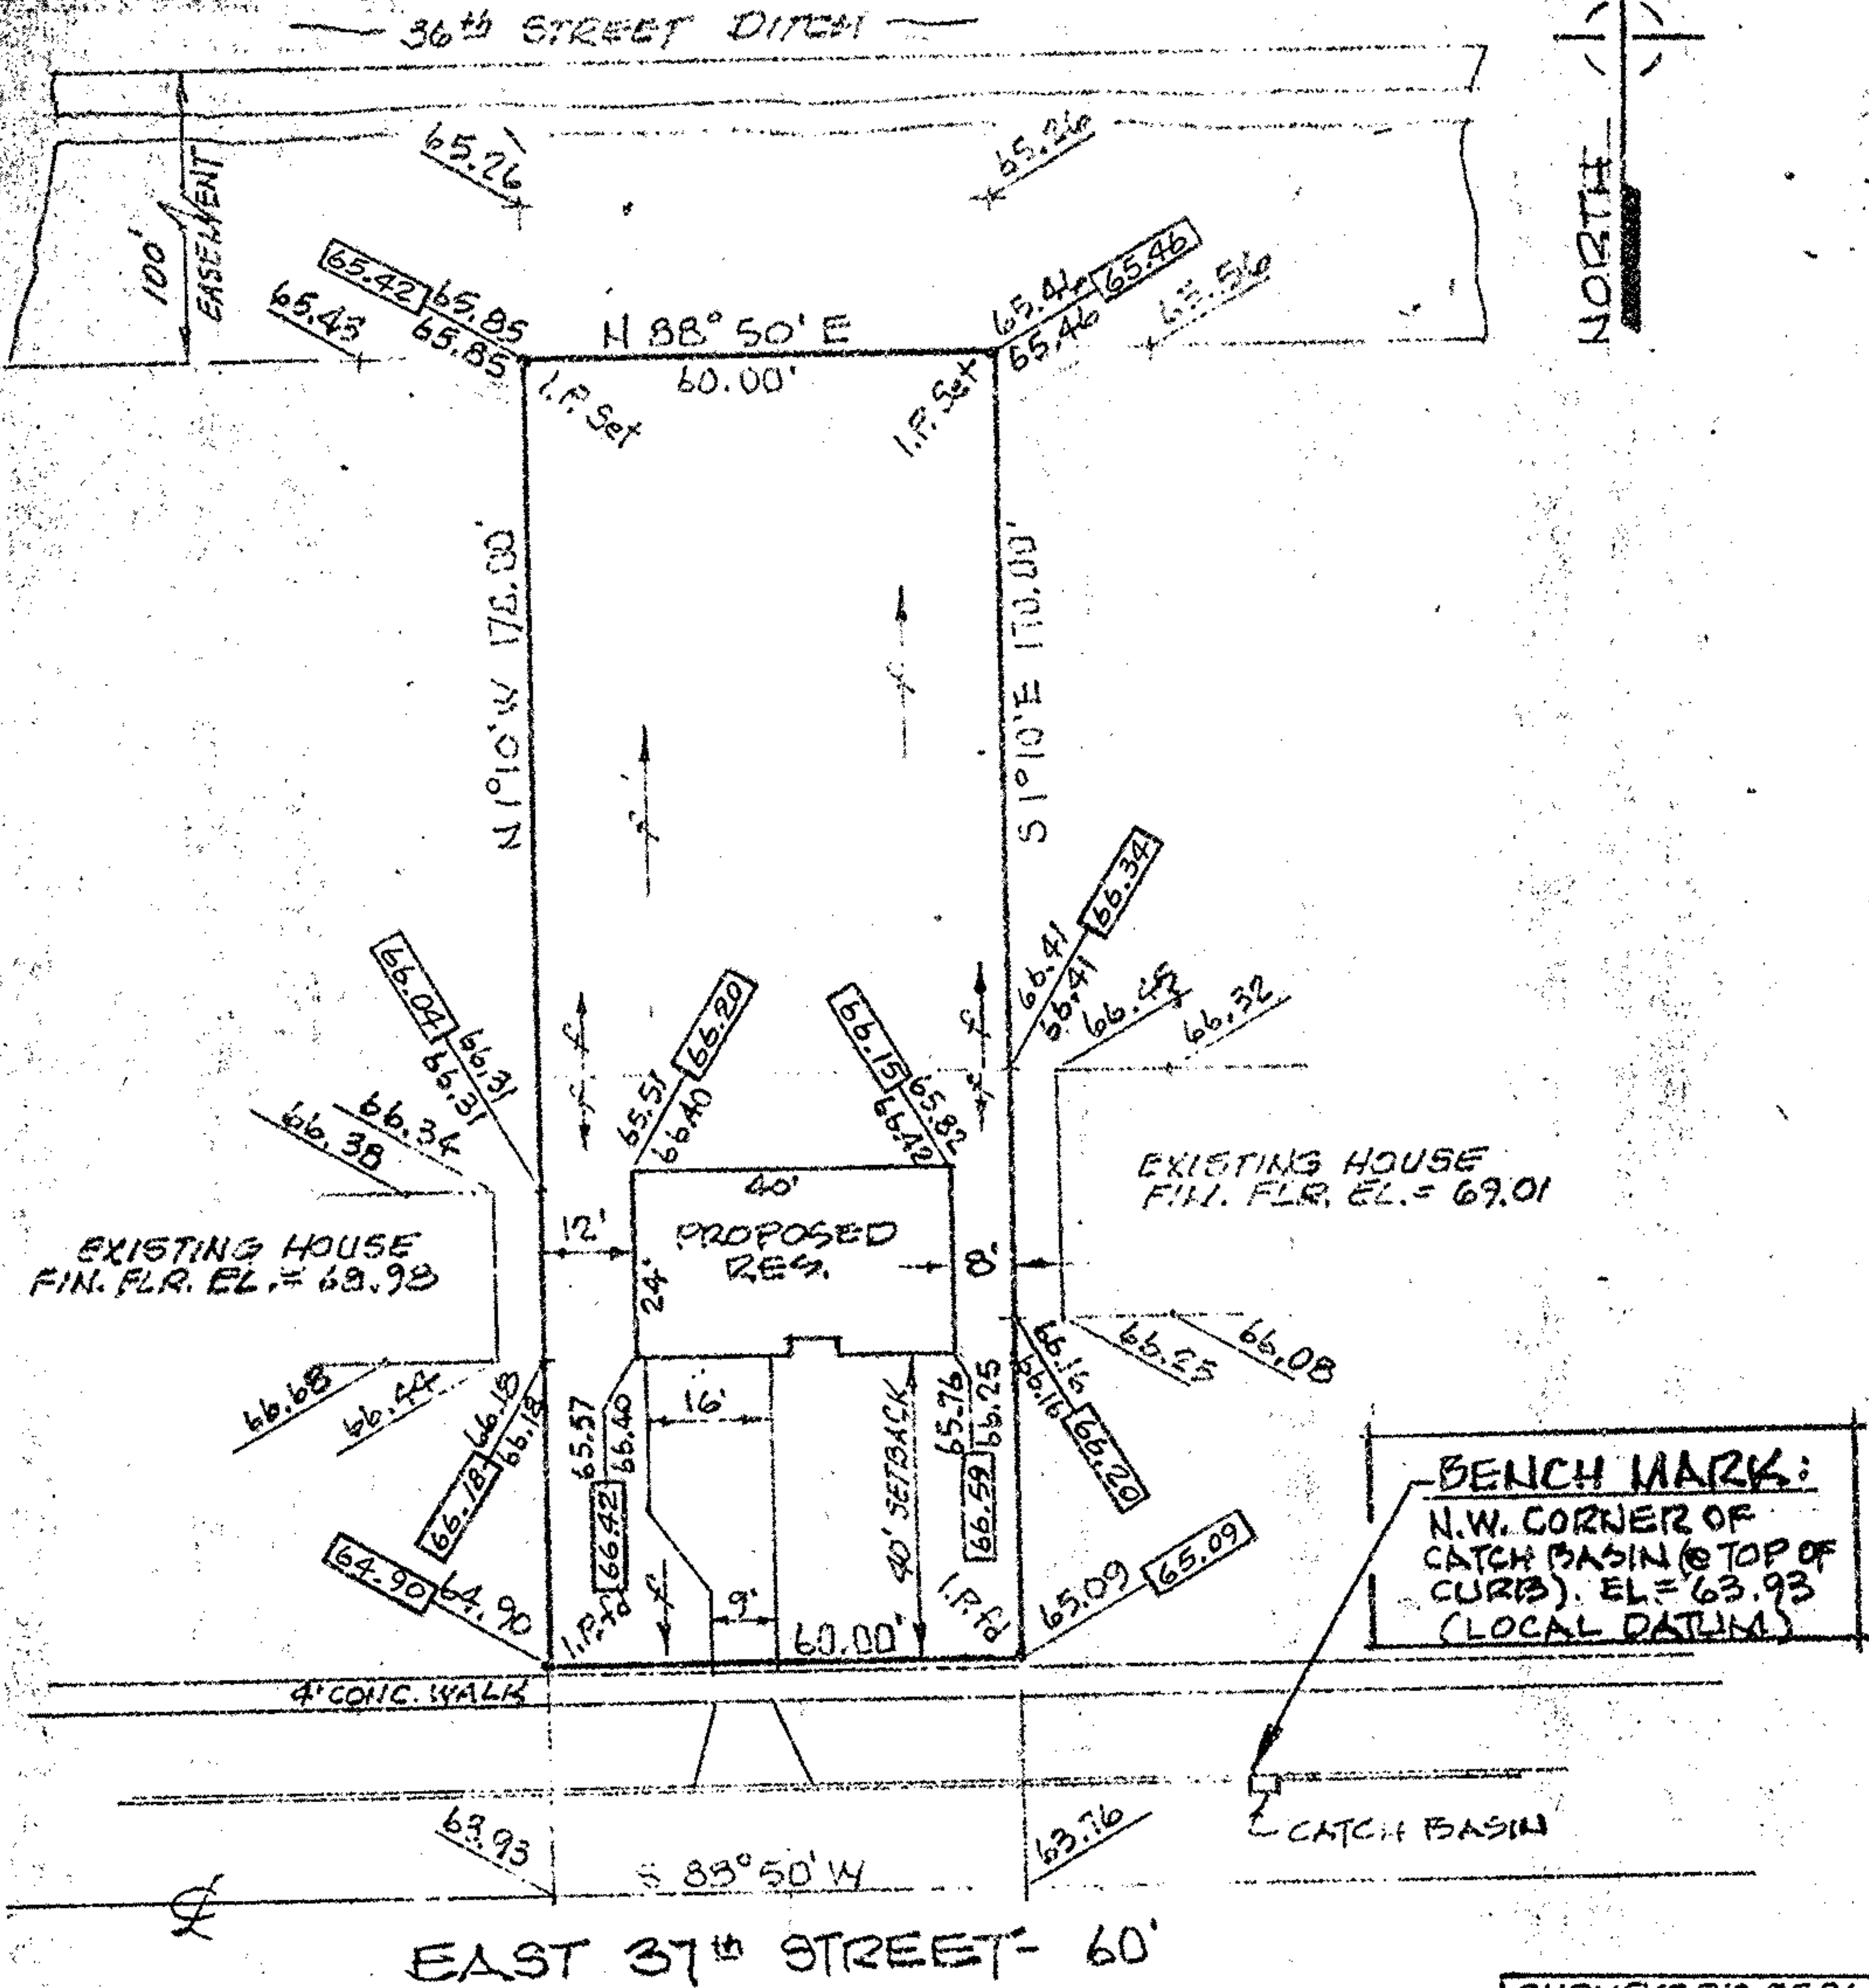

CERTIFIED GRADES TAKEN THIS 18<sup>th</sup> DAY OF AUGUST 1980

REG. NO.

