

OHIO STREET 50'

165

I.P.Fd

90°01' REC  
90°00' OBS.

90°01'

S.L. 36

S.L. 35

S.L. 34

90

S.L. 37

BEVERLY COURT 30'

90°

HEDGE  
85' REC. & OBS.

I.P. Set

2"

48.09

NEIGHBOR'S 6' WOOD  
PANEL FENCE ENCROACHS

0' 2"  
ENCR.

17.74 REC. & OBS

I.P.Fd. BENT &  
REPLACED


THIS CORNER NOT ACCESSIBLE  
TO SET PIN.

2.75' REC.

0' 3"  
CLEAR

NEIGHBOR'S 6' PICKET  
FENCE

NEIGHBOR'S 4' PICKET  
FENCE - CLEAR 1'-0"

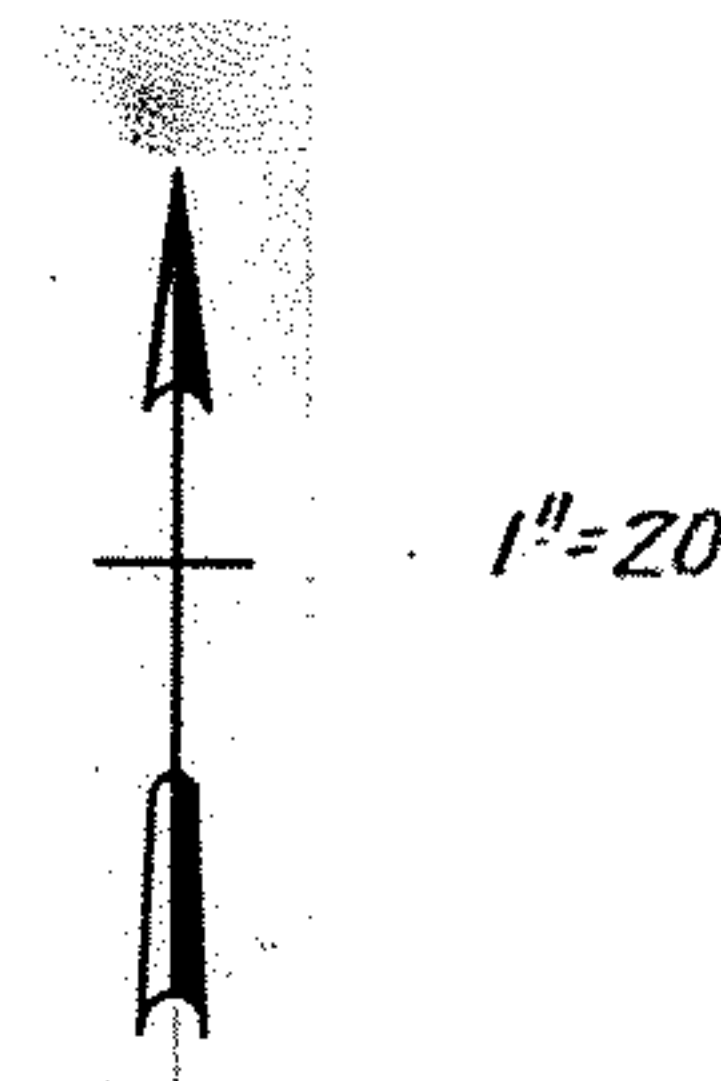

OHIO STREET APARTMENTS INC  
VOL 851 PG. 559 7/8/63

MAP OF SURVEY FOR  
MARVIN EVENCHIK

SUBLOT NOS. 34, 35, 36 & 37 OF  
EASTLAWN ALLOTMENT - PLAT VOL 10 PG. 2.  
PART OF ORIG. ELYRIA TWP. LOT 37 - EAST OF BLACK RIVER  
NOW IN CITY OF ELYRIA, OHIO

McGLINCHY & ASSOCIATES INC.  
REGISTERED SURVEYORS & ENGINEERS  
JAN 6, 1982 # 817101