


1" = 20'

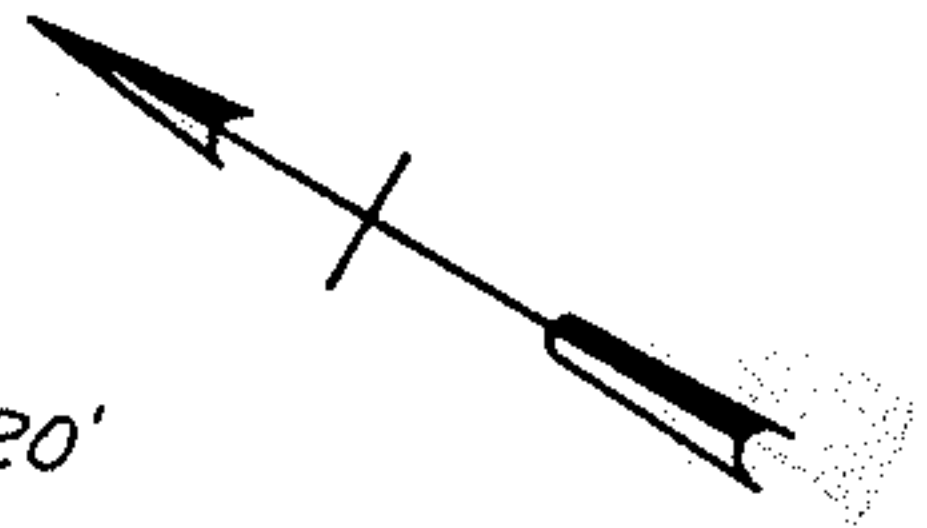

C of COLUMBIA RD. S.R. #252
PKB HALL ROAD as RELOCATED

SHELL OIL CO.

CENTER-LINE OF ORIGINAL
INGERSOLL ROAD aka HALL ROAD

6' CHAIN LINK FENCE 0'-8" CLEAR

S 37°-14' E 300.96' REC. 299.16' OBS

ASPHALT DRIVE

ASPHALT PARKING

GRADE & DAY CARE SCHOOL
3 STORY BLD'G

4' CHAIN LINK FENCE

R.R.S. Set

N 59°-53' E 51.48'

I.P.Pd.

40.30

40.30

N 36°-29'-02" W 300.50'

1'-9"

71'

I.P. Set

I.P. MON. BOX

S 59°-53' W 55.44'

LORAIN ROAD aka S.R. 10

MAP of SURVEY FOR
ATTORNEY KENNETH P. FRANKEL

PART of ORIGINAL DOVER TWP LOT 18
NOW in CITY of NORTH OLMSTED
CUYAHOGA COUNTY, OHIO

McGLINCHY & ASSOCIATES INC.
REGISTERED SURVEYORS & ENGINEERS
JAN. 1982 JOB # 817077