


MAP OF SURVEY
PREPARED FOR TOM SIGSWORTH
PART OF ORIGINAL RIDGEVILLE TWP. LOT 14
CITY OF NORTH RIDGEVILLE, LORAIN COUNTY, OHIO

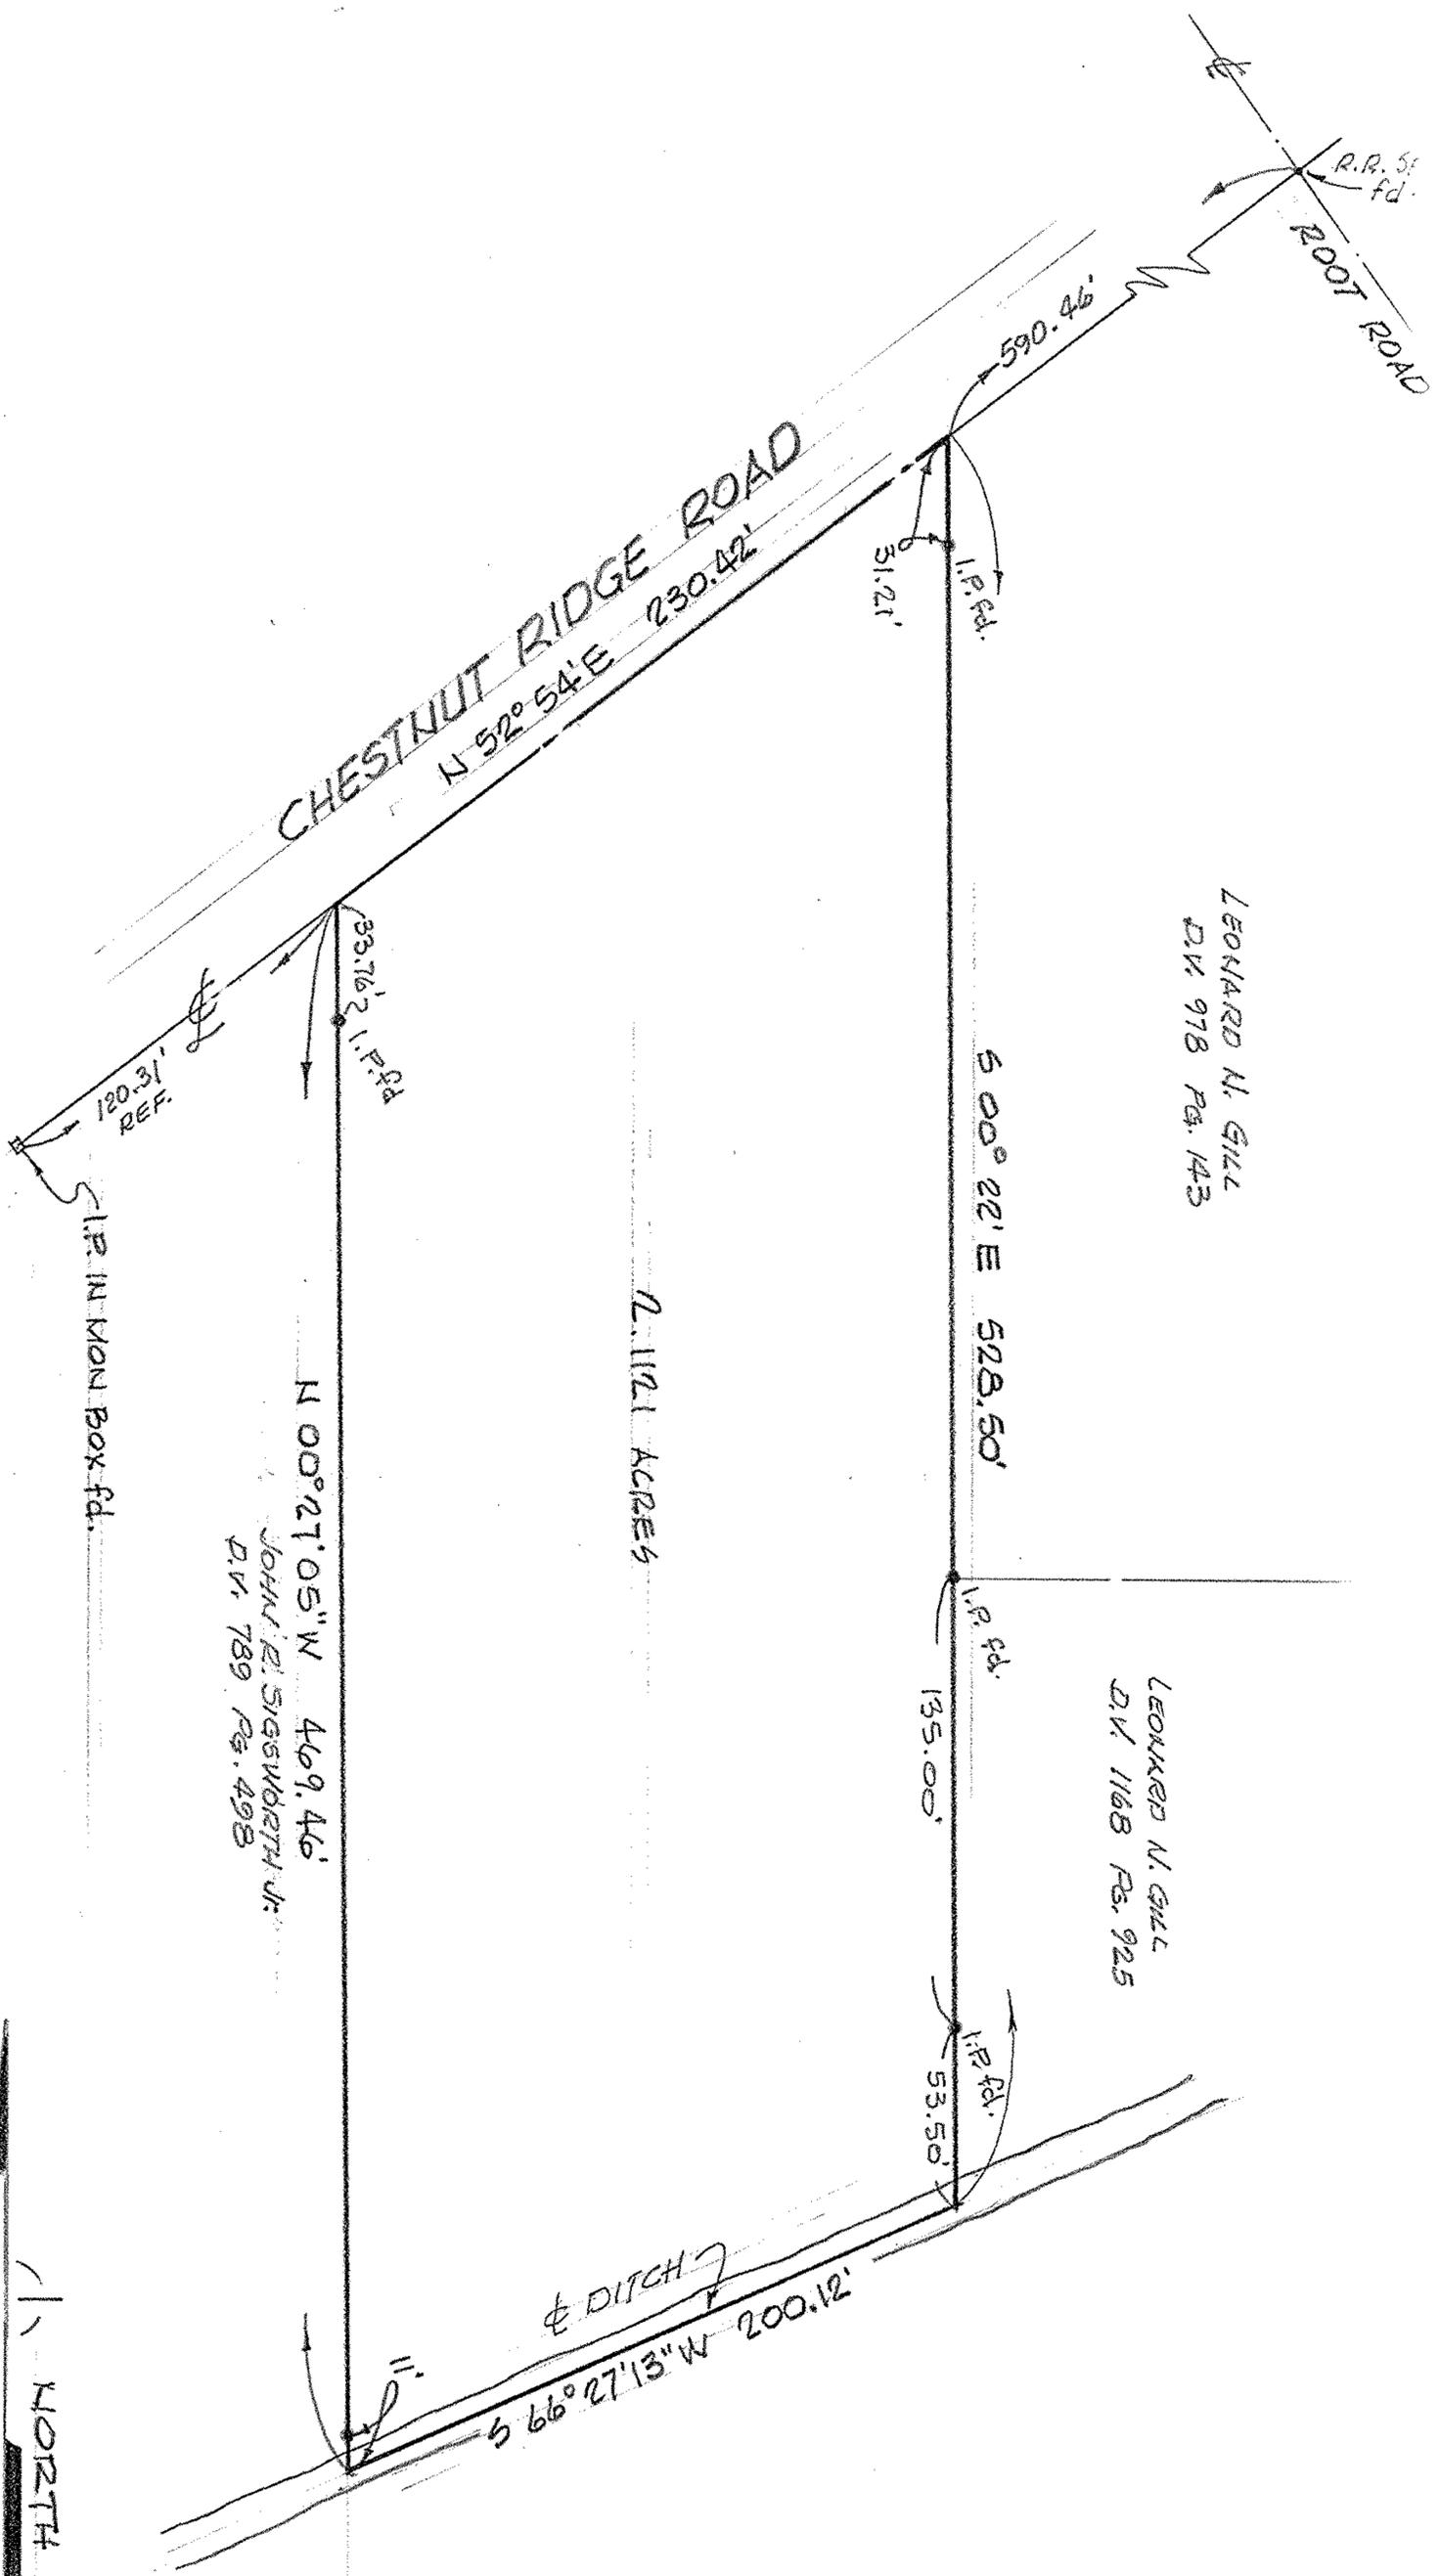

2.1121 ACRES
 JOHN E. SIGSWORTH JR.
 D.V. 789 PG. 498

LEONARD N. GILL
 D.V. 978 PG. 143

LEONARD N. GILL
 D.V. 1168 PG. 925



McGLINCHY and ASSOCIATES INC.
 PROFESSIONAL ENGINEER & SURVEYORS
 110 1/2 MIDDLE AVE. ELSTON, OHIO
 SEPTEMBER, 1980 #806445