


SUBLOT # 201 OF JOSIAH HARRIS HEIRS
 ADDITION - PLAT VOL. 2, PG. 3 - PART OF
 ORIG. AMHERST TWP. LOT 24 -
 NOW IN CITY OF AMHERST, OHIO

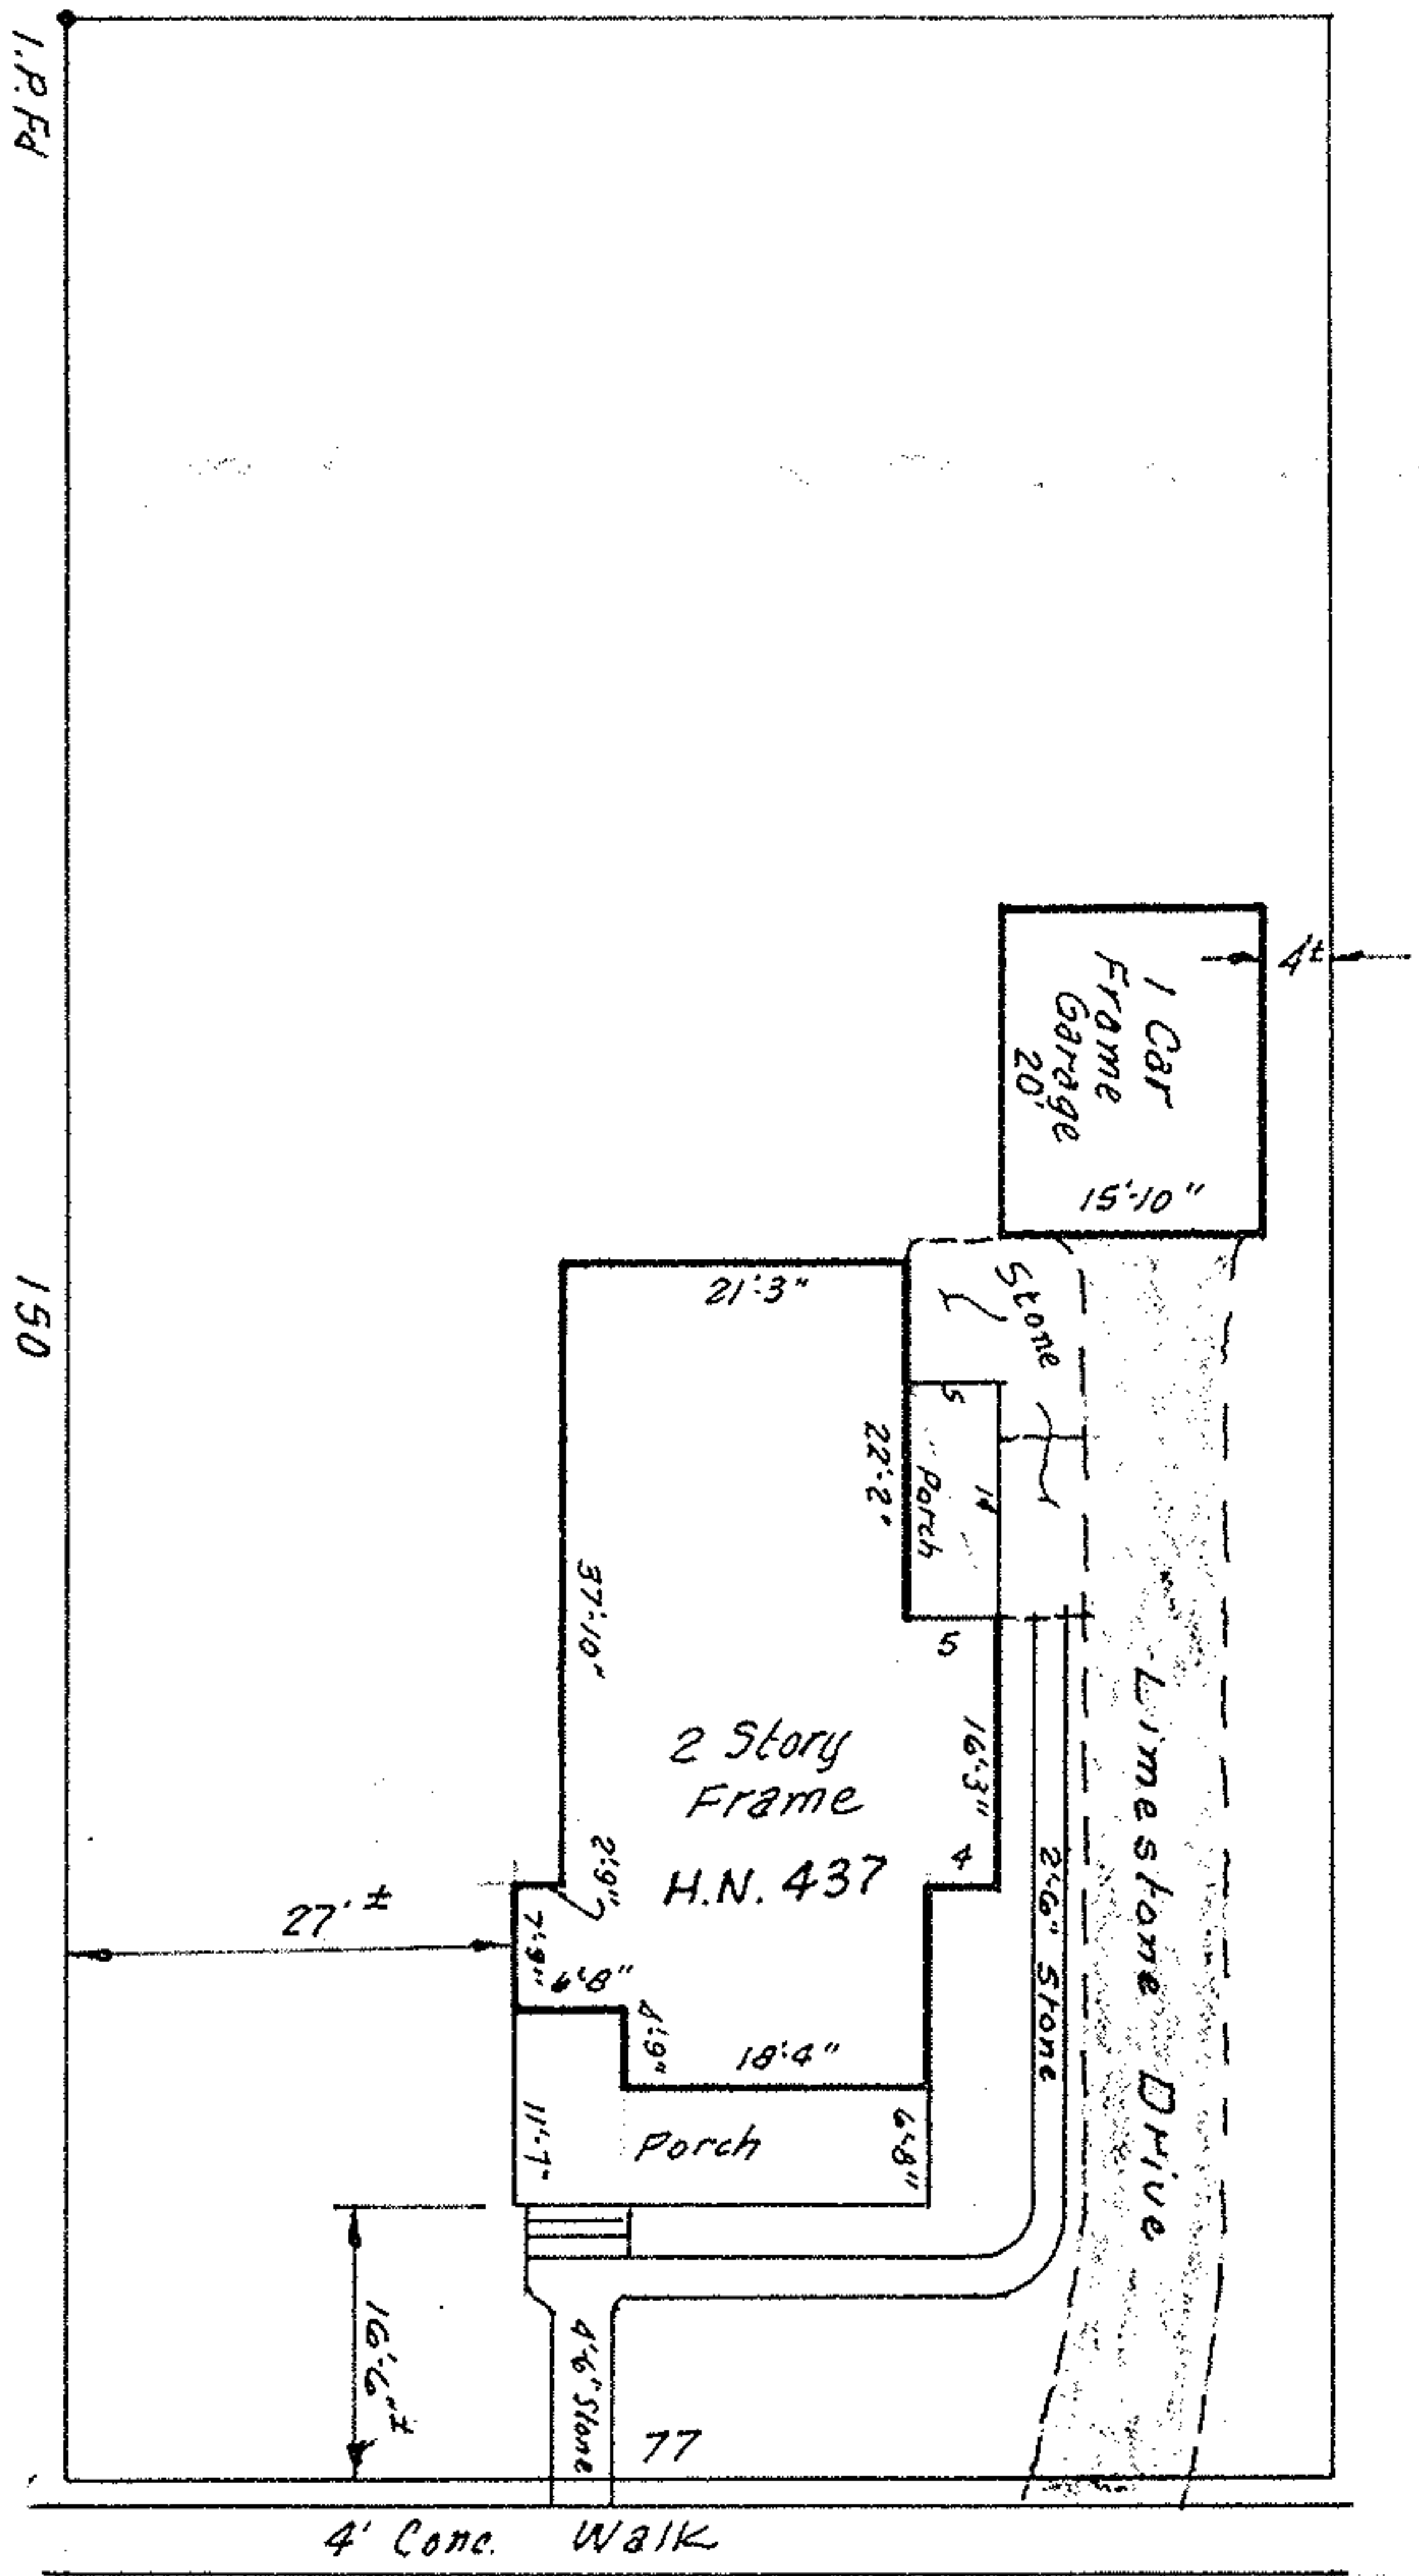

FRANKLIN ST. 50'
 (orig SCHOOL ST.)

McGLINCHY & ASSOCIATES
 APRIL 14, 1976 #76858

LT # EL 43, 736