


P.P. #3-00-066-103-006 .556 Ac
 PART OF ORIG. SHEFFIELD TWP.
 LOT 66 - NOW in SHEFFIELD VILLAGE
 LORAIN COUNTY, OHIO

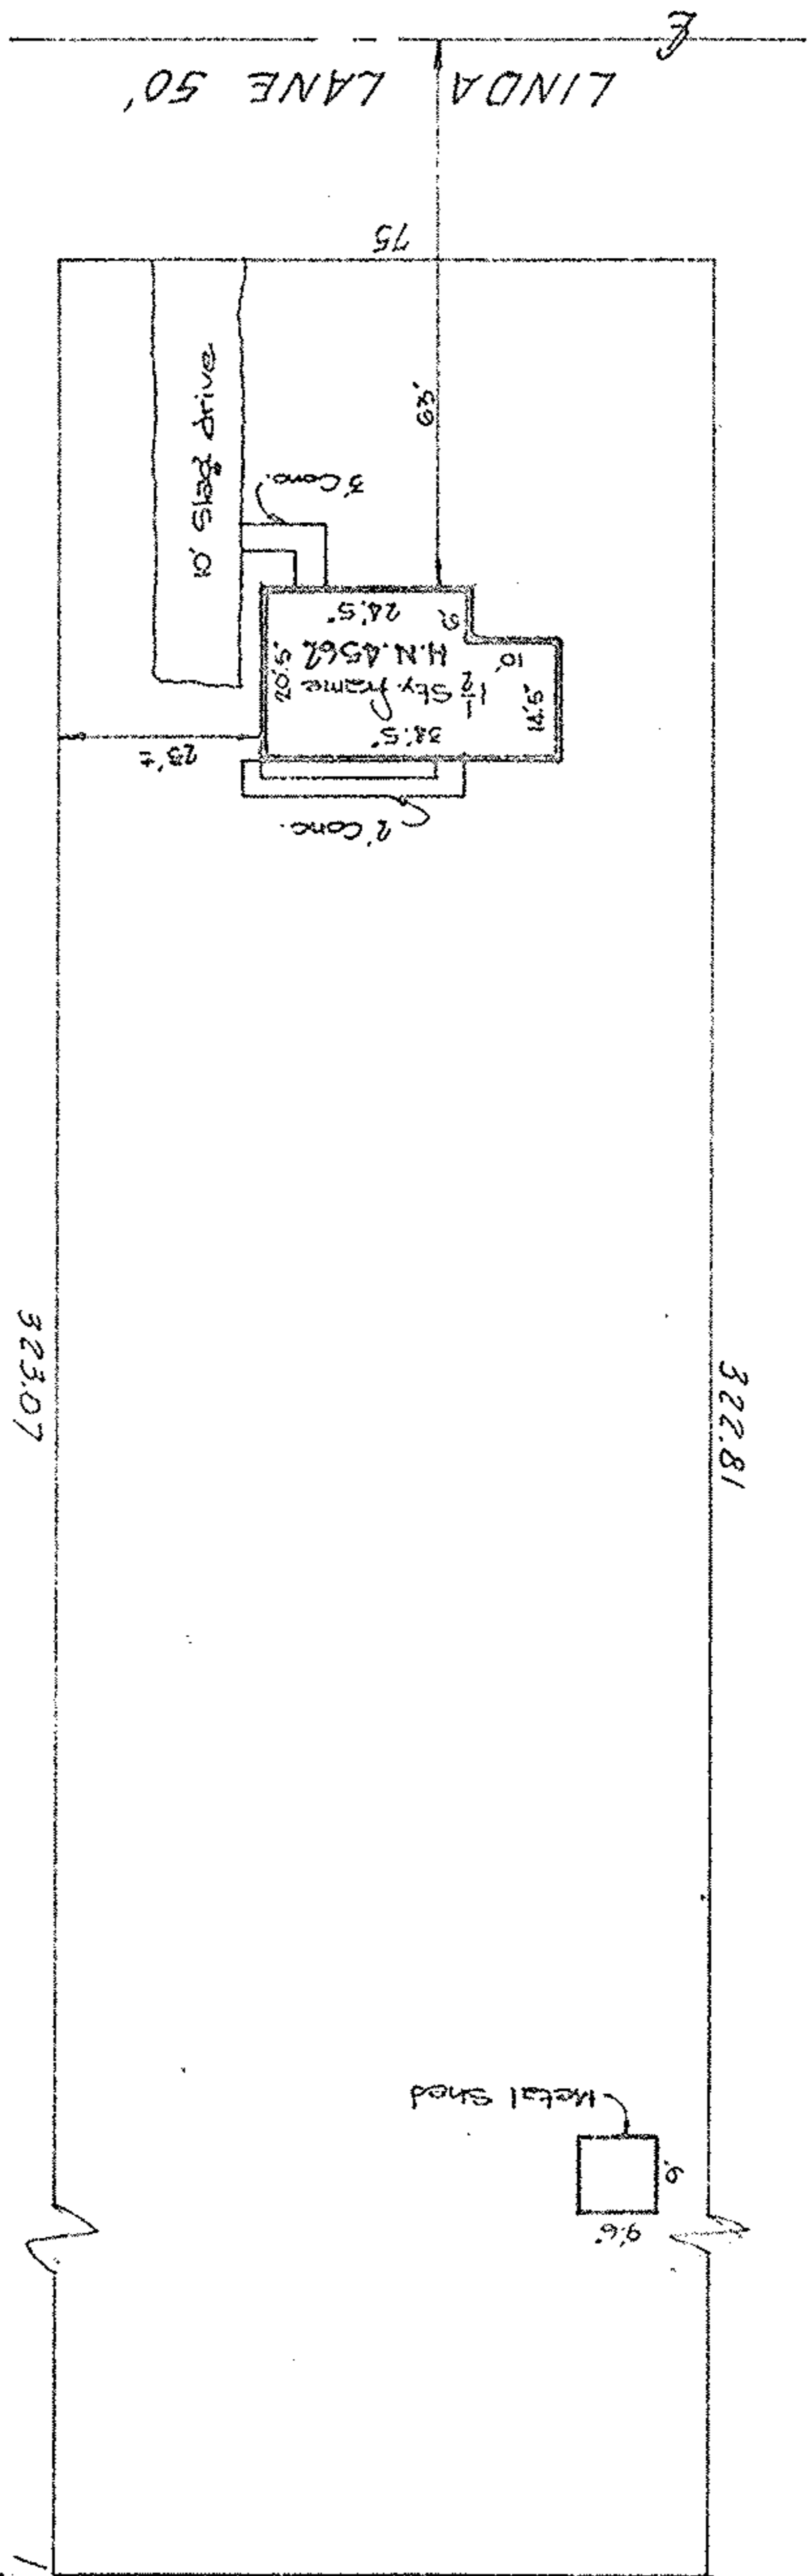

MC GLINCHY & ASSOCIATES
 MAY 28, 1976 #76981

DAK
 PARK
 ALLOT.
 VOL. 12, PG.
 WRIGHT
 AVE

17 HAS 052