



THIS PARCEL FROM A
 MAP OF SURVEY BY
 C.T. BIGGS OCT. 7, 1957
 FURNISHED BY OHIO BAR TITLE

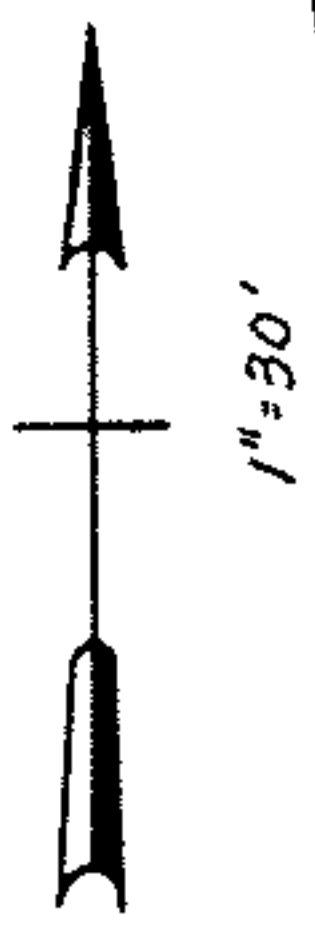

THIS PARCEL
 OUT
 VOL 716, PG 578

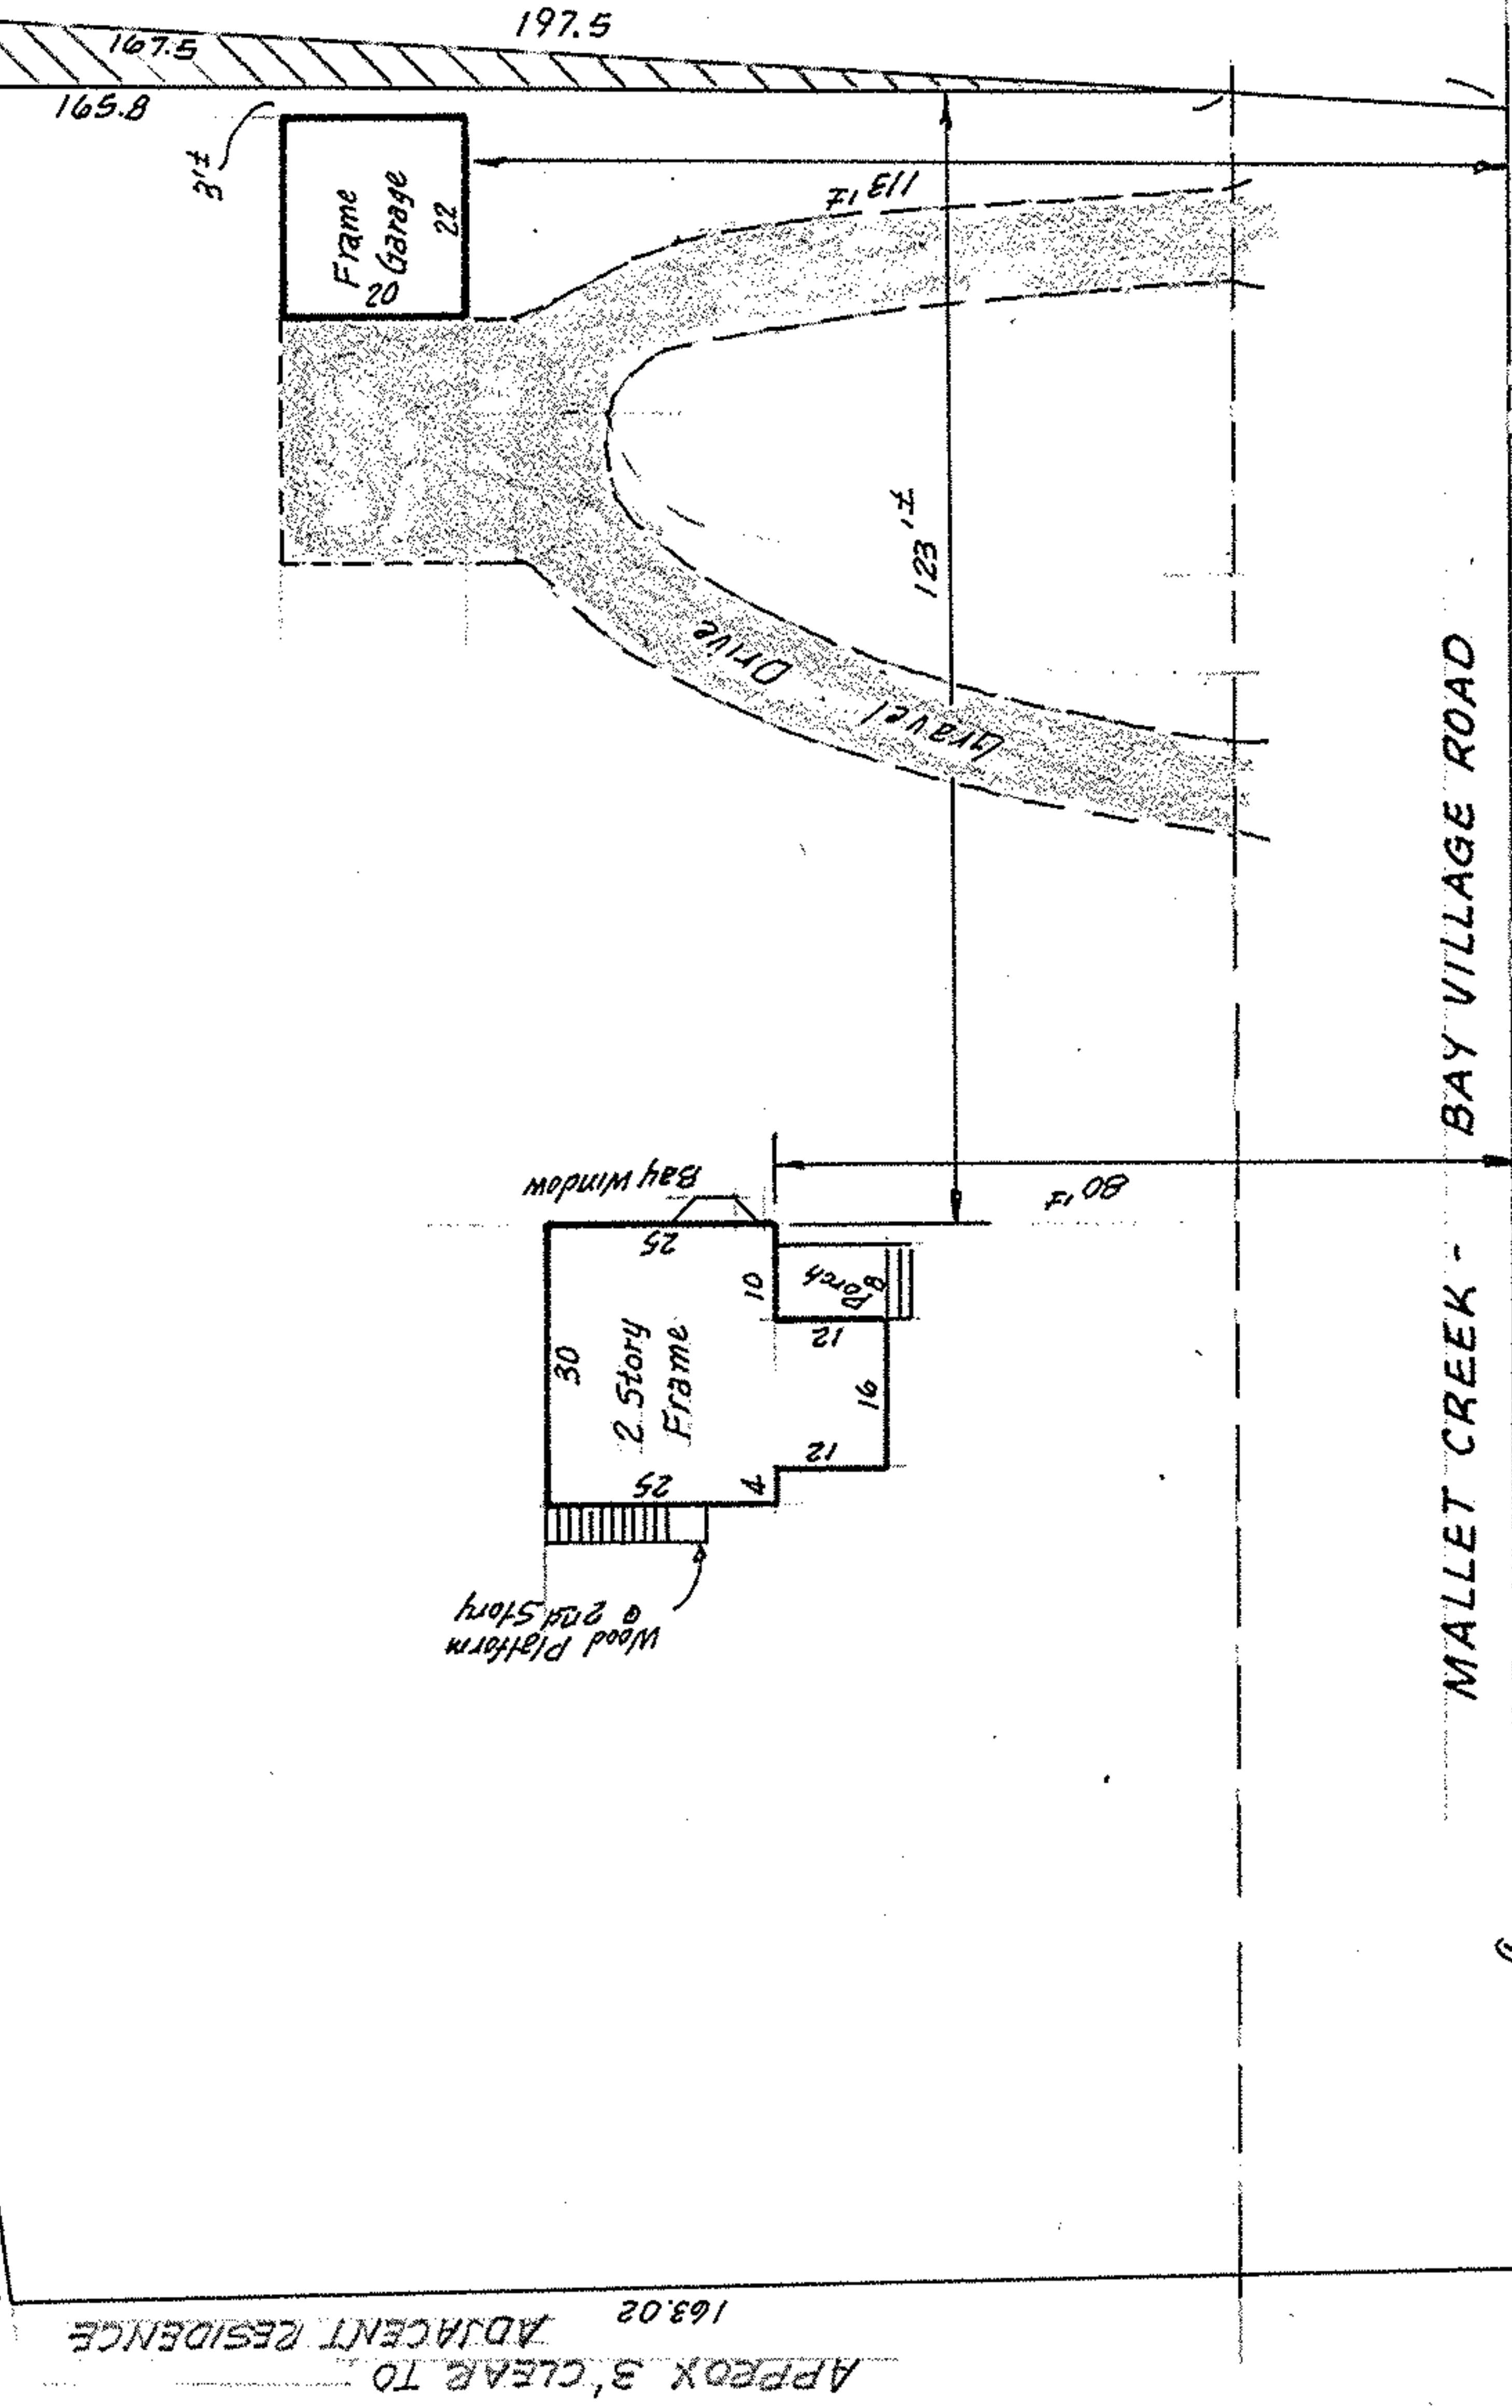

APPROX 3' CLEAR TO
 ADJACENT RESIDENCE 163.02

MALLET CREEK - BAY VILLAGE ROAD
 AKA EAST RIVER RD 233.5 & S.R.252

PART OF P.P. # 12-00-037-000-007
 PART OF ORIGINAL COLUMBIA TWP LOT 37
 LORAIN COUNTY, OHIO

McGLINCHY & ASSOCIATES
 AUG. 27, 1978 # 784024
 ELYRIA OHIO BAR #