

LAKE ROAD 60'

CROSS CUT IN CONC. DRIVE

CONCRETE DRIVE  
ENCROACHES FROM  
PARCEL WEST

RADWAY ALLOTMENT  
VOL 17, PG 10


10' EASEMENT

P4 Block 'C'  
3.5383 Ac

LINCOLN BOULEVARD 50'  
UNIMPROVED

SUBLOT NOS. 6 & 7 of RADWAY ALLOTMENT  
PLAT VOL. 17, PAGE 10  
PART of BLOCK C of RADWAY ALLOTMENT 2ND ADDIT  
PLAT VOL. 17, PAGE 16  
ALL PART of ORIGINAL SHEFFIELD TWP LOT 36  
NOW IN CITY of SHEFFIELD LAKE OHIO

MAP of SURVEY  
PREPARED FOR:  
CARDINAL INDUSTRIES DEVELOPMENT CORP  
2040 SOUTH HAMILTON ROAD  
COLUMBUS, OHIO 43227

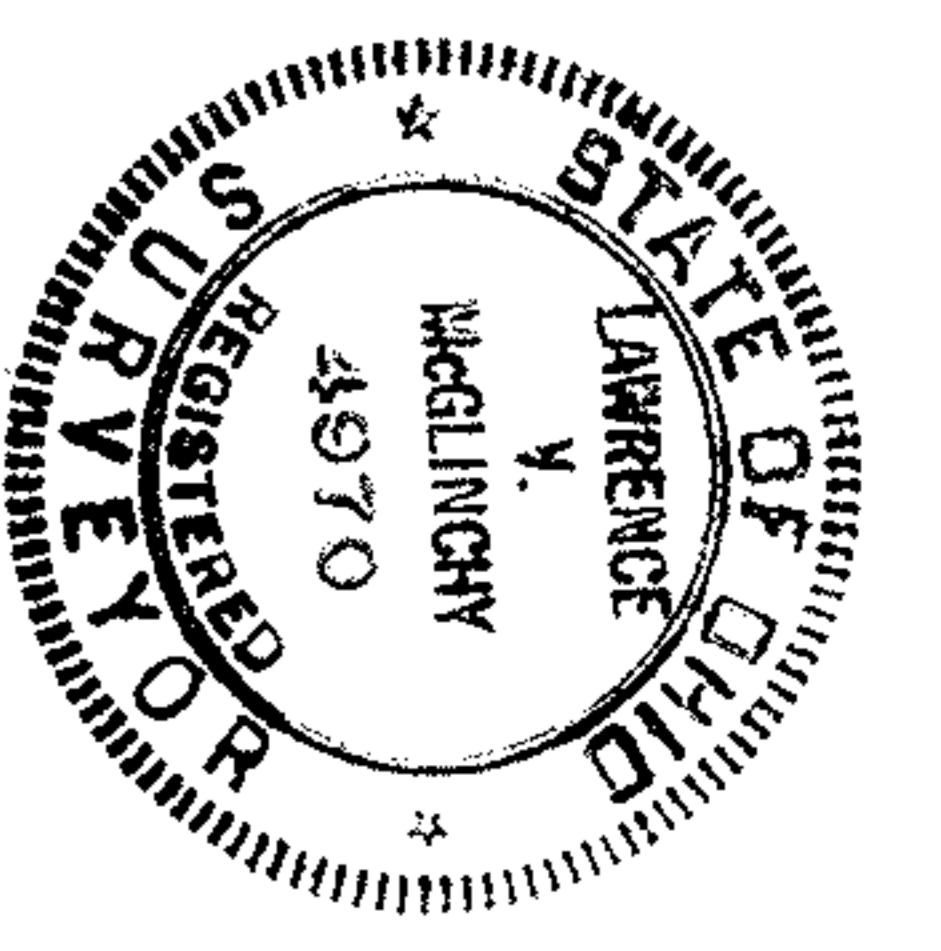

S.L. 103      102      101      100  
RADWAY ALLOT. 2ND ADDIT  
VOL 17, PG 10

