


NORTH

LAKE ROAD - 60'

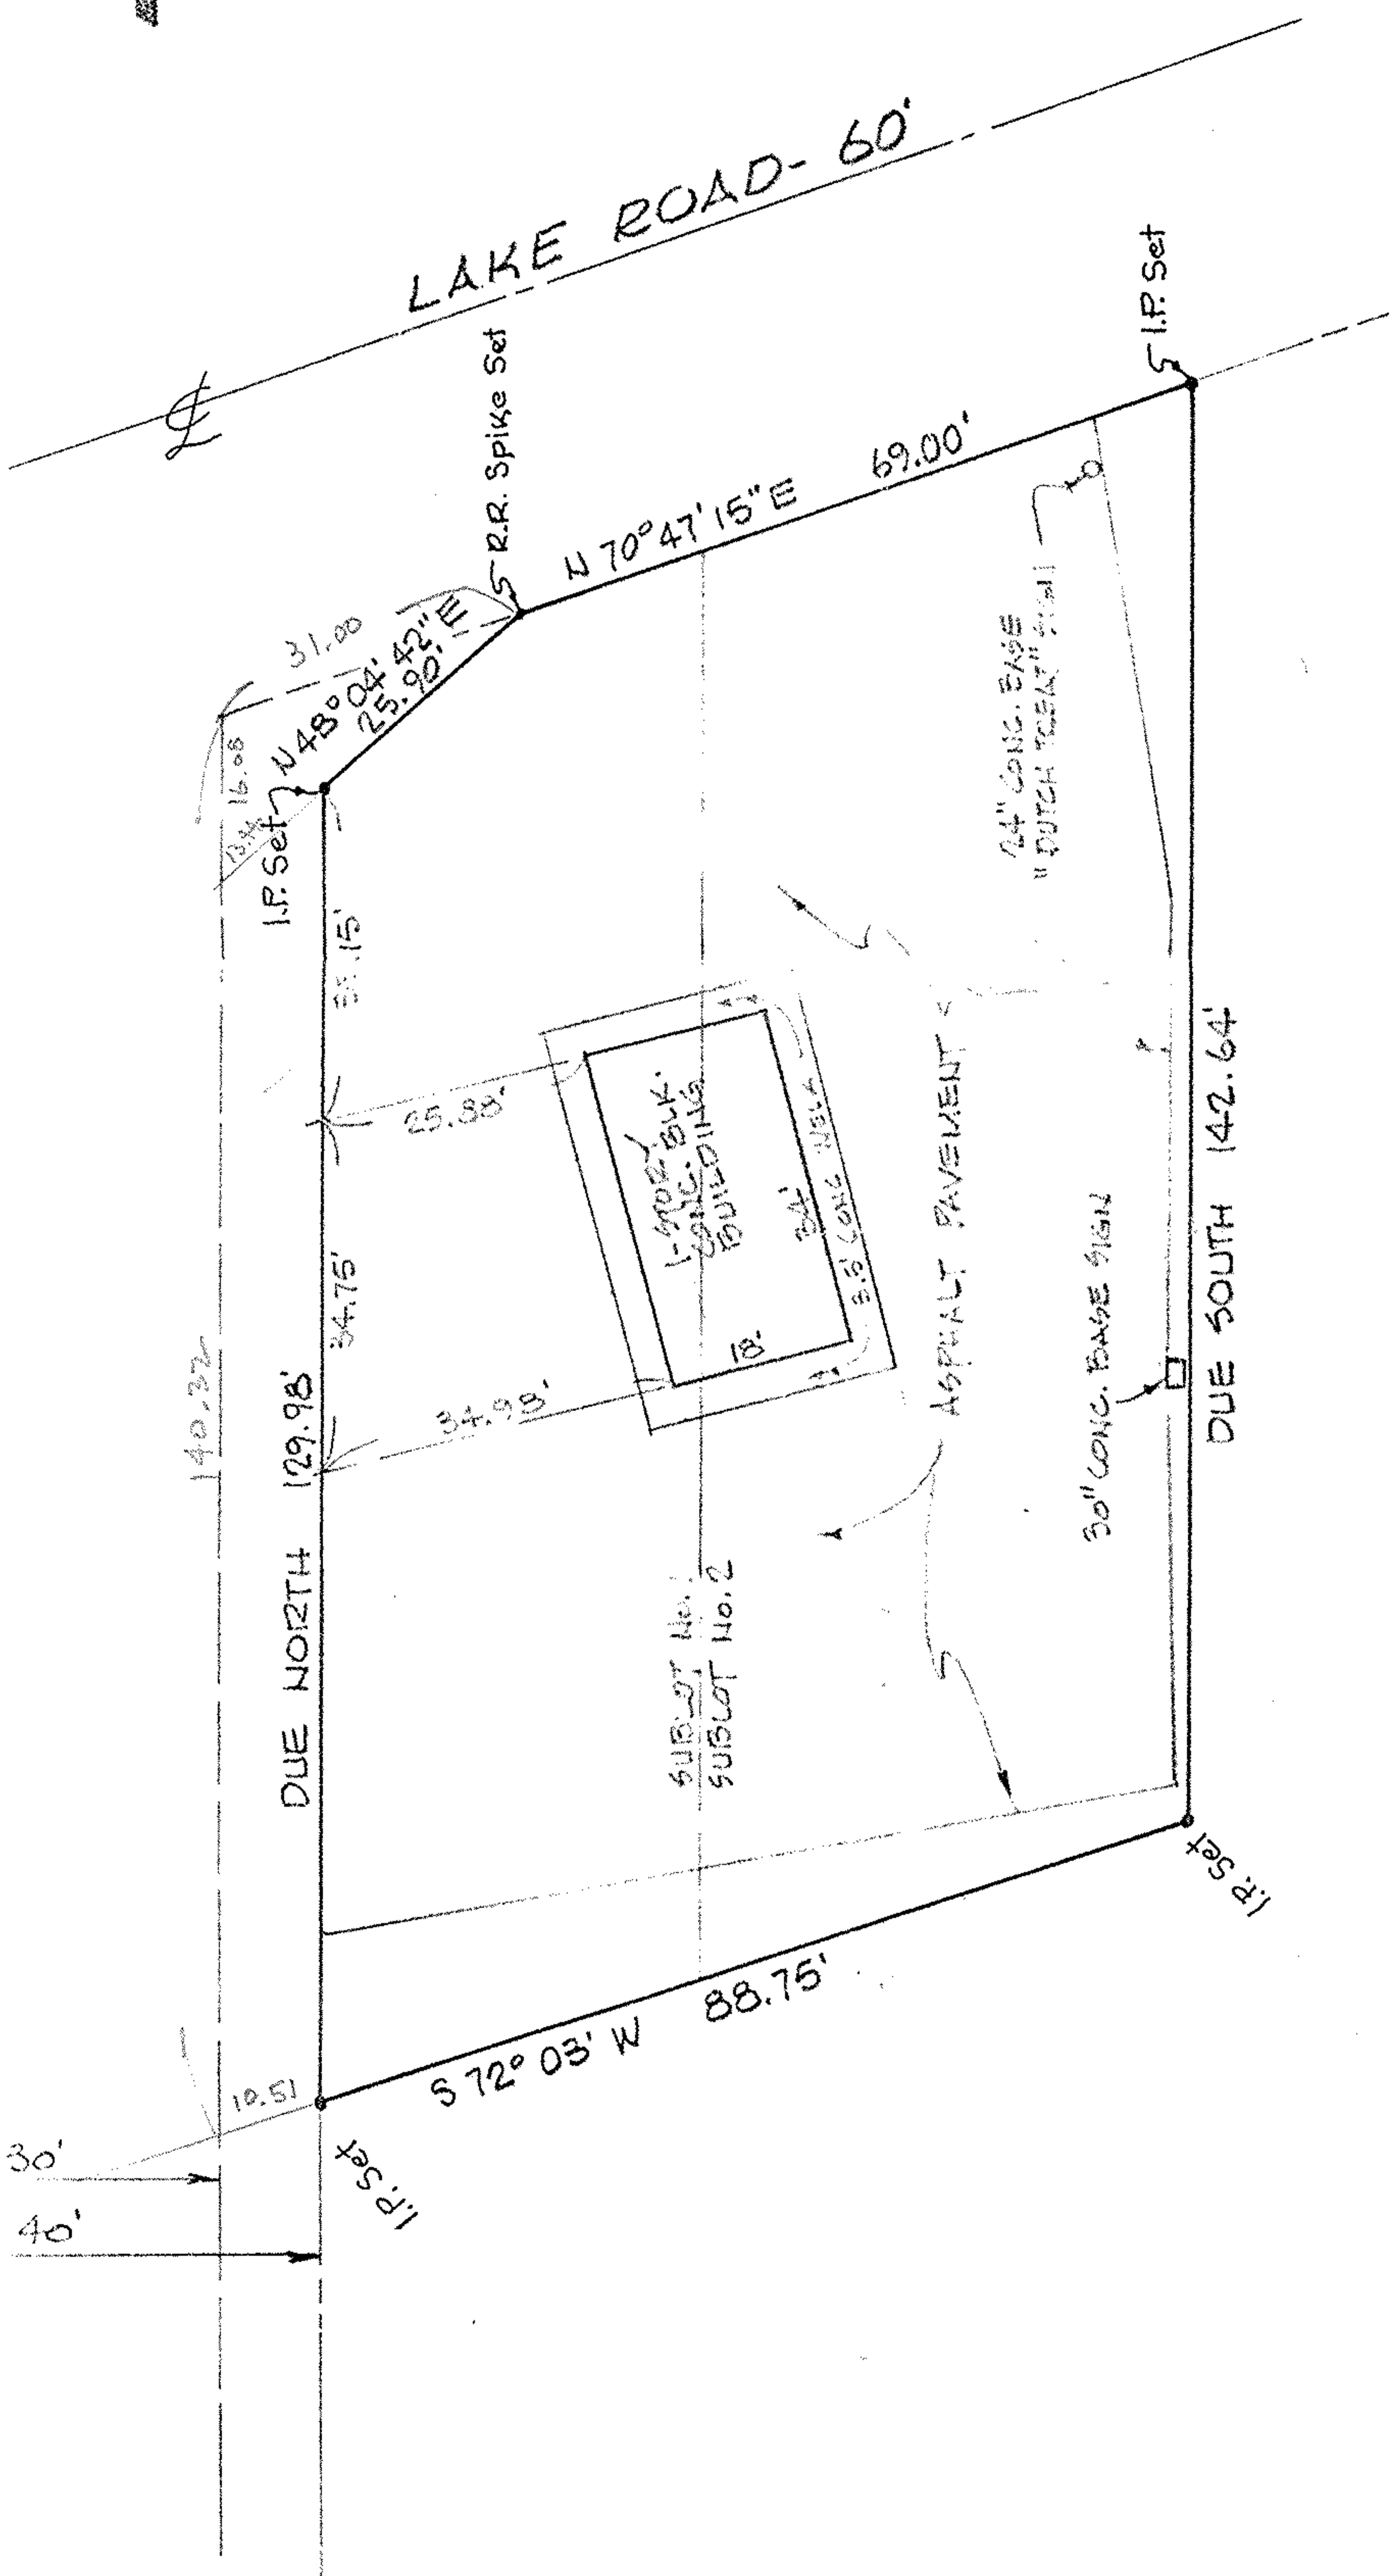

MAP of SURVEY

PREPARED FOR GEORGE FRAM

PART of SUBLOT No. 1 and ALL of SUBLOT No. 2 in SUNSET COUNTRY CLUB ALLOTMENT (BLOCK - B) - PLAT VOL. 11, PG. 6