


Photo →

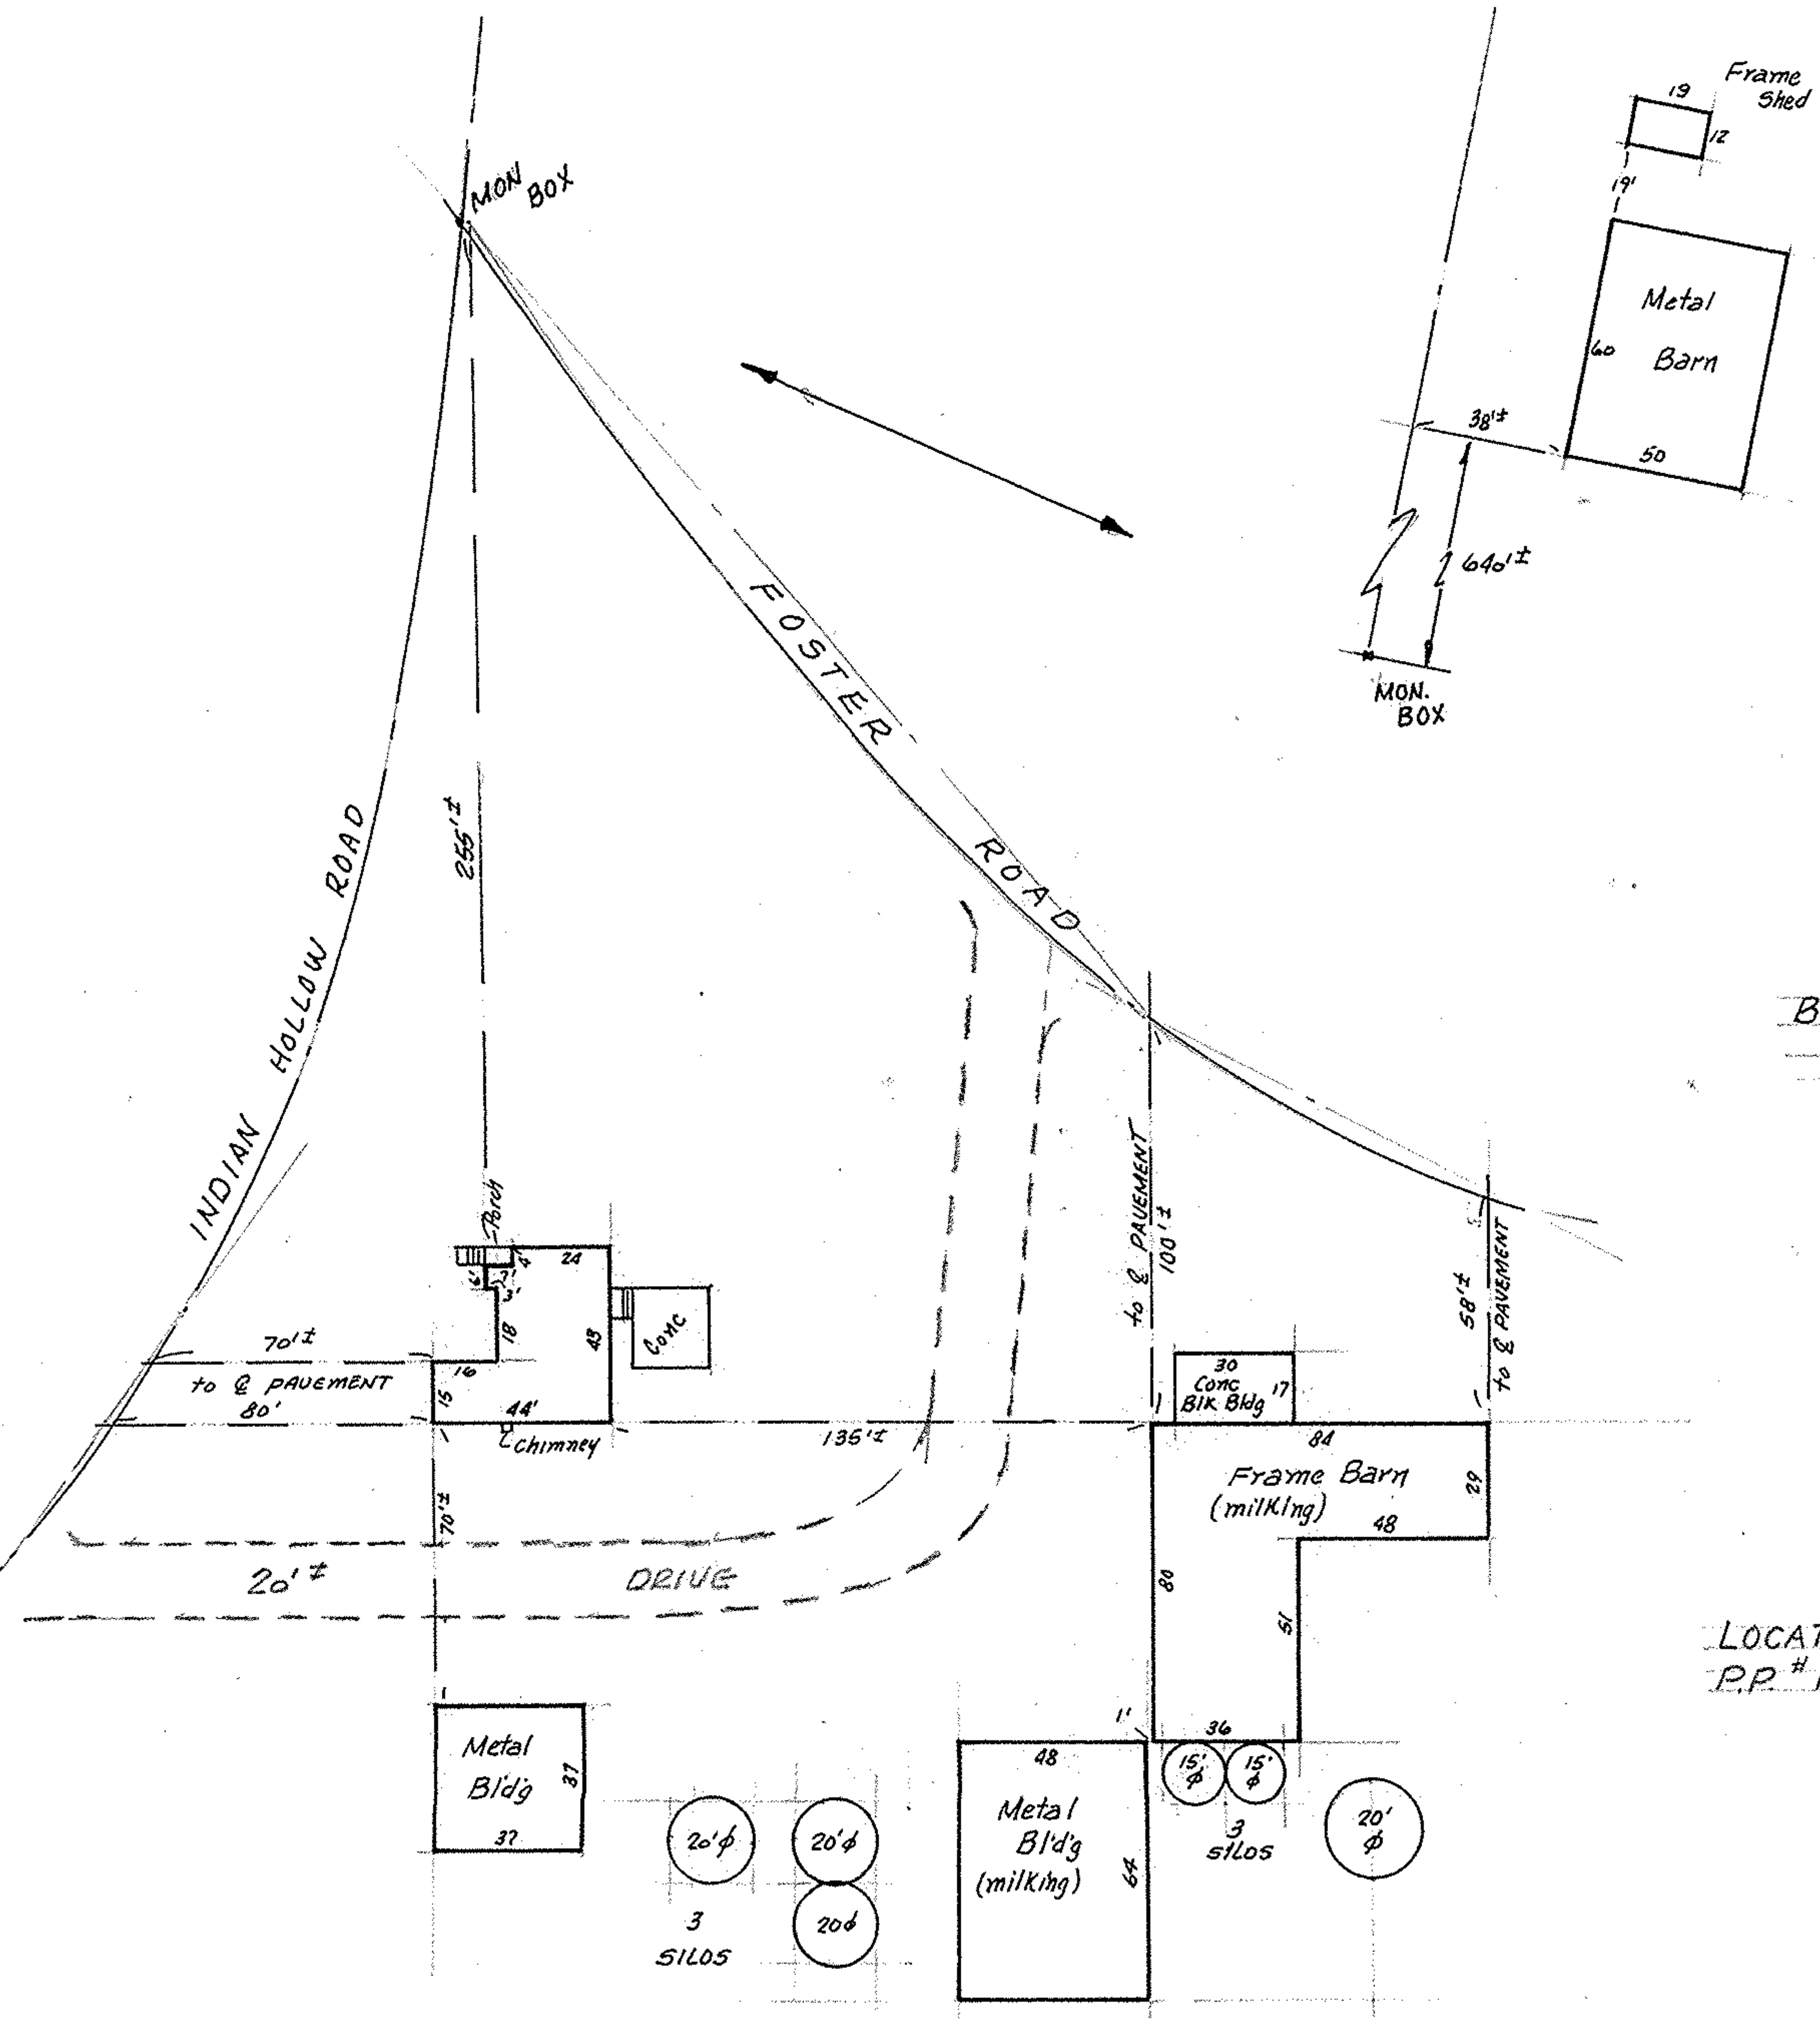

LOCATED IN
P.P. # 19-06-003-000-006

BUILDING LOCATION PLAN
1" = 50'±

LOCATED IN
P.P. # 19-06-004-000-003

THIS IS NOT A PLAT OF SURVEY

McGLINCHY & ASSOCIATES INC.
APRIL 11, 1983 # 837642

C.T.I.C. E 184-666

SH 2 OF 2