




CERTIFICATE OF CORRECTION
"EXHIBIT A"



David L. Elwell
 REG. SURV. NO. 6333

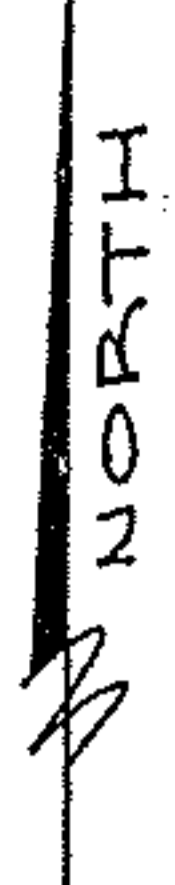

SCALE: 1" = 100'

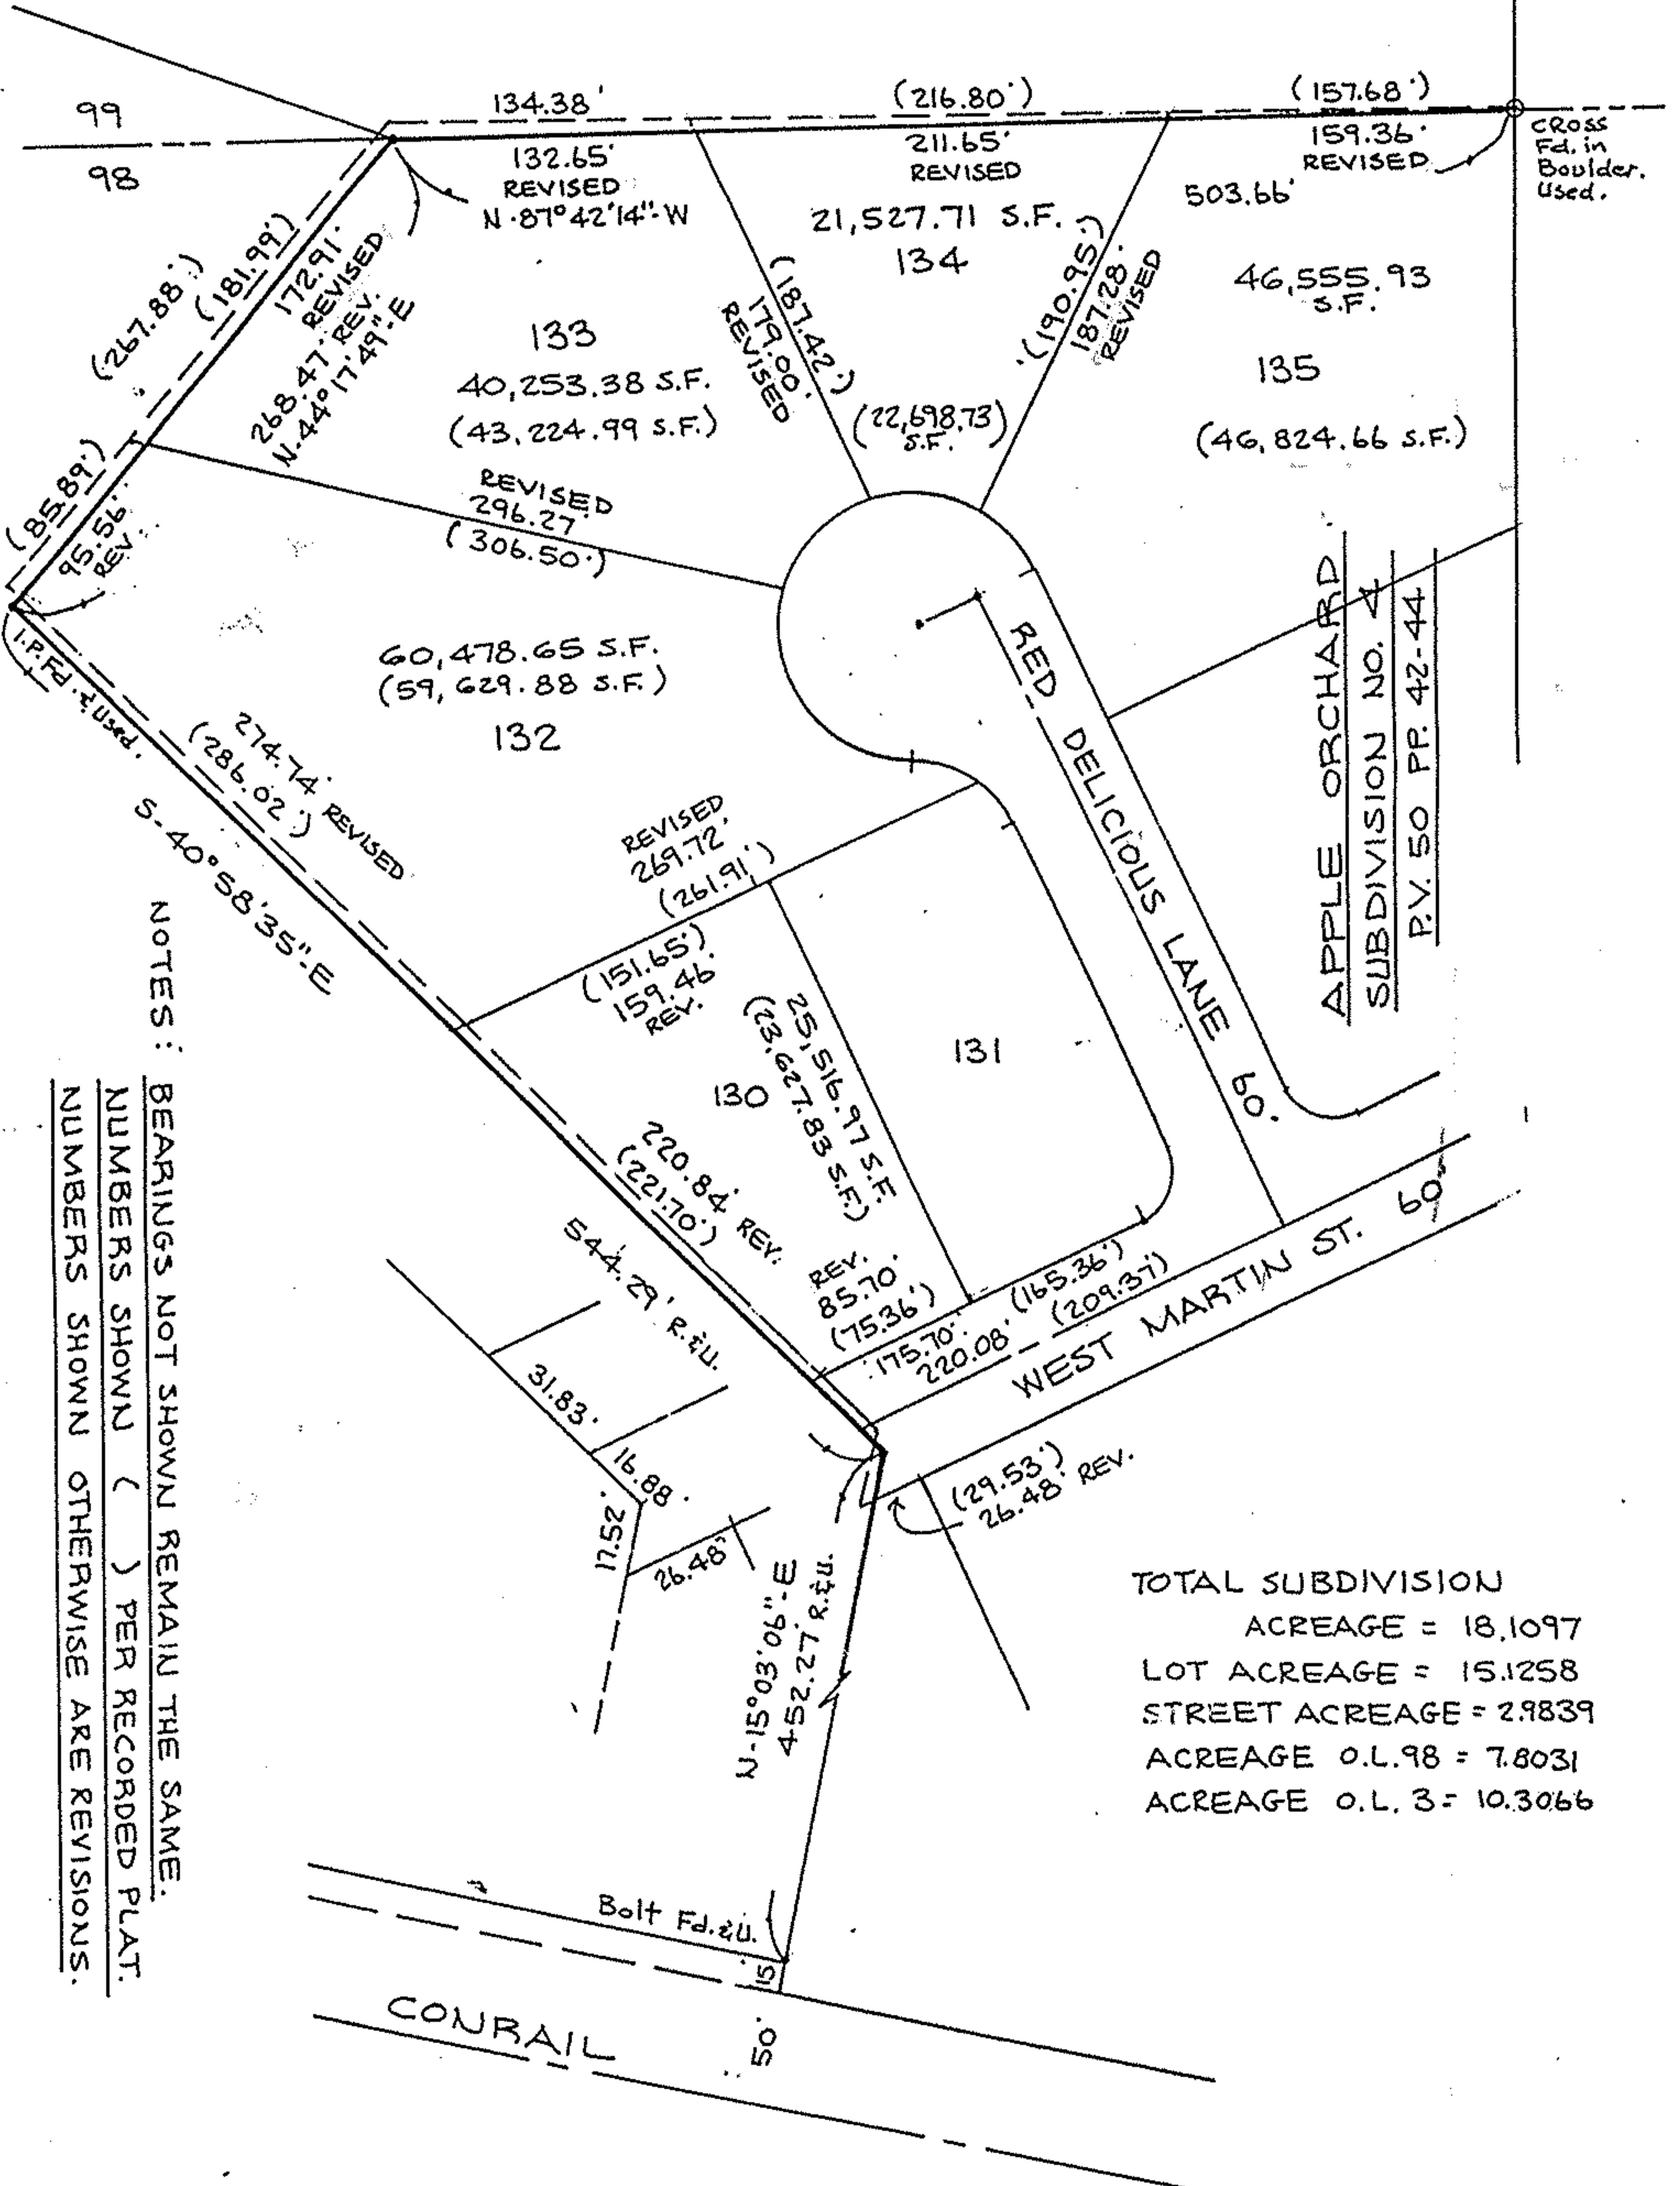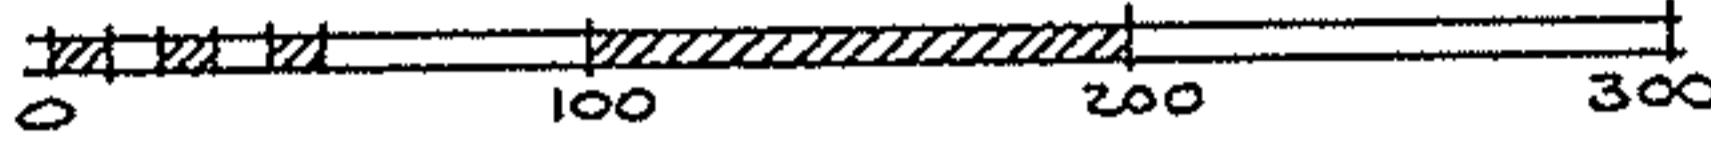

NOTES: BEARINGS NOT SHOWN REMAIN THE SAME.
 NUMBERS SHOWN () PER RECORDED PLAT.
 NUMBERS SHOWN OTHERWISE ARE REVISIONS.

TOTAL SUBDIVISION
 ACREAGE = 18,1097
 LOT ACREAGE = 15,1258
 STREET ACREAGE = 2,9839
 ACREAGE O.L. 98 = 7,8031
 ACREAGE O.L. 3 = 10,3066