

No 01688

PLAT OF BOUNDARY SURVEY  
CLARK IMPROVEMENT CORP.

PART OF ORIGINAL TOWNSHIP LOT 96, RUSSIA TOWNSHIP,  
CITY OF OBERLIN, LORAIN COUNTY, OHIO

APPROVED  
LORAIN CO.  
MAP DEPT  
DATE 6/28/04  
PAGE 9-00 096-A  
BY JHaffield  
#04-01688


Legend

- ⊗ Spike Found
- △ Iron Pin Found
- Pipe Found
- ⊙ Nail Set
- ⊕ Magnetic PK Spike Set
- ▲ 5/8" Iron Pin Set with Cap Stamped "Kelsner 7871"

EDISON STREET

S. PLEASANT STREET

MAIN STREET • STATE ROUTE 58

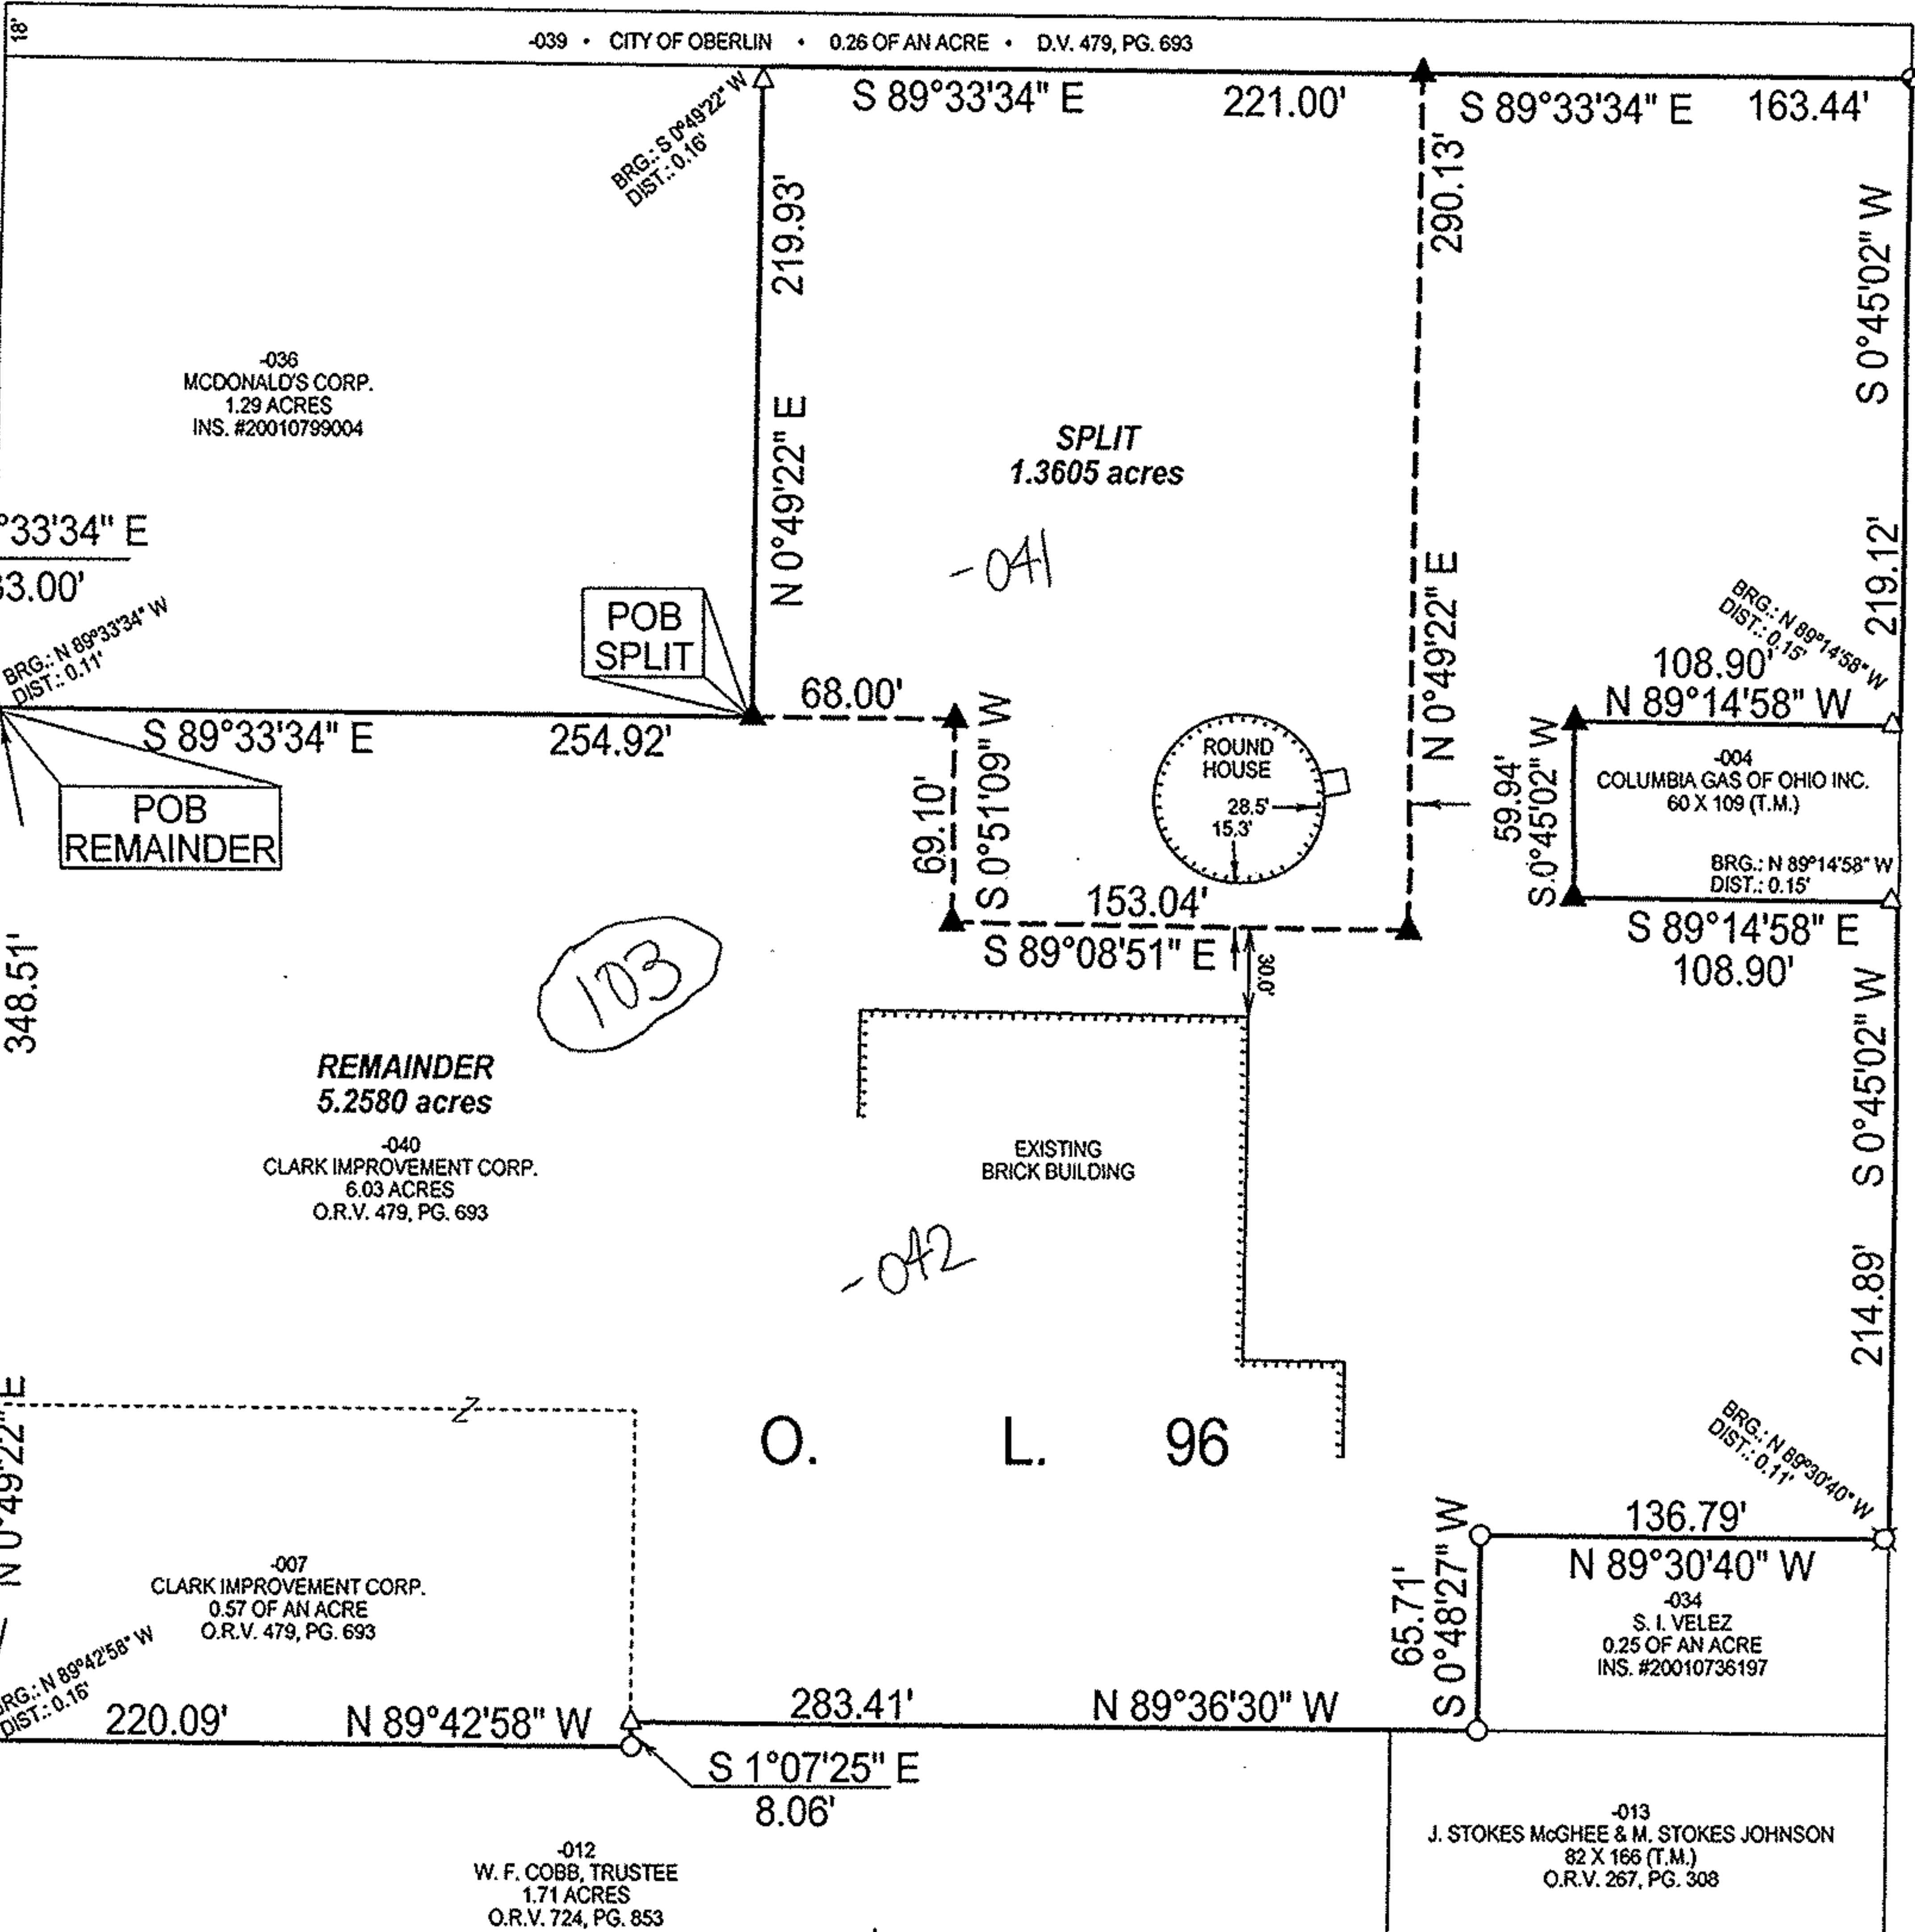


103

-042

-041

SCALE 1"=80'

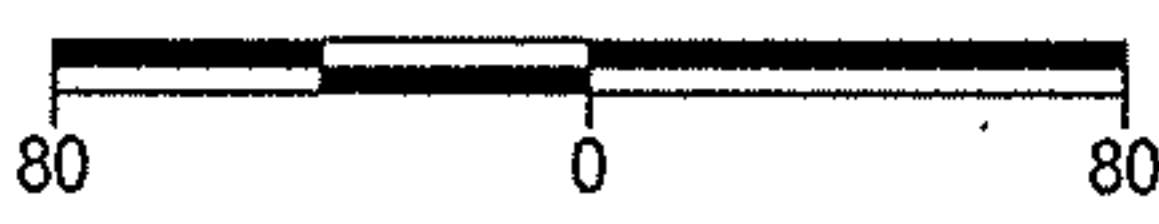

BEARINGS ARE ASSUMED.

ERROR OF CLOSURE IS LESS THAN 1:10,000.



LAUNDON • SIMON • KELSER & ASSOC., INC.  
 PROFESSIONAL LAND SURVEYORS  
 110 MIDDLE AVE. • ELYRIA, OHIO • 44035  
 PHONE (440) 322-7625  
 Alex Kelsner  
 RLS #7871

DATE: 5/14/03  
 JOB NO.: 03-3596