

VERMILION RIVER

Top of Bank

APPROVED	
LORAIN CO.	
MAP DEPT.	
DATE 9-22-78	
PAGE 1.00-051-A	
BY T. McLean	
VOID	
AFTER	

PARCEL B -041  
1.05 ACRES 1.05

PARCEL A -040  
1.78 ACRES 1.78 A

~~1.38~~  
~~2.83A~~

S 19°34' E 235.1'  
198.00'

N 30°40' W 231.15'  
255.1'

N 30°40' W 291.1'  
284.34'

1178.15'

215.00'

286.53'


N 65°26' E 501.53'

NORTH RIDGE ROAD - 66'

P.P.N  
01-00-051-000-041,040

MAP of PROPOSED PARCEL SPLIT  
PREPARED FOR PAUL M. PUSTAY  
PART of ORIGINAL BROWNHELM TWP LOT No. 51  
TOWNSHIP of BROWNHELM, LORAIN COUNTY, OHIO

NORTH  
SCALE: 1" = 30'

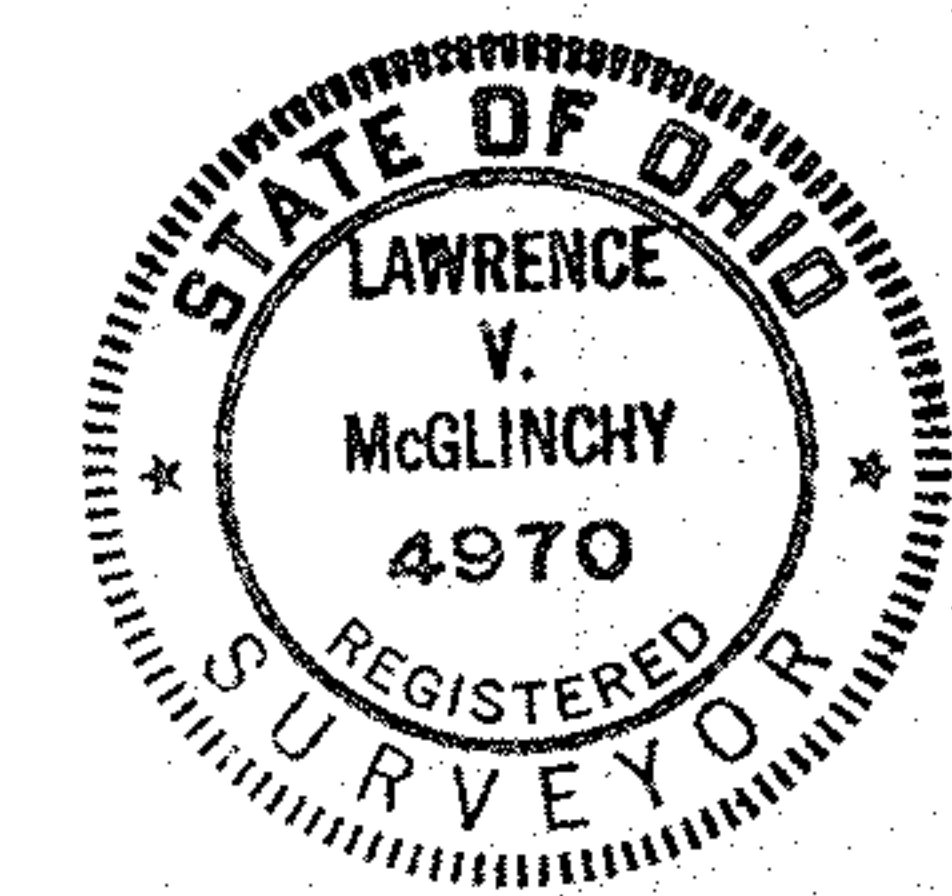

McGLINCHY and ASSOCIATES  
PROFESSIONAL ENGINEERS & SURVEYORS  
ELYRIA OHIO  
AUGUST, 1978 #183999