


Joseph J. & Cecilia E. Falencki

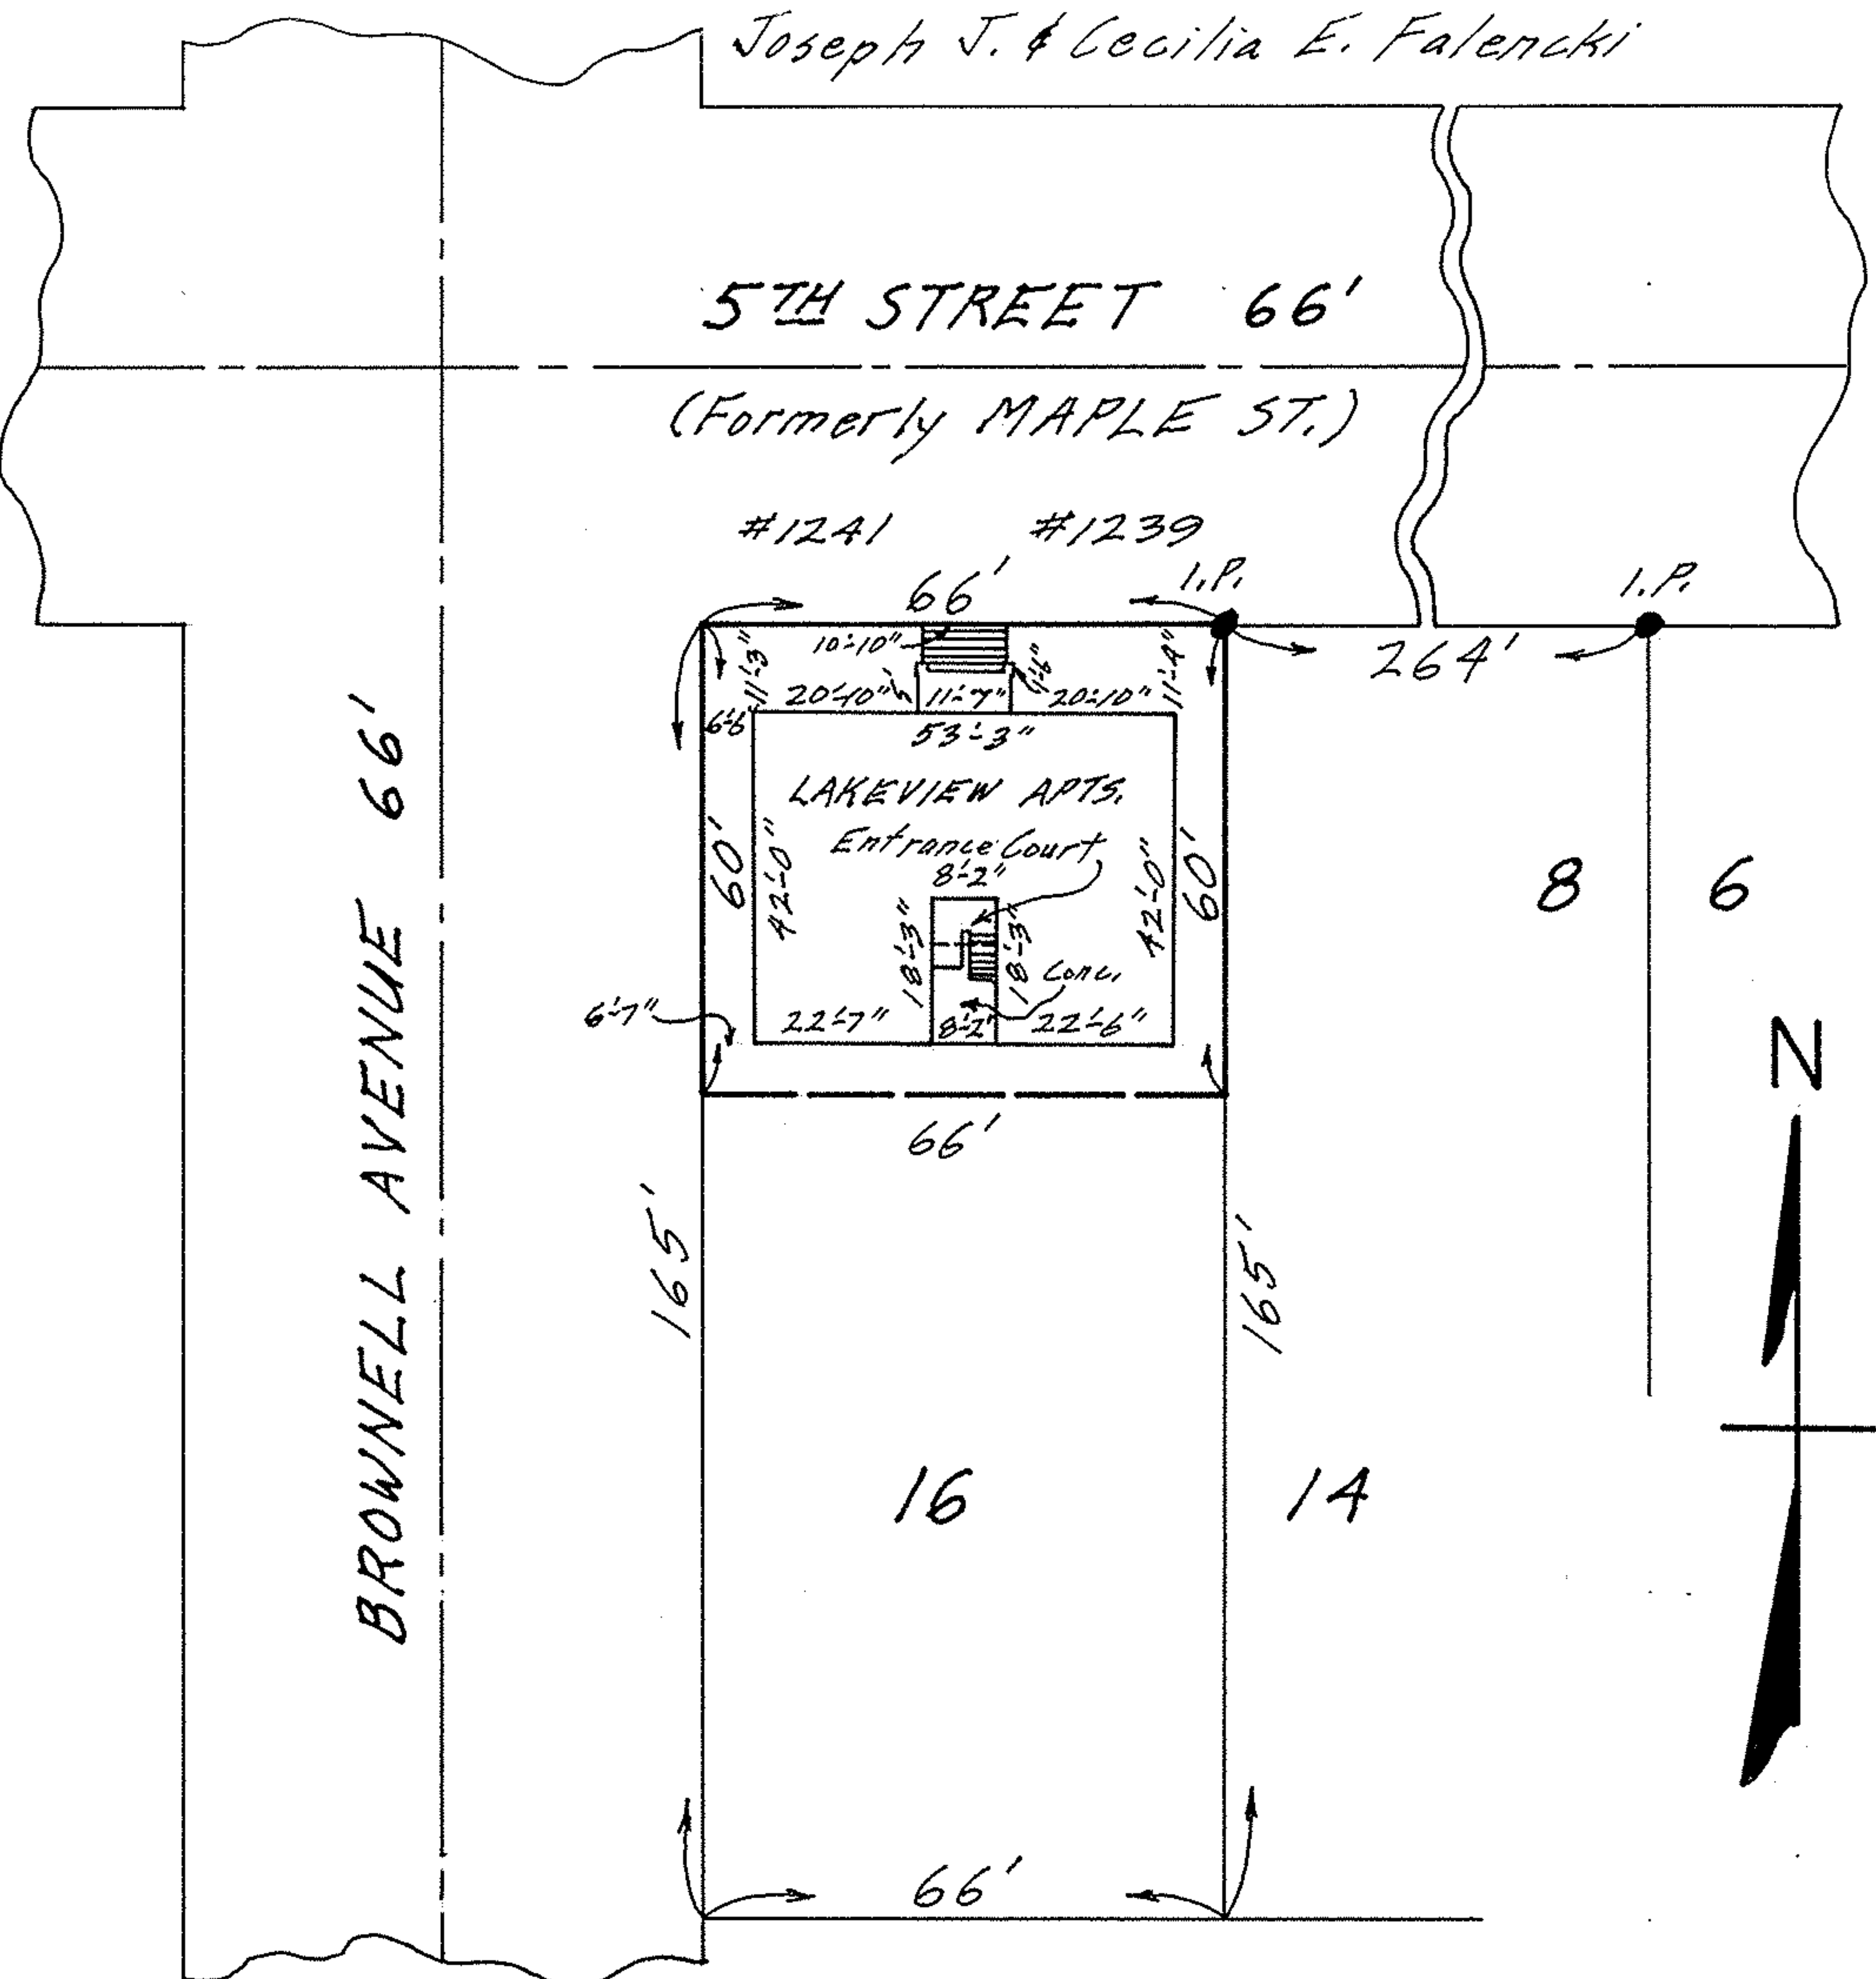

MAP OF NORTHERLY 60 FEET OF SUB-LDT NO. 16 OF  
 BLOCK NO. 6 OF BROWNELL'S 1ST ADD'N. Vol. 2 Pg. 9  
 ORIG. LOT 26 - TRACT 2 - BLACK RIVER TWP.  
 LORAIN CITY - LORAIN COUNTY - OHIO  
 SCALE: 1" = 30' DEC. 4 - 1967 11:30 A.M.  
 Gary E. Penfound REG. SURVEYOR