



BROWNELL AVENUE 50'

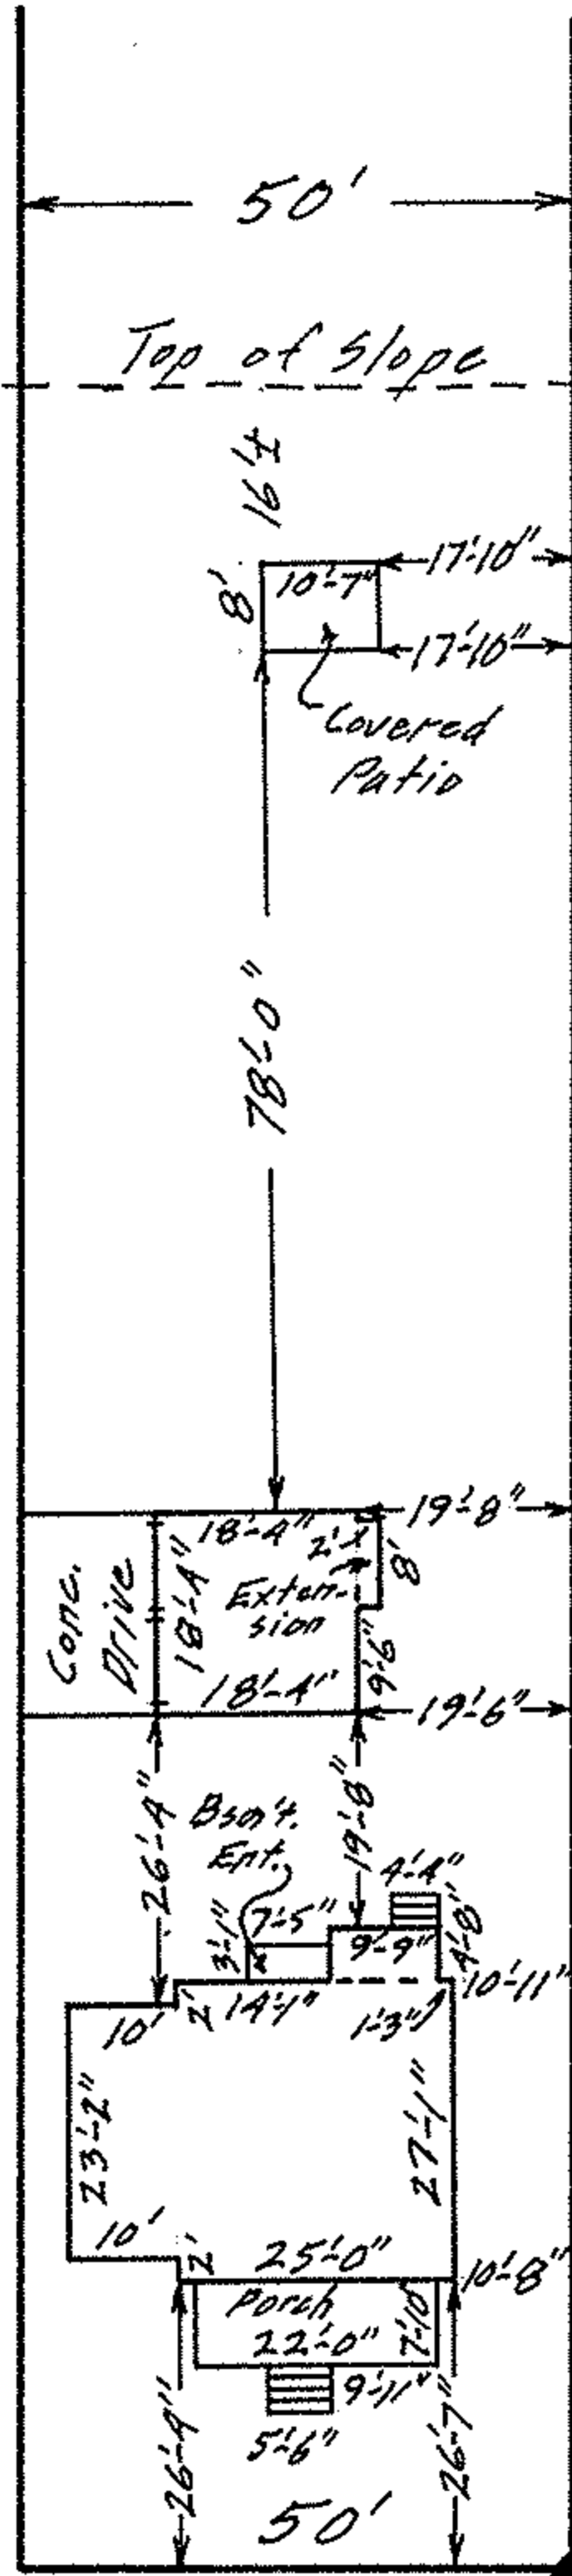

MAP OF PART OF ORIG. LOT 26-
 TRACT NO. 2 - BLACK RIVER TWP.
 LORAIN CITY
 LORAIN COUNTY OHIO
 SCALE: 1"=30' JUNE 30-1966 4:00 P.M.
 Gary E. Penfound RES. SURVEYOR

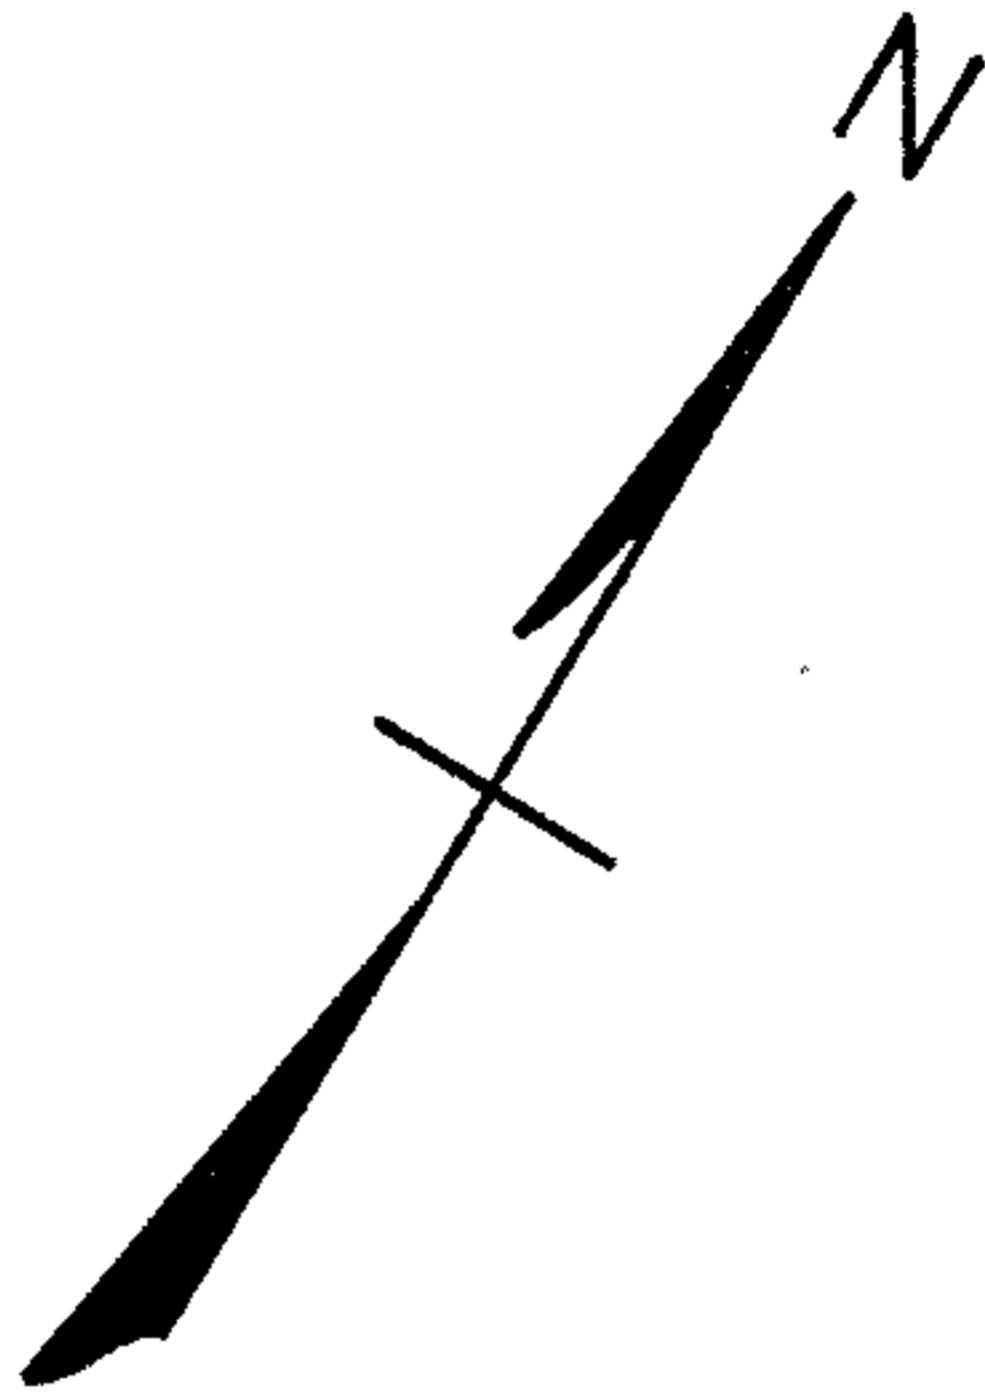

SECOND STREET

50'

Naomi N. Long

02-02-026

PC