


CITY TITLE Co. Order No. E-810-11
 Paul & Linda K. Salvador to
 Harvey Joe & Constance Bookins

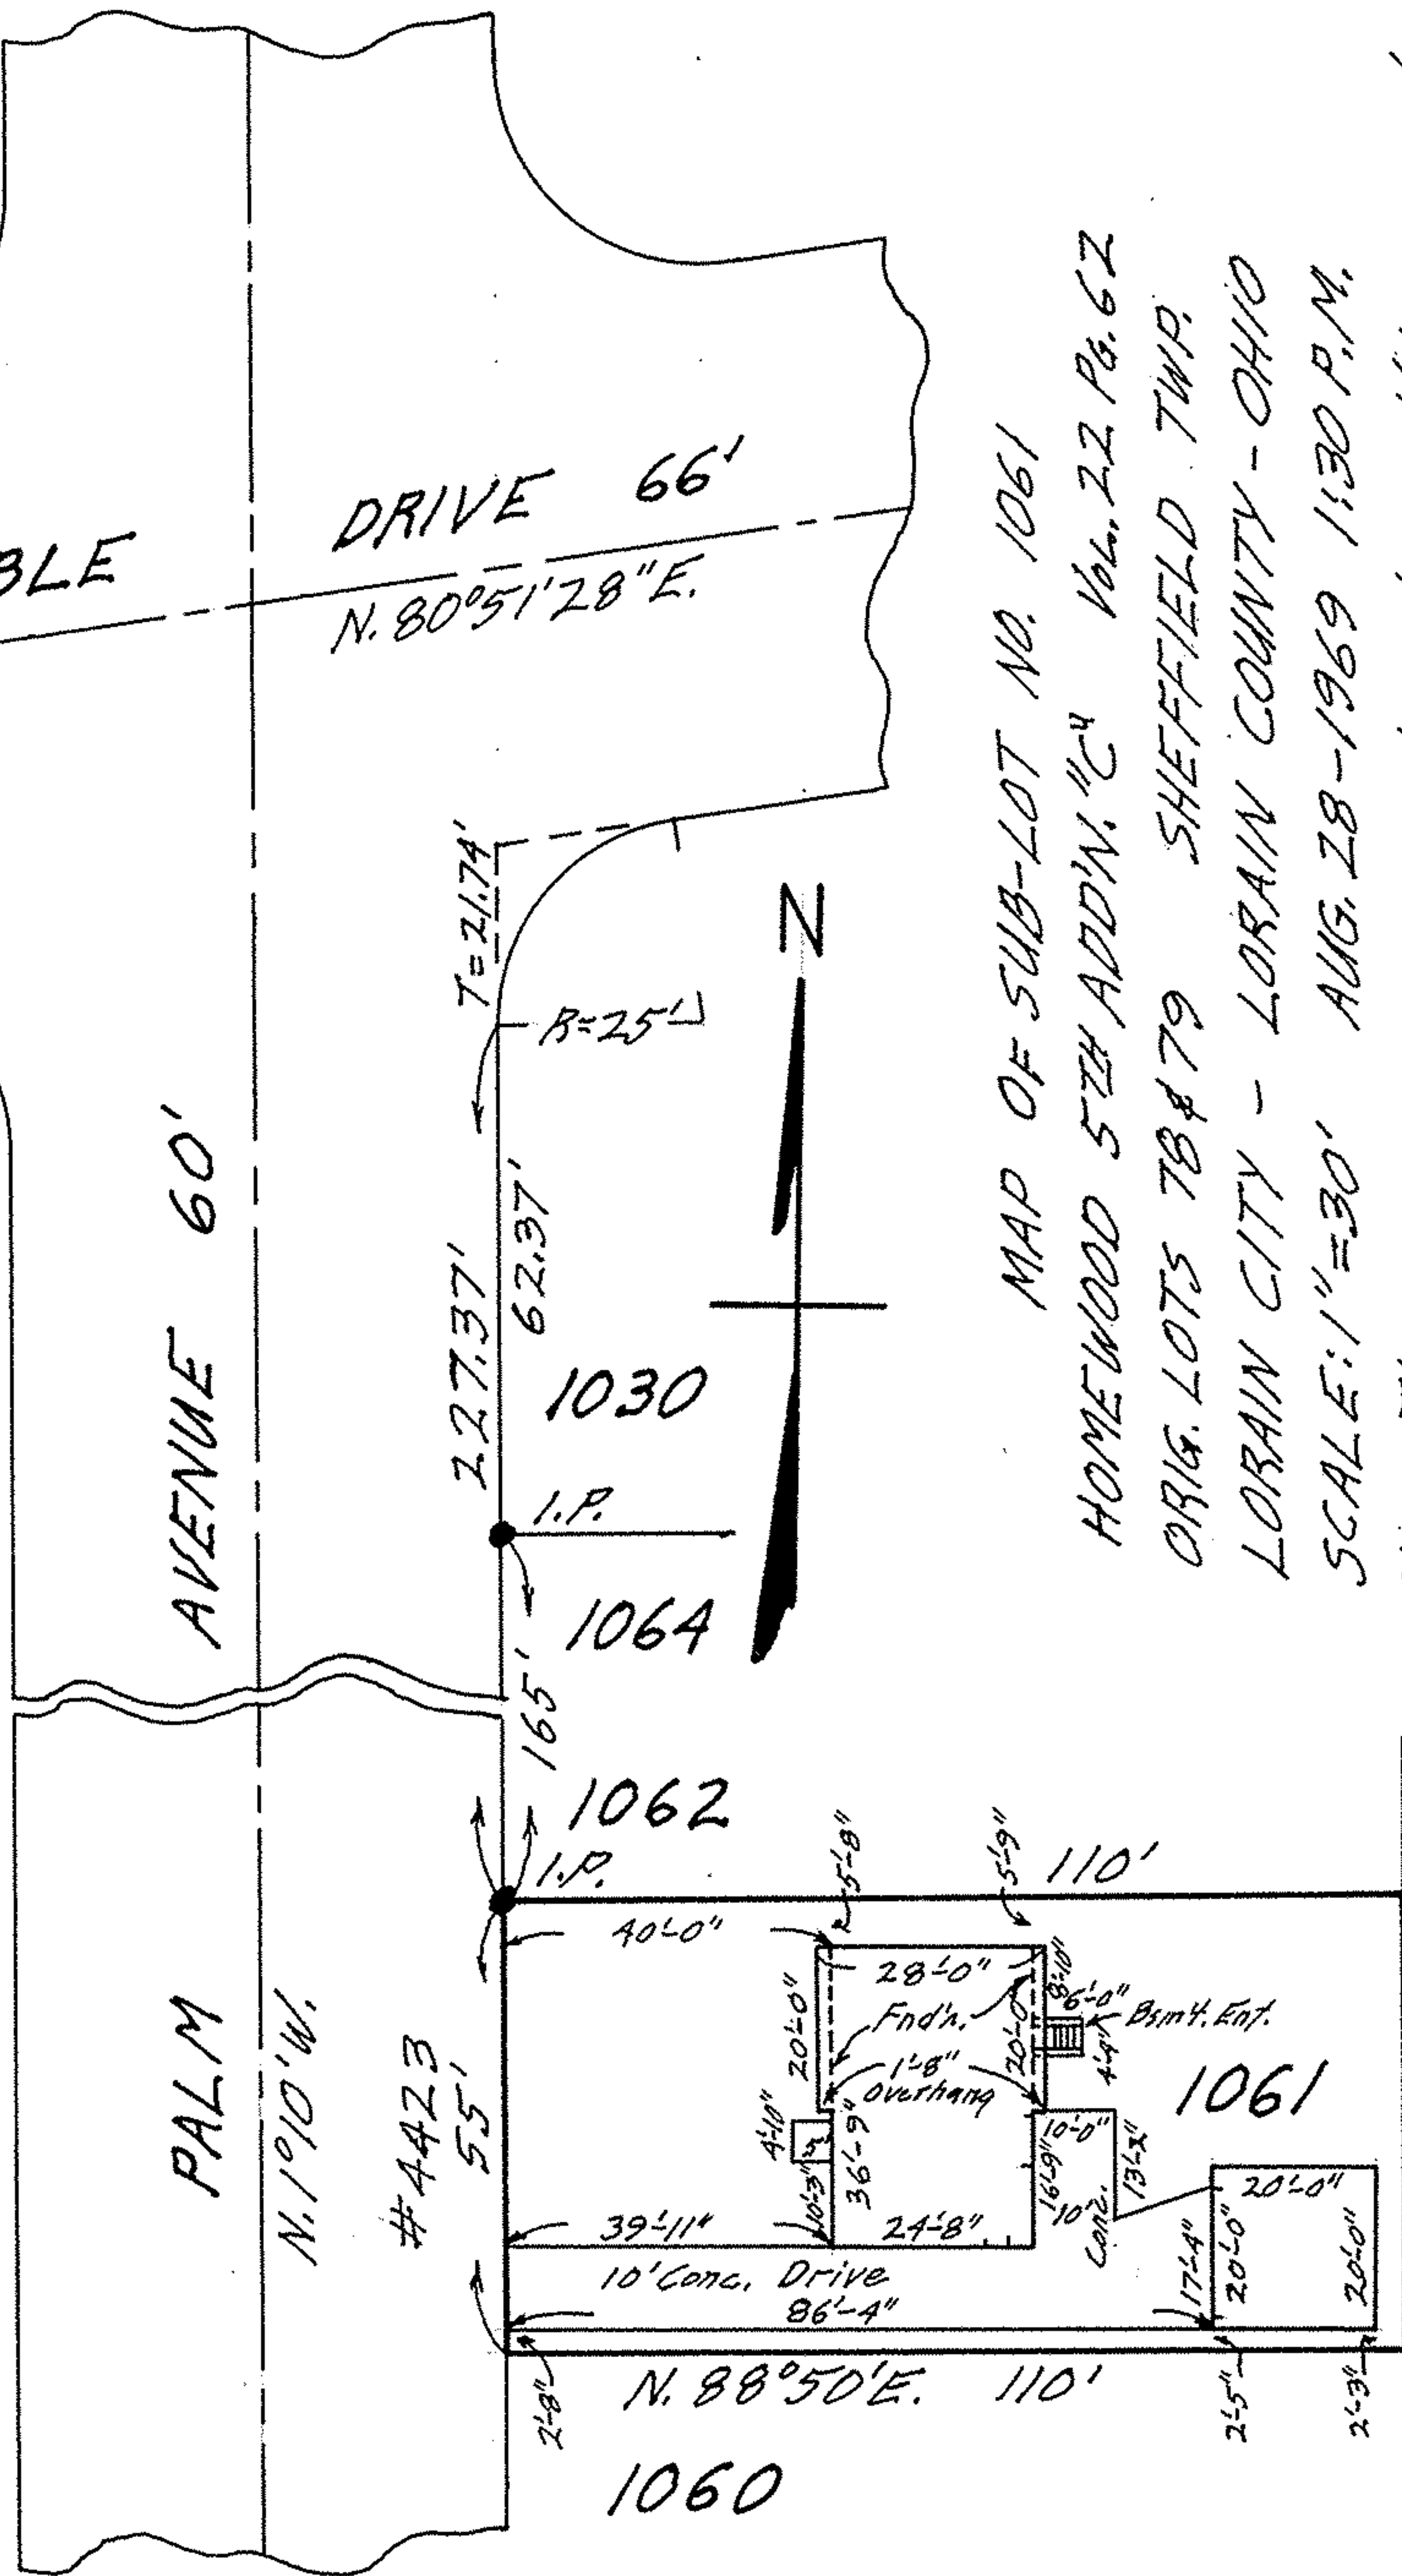

MAP OF SUB-LOT NO. 1061
 HOMEWOOD 5TH ADD'N. "C" Vol. 22 Pg. 62
 ORIG. LOTS 78 & 79 SHEFFIELD TWP.
 LORAIN CITY - LORAIN COUNTY - OHIO
 SCALE: 1" = 30' AUG. 28 - 1969 1:30 P.M.

NOTE: There are no encroachments on this property.
 Mary E. Penfound REG. SURVEYOR NO. AA57