

EAST 41<sup>ST</sup> STREET 50'

N. 88° 50' E.

# 2472

65'

I.P.

70'

65'

I.P.

T=25'

A=39.27'

B=25'

45'

6"

15'

53'-6"

Asphalt Drive  
Encroaches onto 3/4 344

Asphalt Drive

44'-7"

44'-7"

9'-10"

5'-0"

15'-6"

36'-1"

11'-0"

36'-3"

11'-0"

Asphalt

344

345

346

135'

160'

133'-9"

160'

N. 1° 10' W.

ANDOVER AVENUE 50'

N. 1° 10' W.

70'

6'-2"

6'-3"

6'-5"

11'-4"

16'


16'-2"

20'-1"

16'-1"

20'-1"

65'

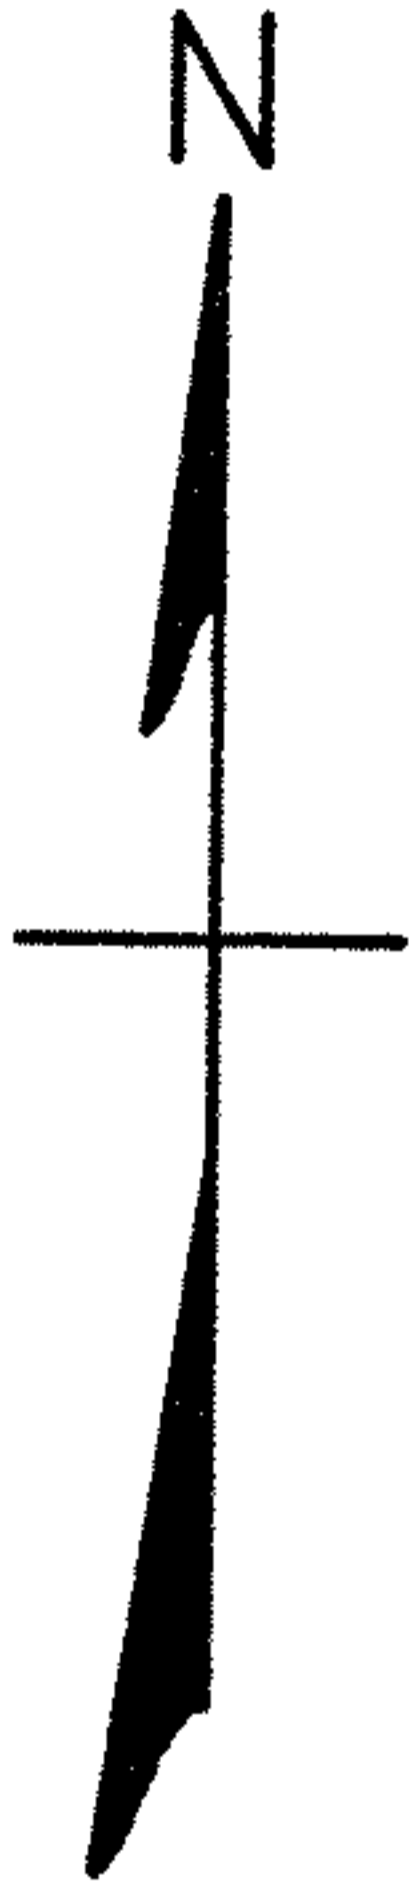

MAP OF SUB-LOT NO. 345

HOMWOOD ADDITION Vol. 14 Pgs. 22 & 23

ORIG. LOT NO. 79 SHEFFIELD TOWNSHIP

LORAIN CITY LORAIN COUNTY OHIO

SCALE: 1"=30' NOV. 29-1969 11:15 A.M.

NOTE: The only encroachment is of Asphalt Drive onto Sub-Lot 344.

Gary E. Penfound REG. SURVEYOR NO. 4457

CITY TITLE Co. Order No. E-956-7

Paul M. & Dorothy F. Tusko to Norman Robert Legg & Dana L. Legg