
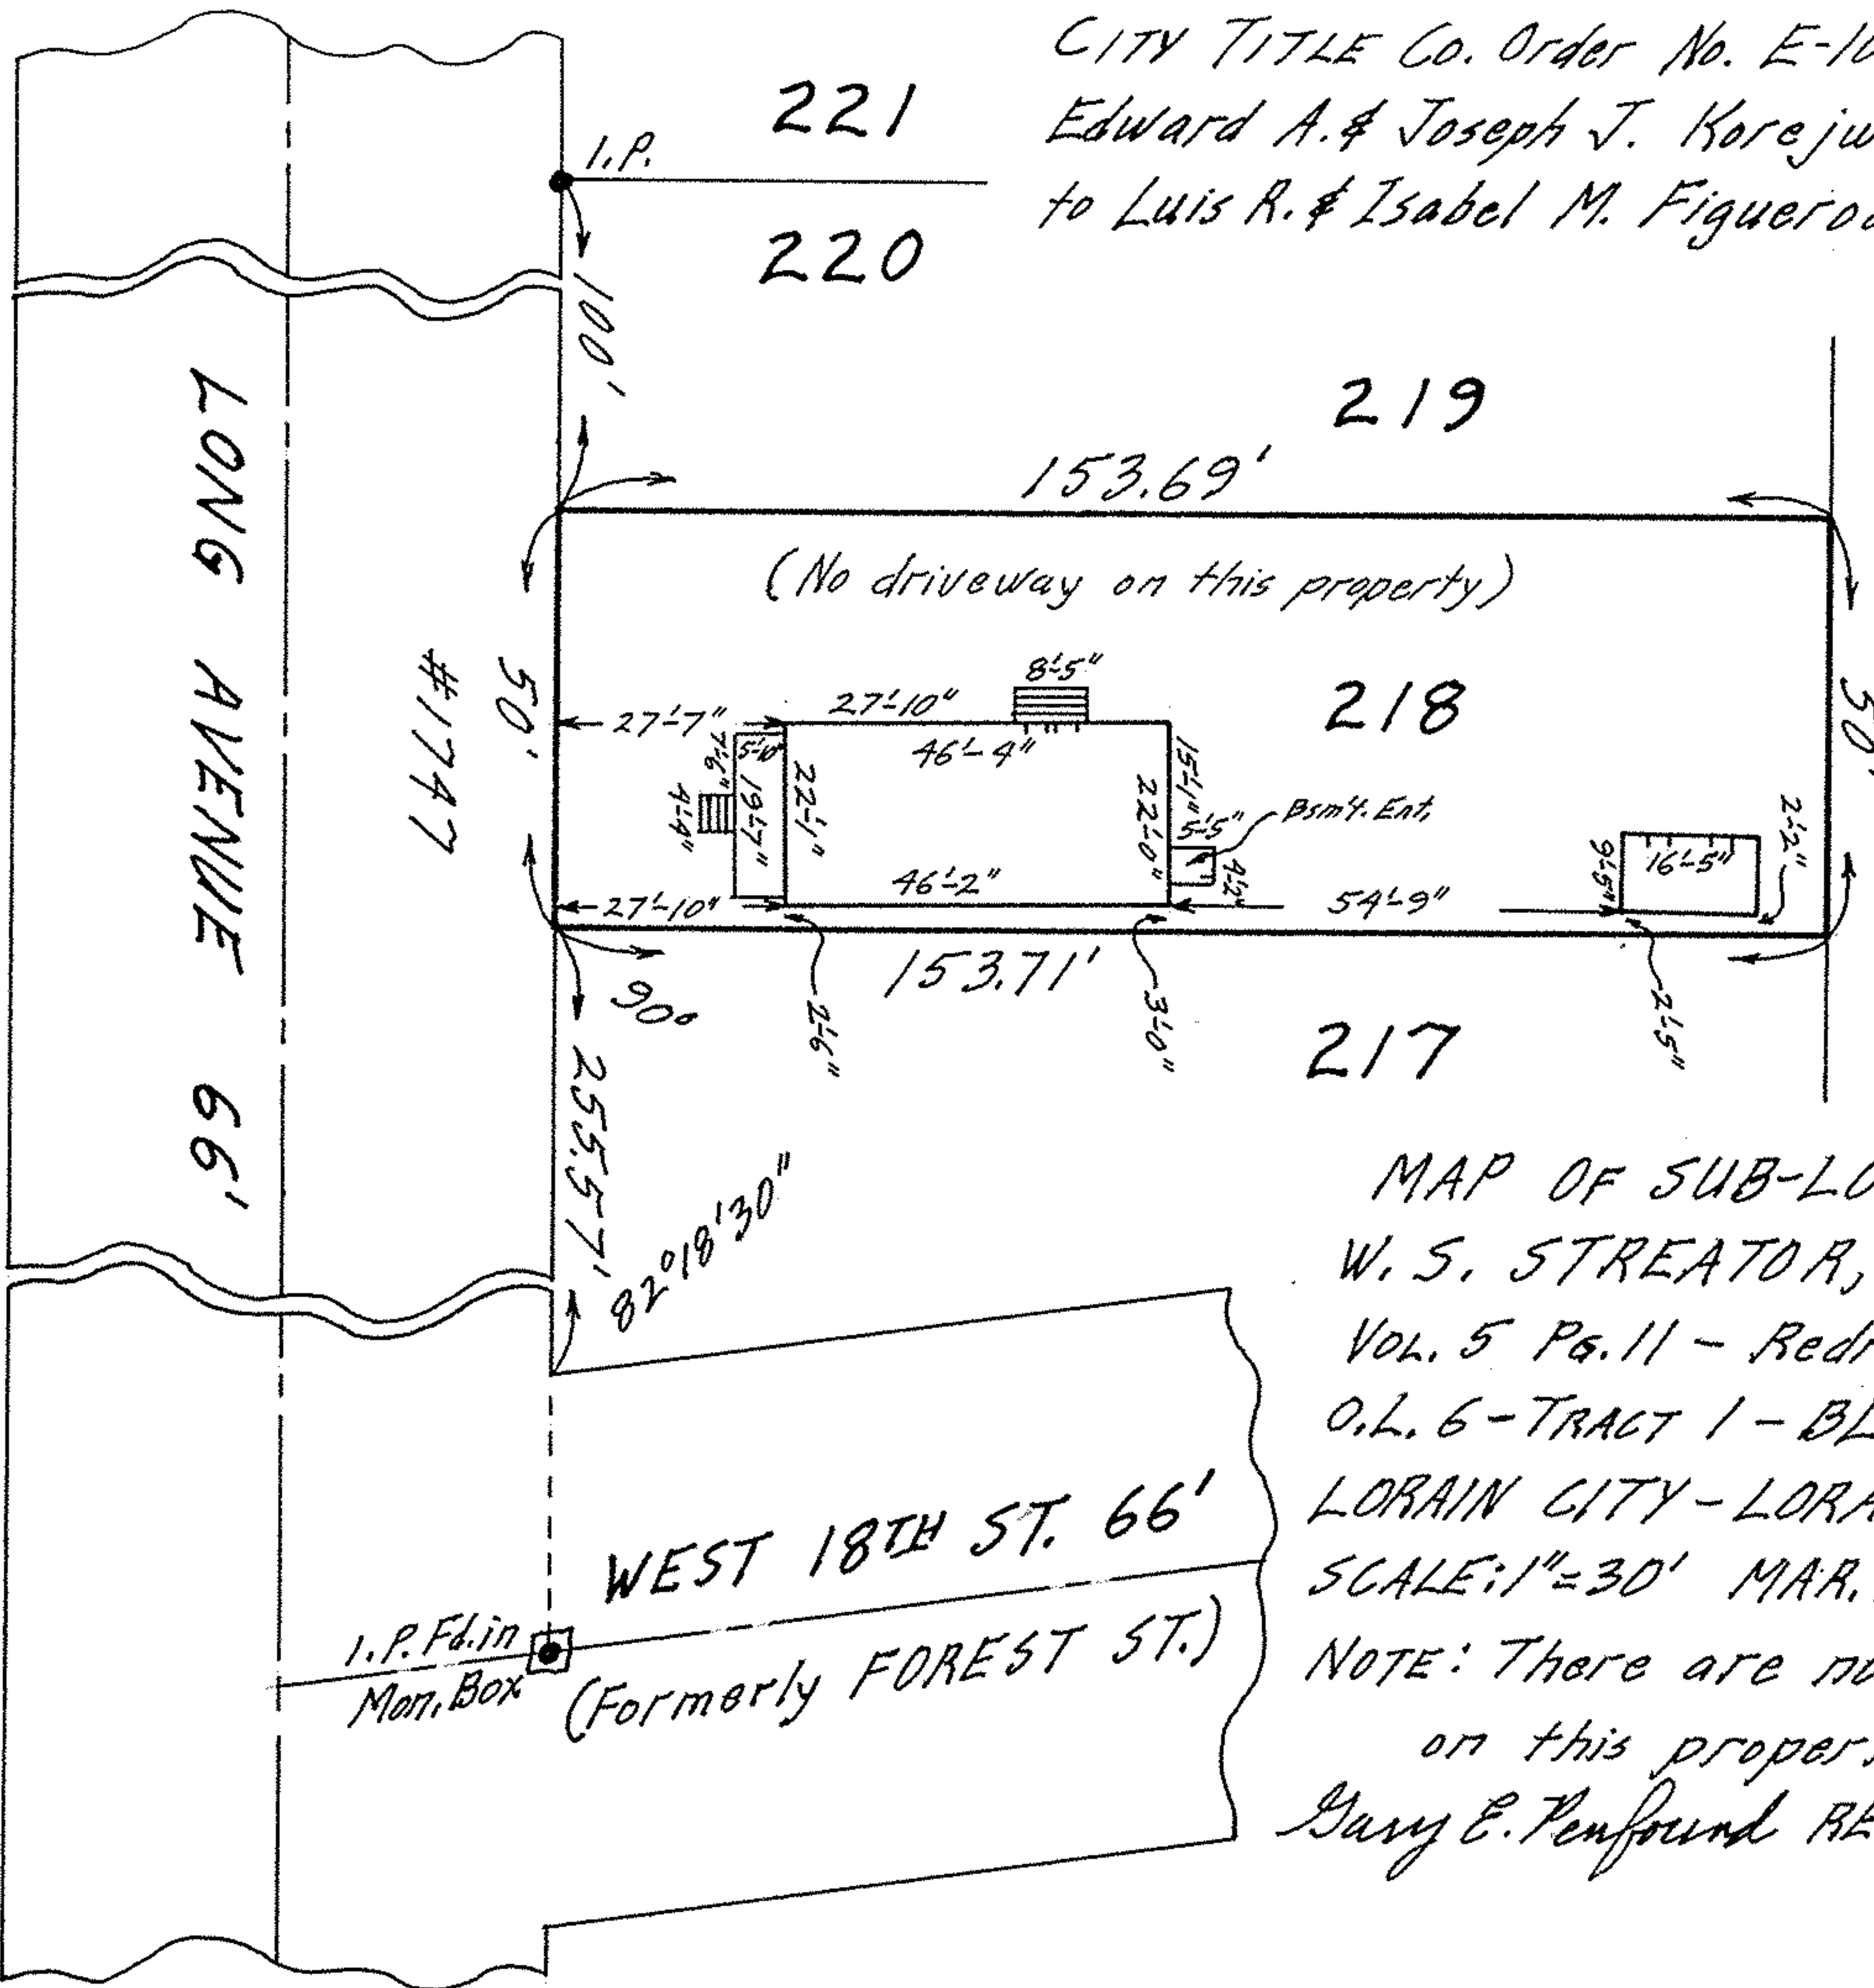


CITY TITLE Co. Order No. E-1053-4  
 Edward A. & Joseph J. Korejwo  
 to Luis R. & Isabel M. Figueroa

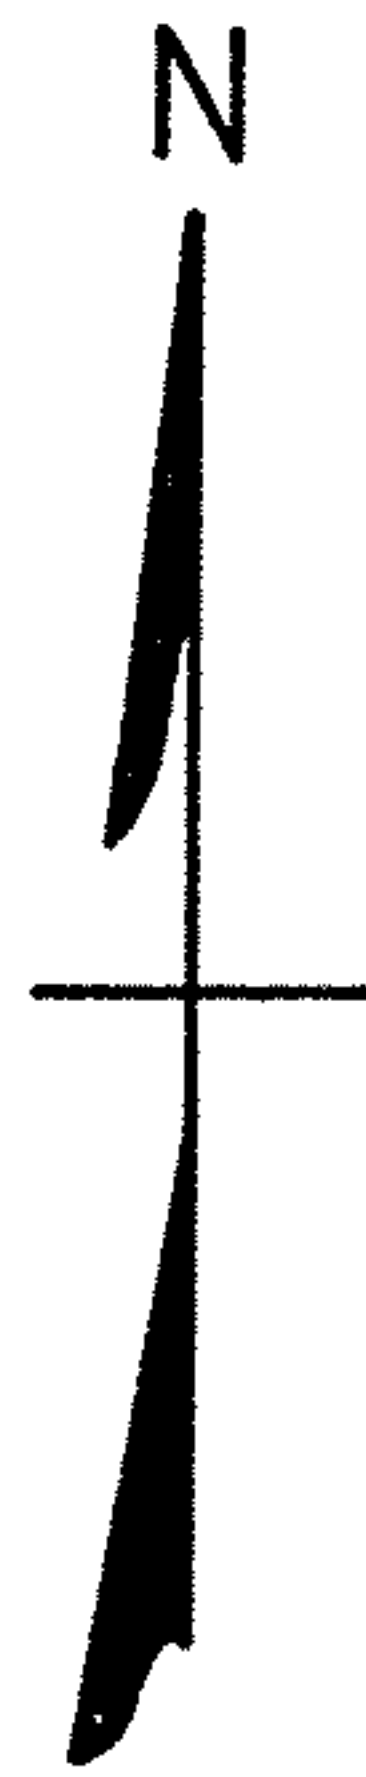

MAP OF SUB-LOT NO. 218  
 W. S. STREATOR, TR. SUB'D.  
 Vol. 5 Pg. 11 - Redrawn Vol. 15 Pg. 70  
 O.L. 6 - TRACT 1 - BLACK RIVER TWP.  
 LORAIN CITY - LORAIN COUNTY - OHIO  
 SCALE: 1" = 30' MAR. 13-1970 2:45 P.M.  
 NOTE: There are no encroachments  
 on this property.  
 Gary E. Penfound REG. SURVEYOR NO. 4457