

Alfred J. & Geneva Hedrick


I.P.

WEST 22<sup>ND</sup> STREET 66'

(Formerly EVERETT STREET)  
S. 89° 37½' E.

9000'

WASHINGTON STREET 60'

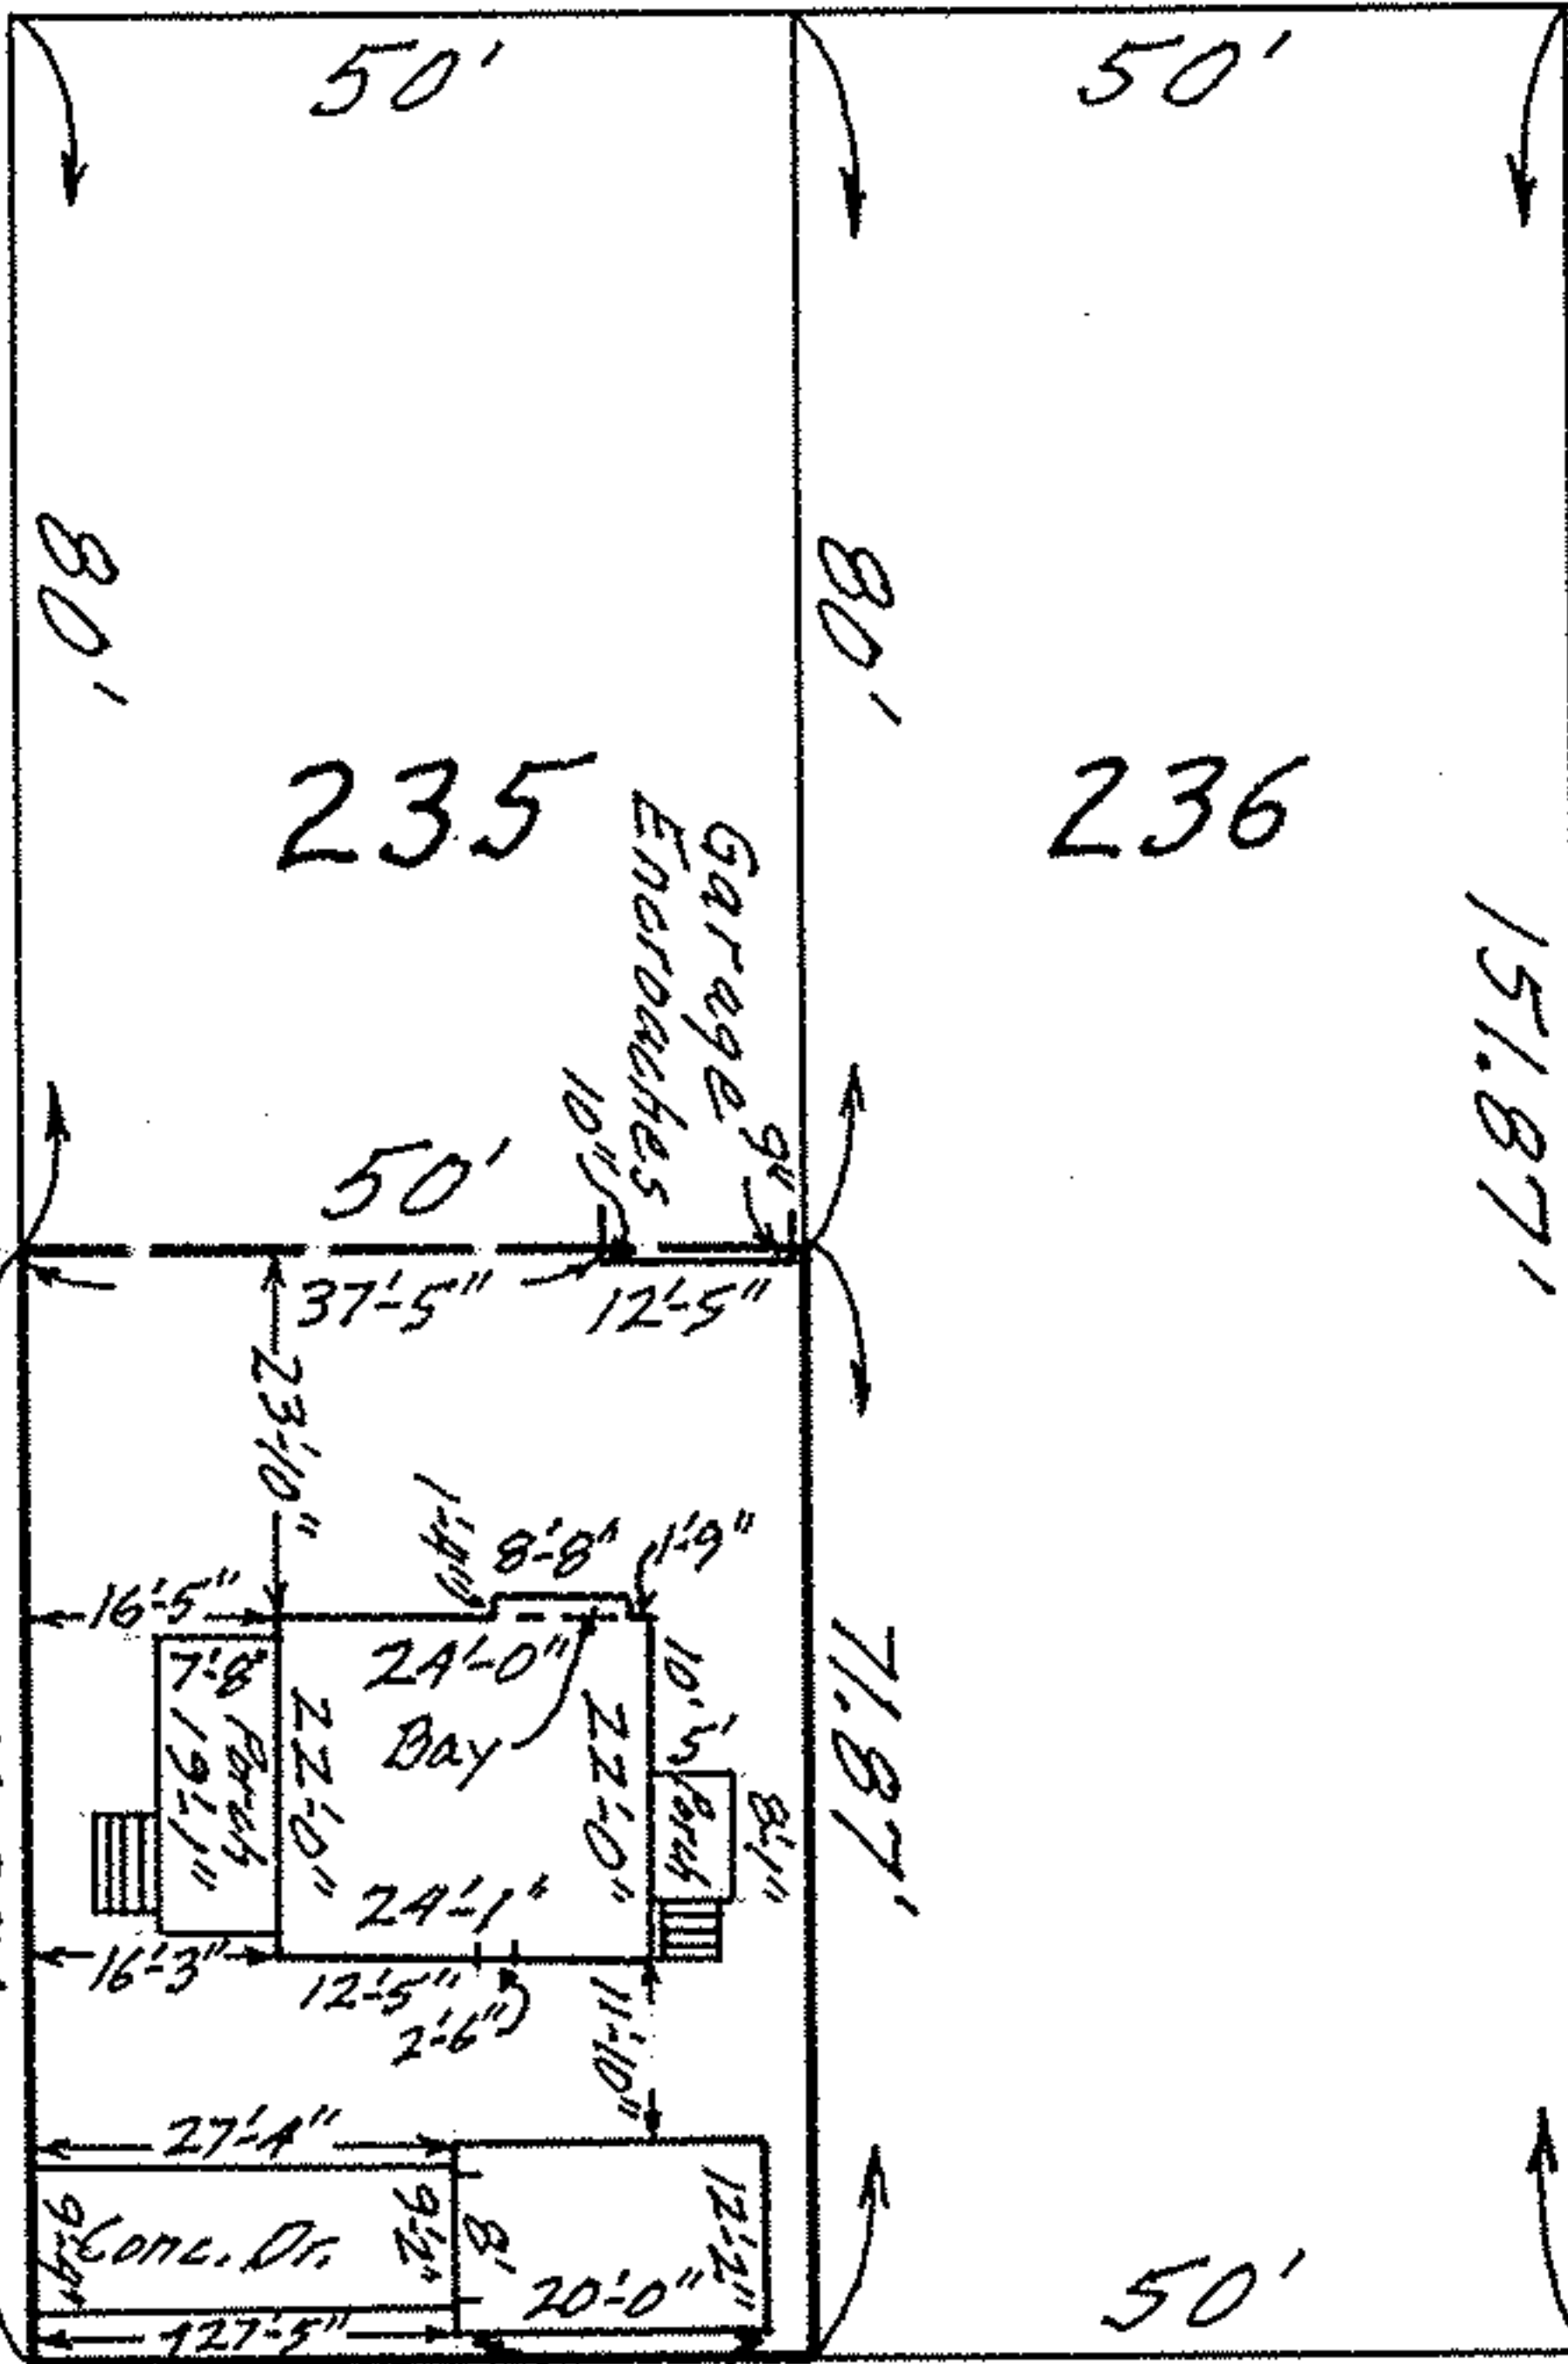

# 2223

151.87'

16' ALLEY  
Vacated Ord. #4930

MAP OF SOUTHERLY 71.87 FEET OF  
SUB-LOT NO. 235 OF STANG'S  
SECOND SUB'N. Vol. 4 Pg. 18 PLATS

LOT 6 - TRACT 1 - BLACK RIVER TWP.  
LORAIN CITY - LORAIN COUNTY - OHIO  
SCALE: 1" = 30' JUNE 26-1967 11:30 A.M.

Sam E. Penkound REG. SURVEYOR 02-01-006