


Sub-Lot 5 John E. & Margaret M. Baker

Sub-Lot 4 Edmund Grue, Jr.

Virginia Grue

Sub-Lot 3

Martin J. Rehoreq, Jr.

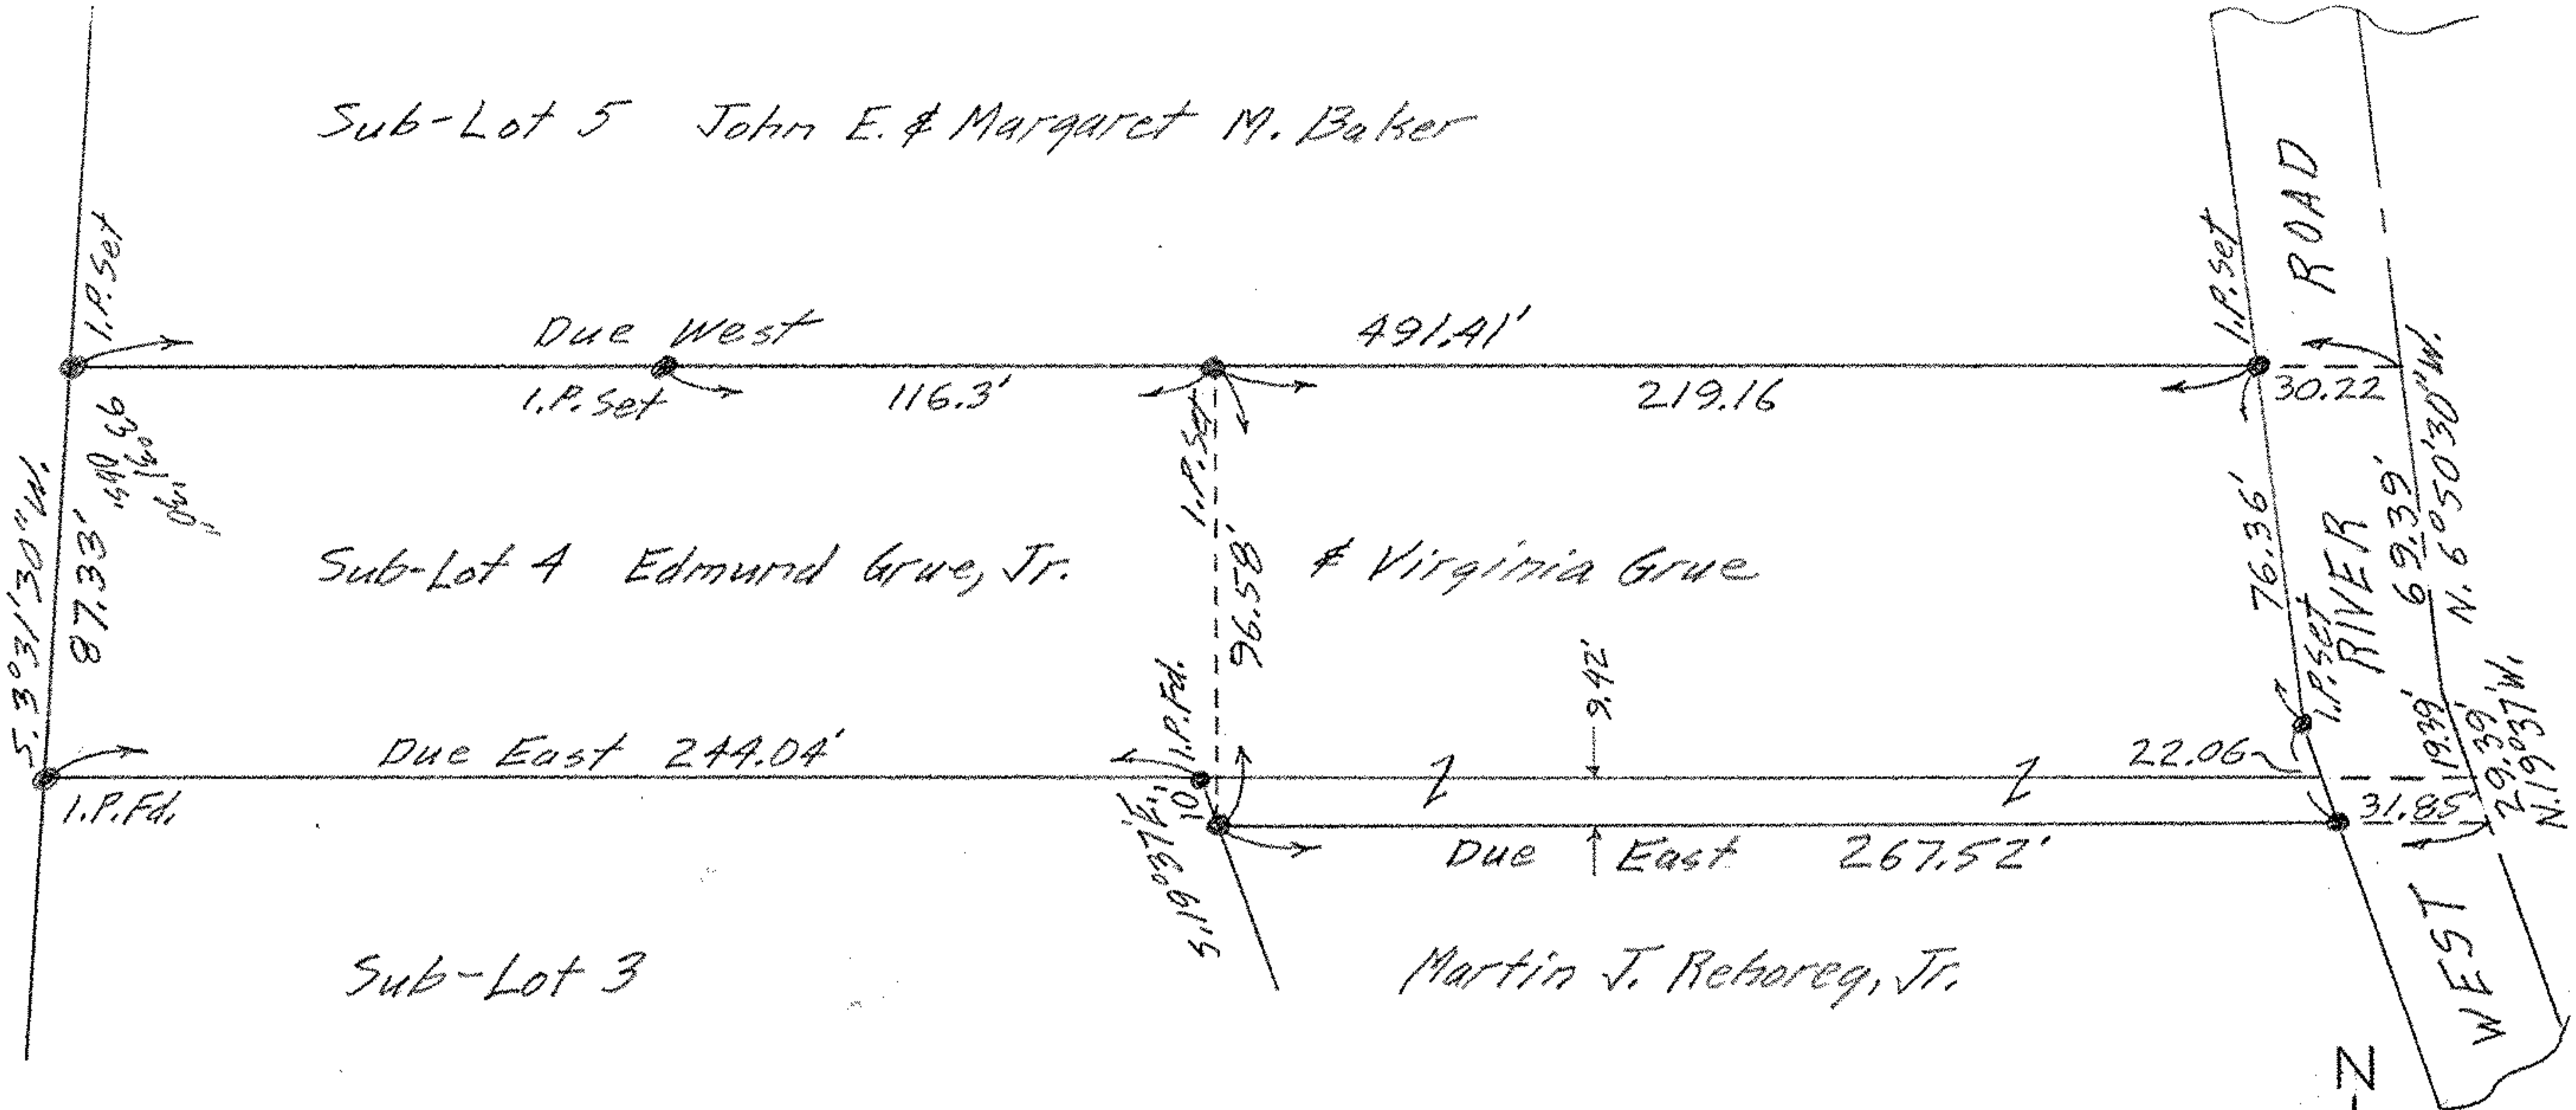

MAP OF SURVEY OF LINE BETWEEN SUB-LOTS 4 & 5
 INTERURBAN ALLOTMENT Vol. 5 Pg. 29 PLATS
 ORIGINAL LOT 12 BRACE TRACT ELYRIA TWP.
 LORAIN COUNTY OHIO
 SCALE: 1" = 50' MAY 20 - 1959
 GARY E. PENFOUND REGISTERED SURVEYOR NO. 4957

